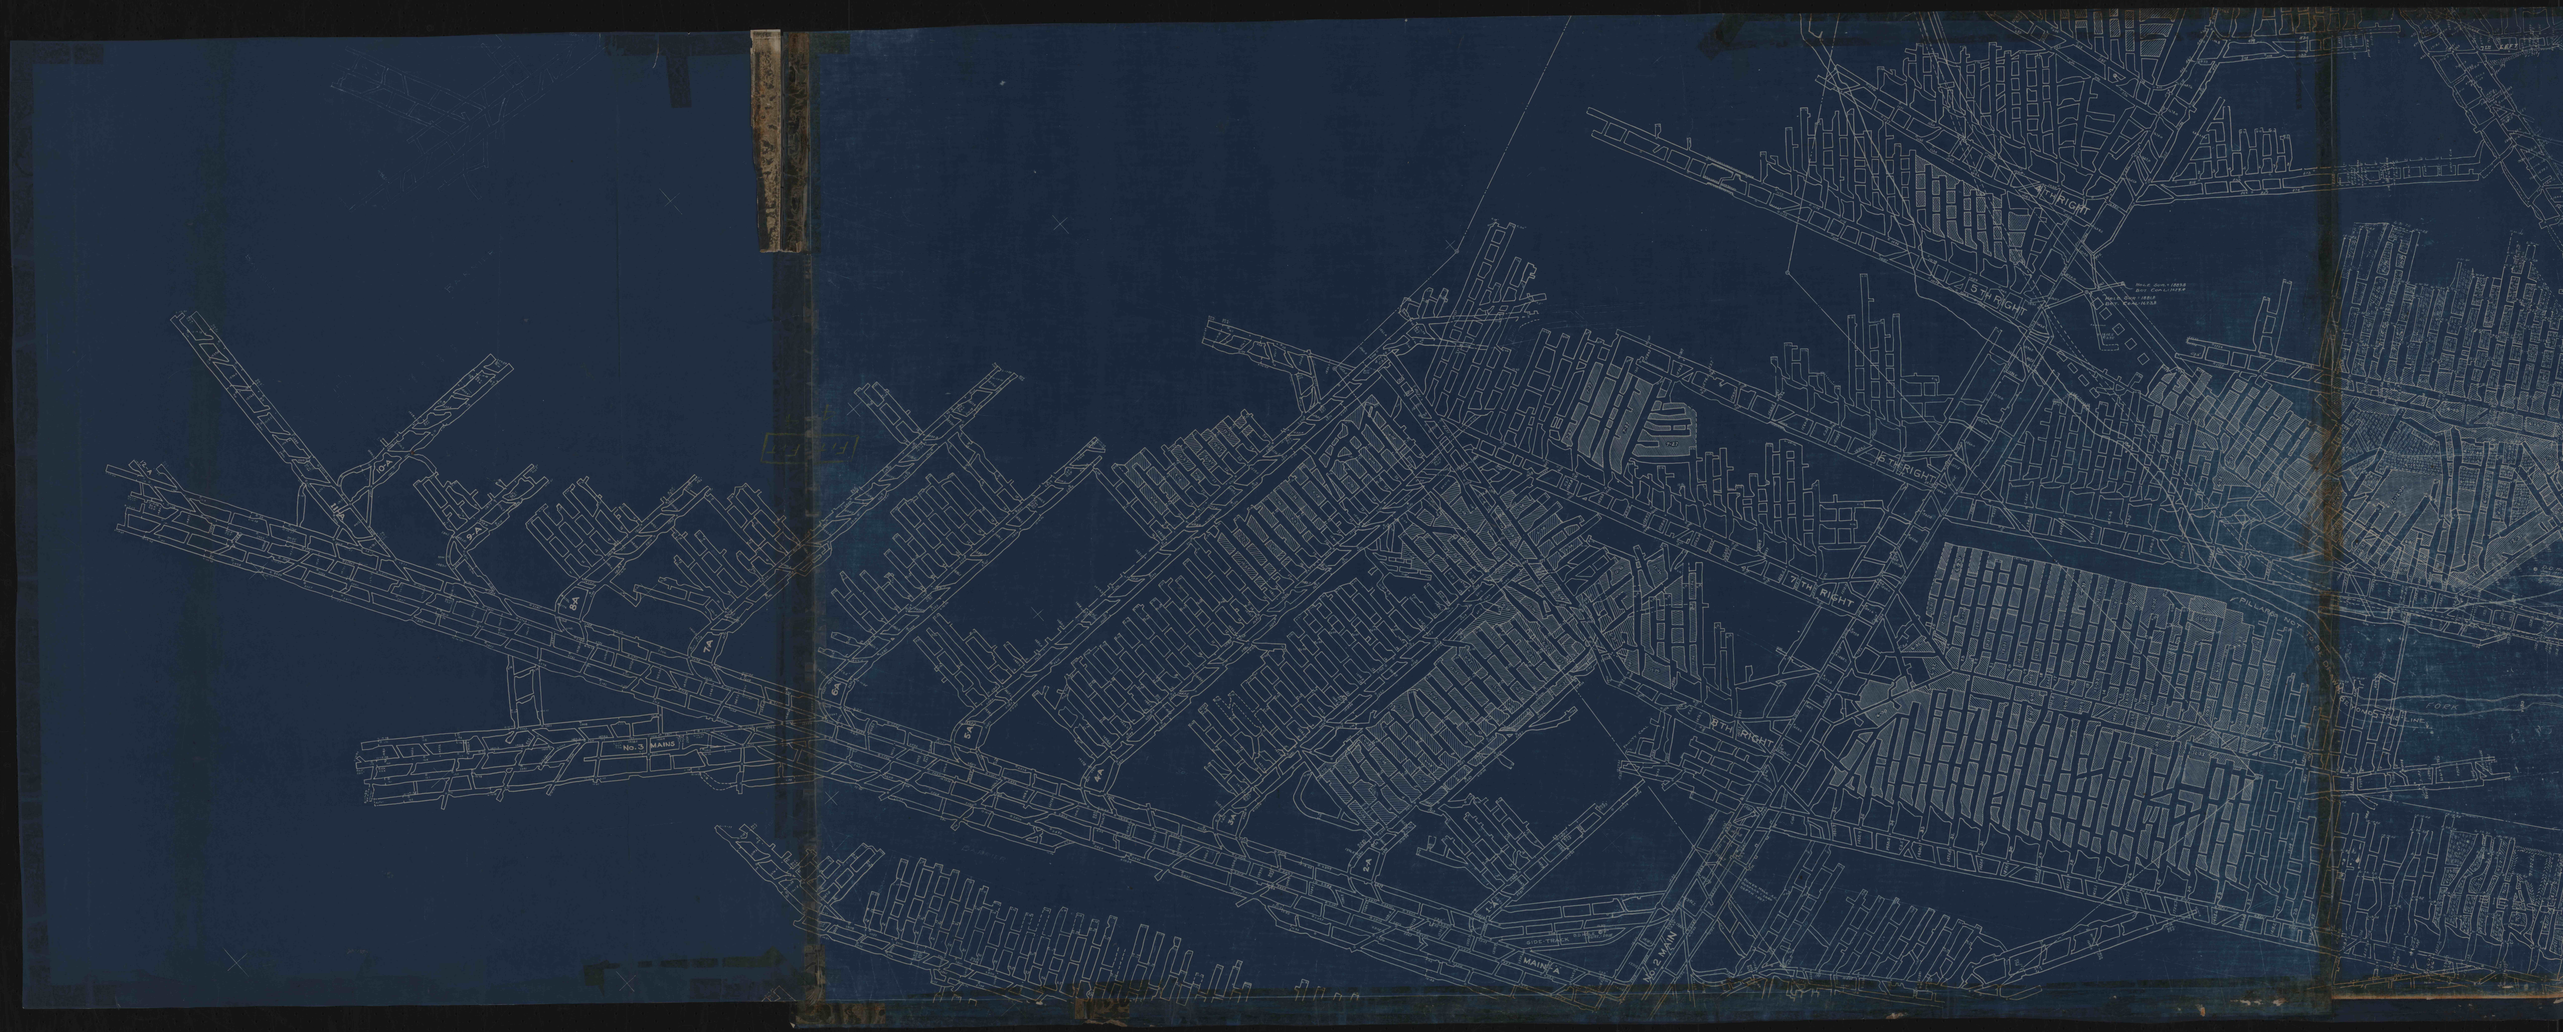
No. 3 MAINS
MAIN A
No. 2 MAIN
4TH RIGHT
5TH RIGHT
6TH RIGHT
7TH RIGHT
8TH RIGHT
9A
8A
7A
6A
5A
4A
3A
2A
1A
10A