





No 4 ST OPE
LIBRARY

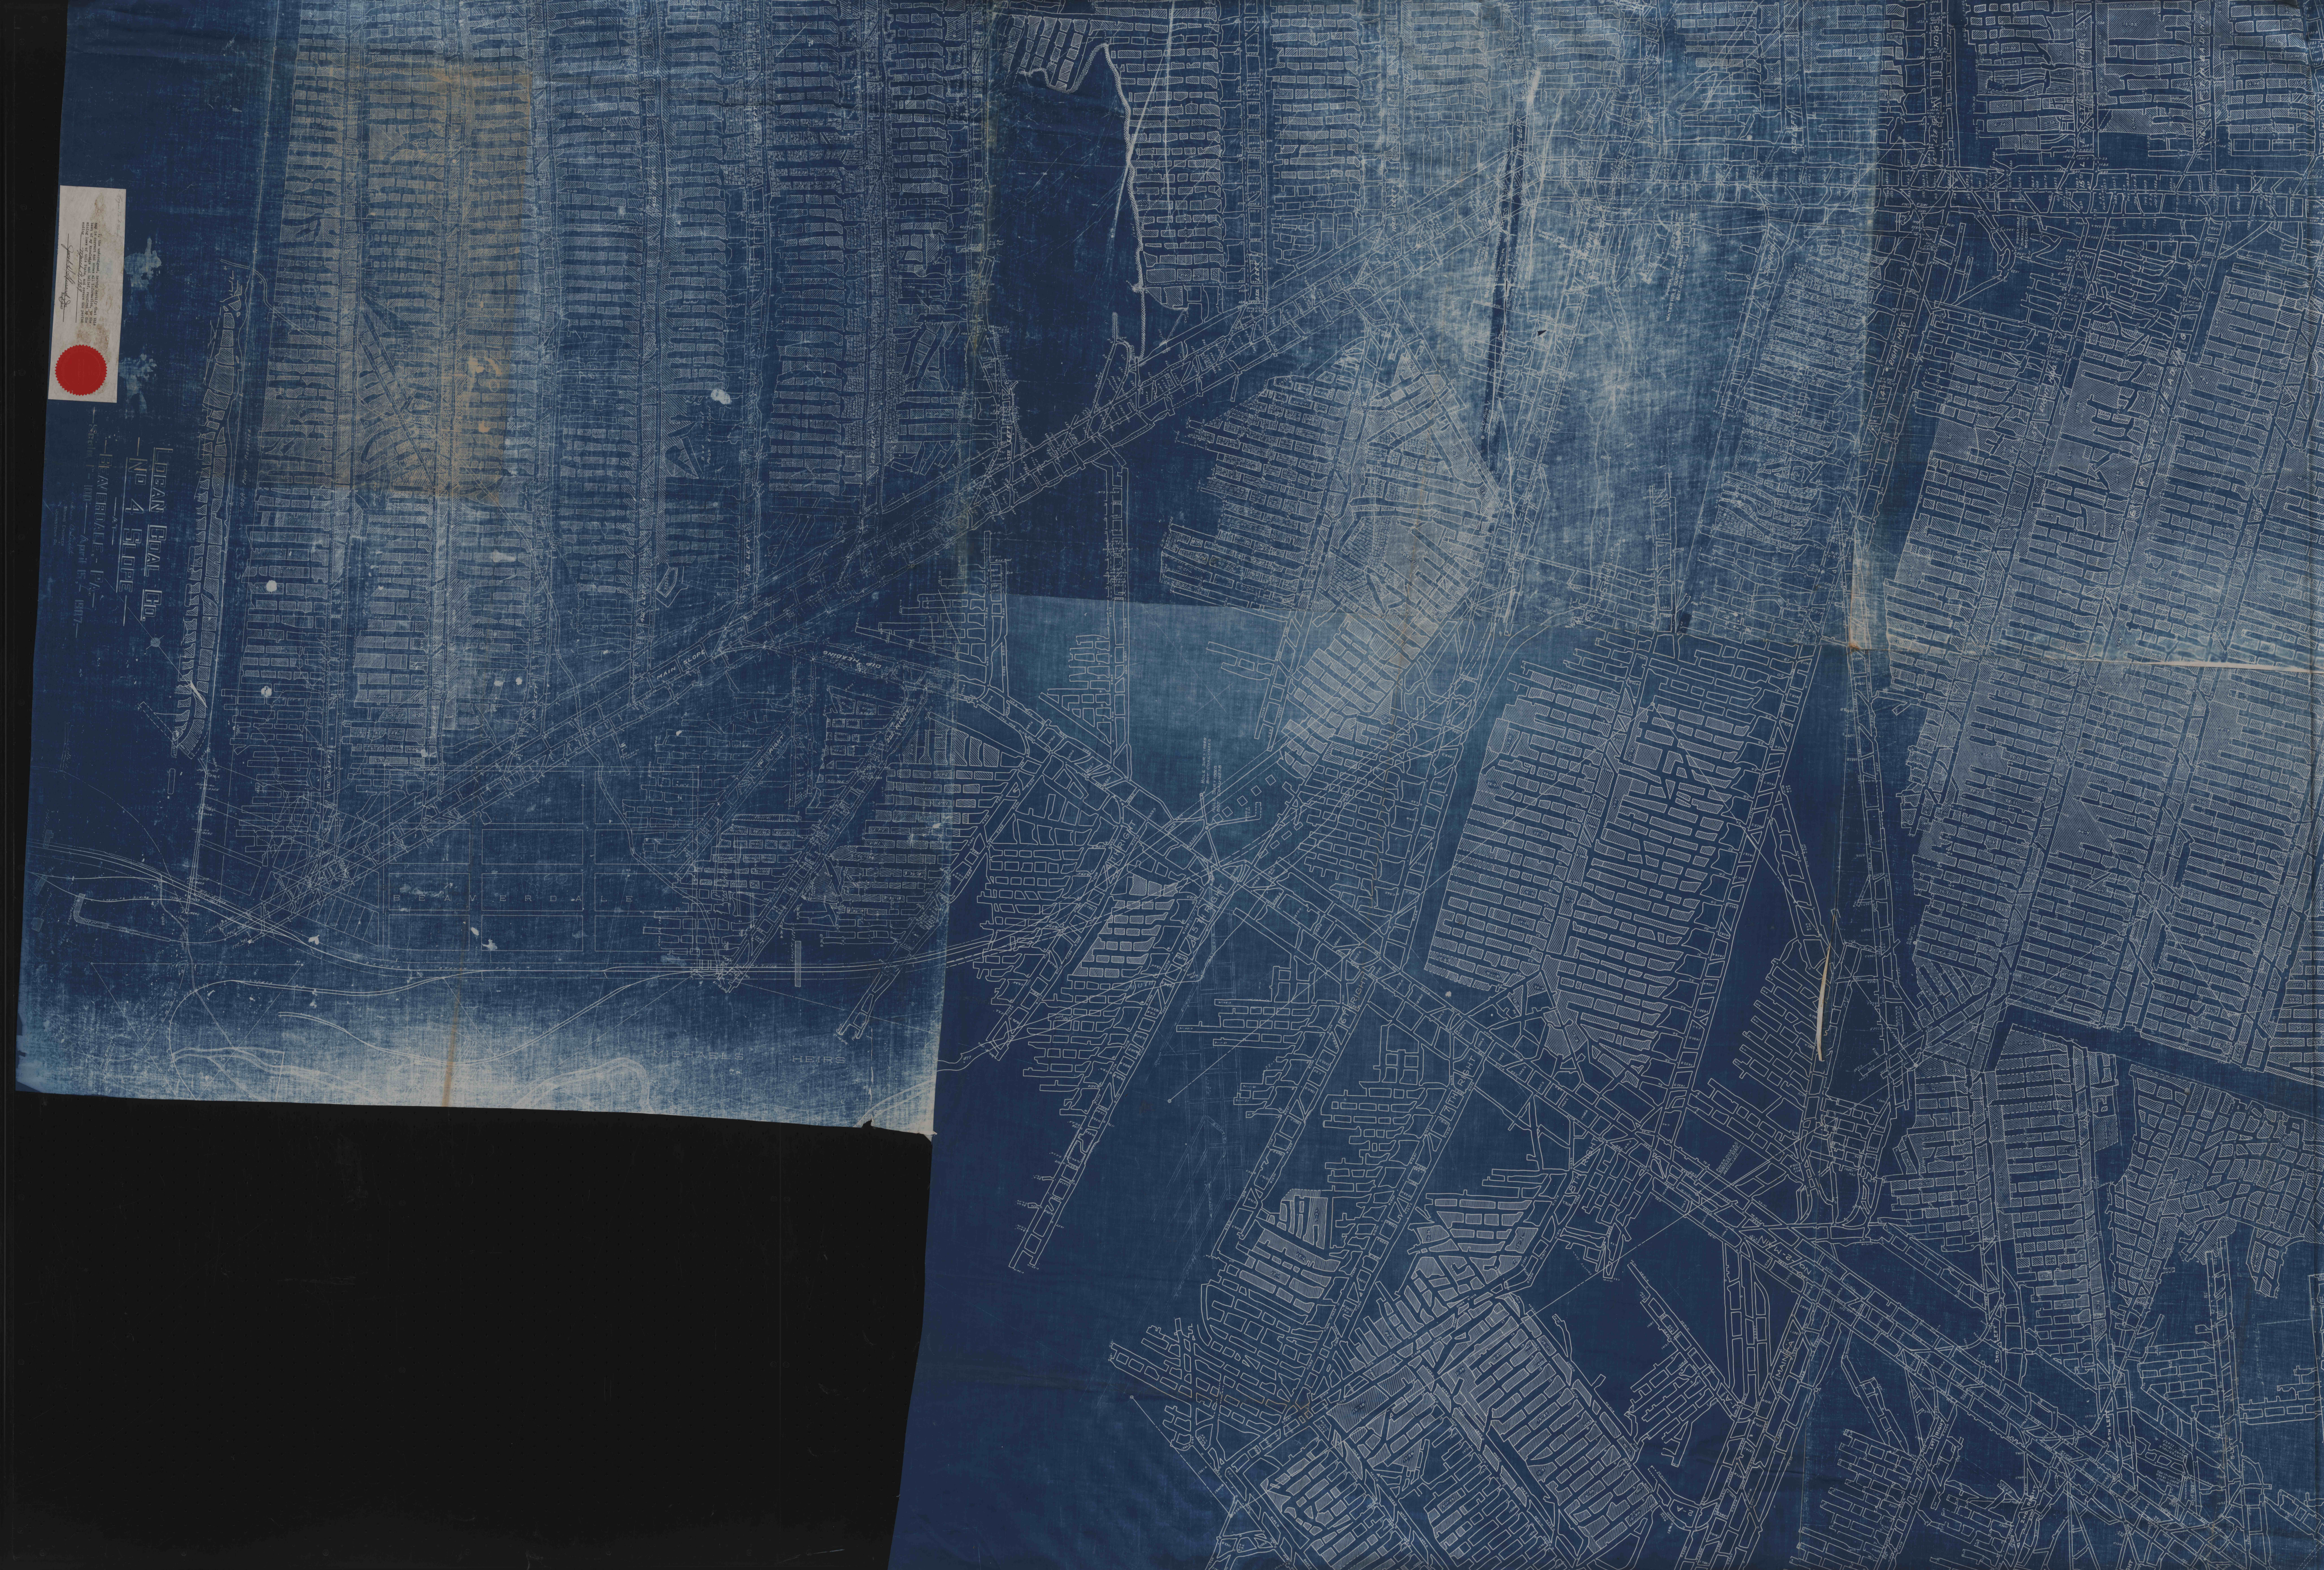

B E A V E R D A L E

C H A R L E S H E Y S

A N K L E S T O N