



JOHNSTOWN COAL & COKE Co
No. 3 MINE-E-SEAM

NEAR
SCALE: 1" = 100'

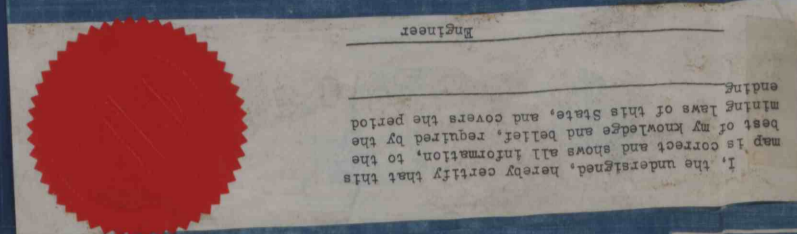


LOGAN COAL CO
MAP OF
E, SEAM MINE WORKINGS
NO. 3 MINE

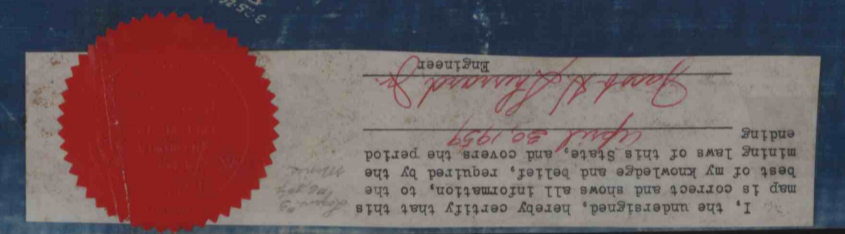

