
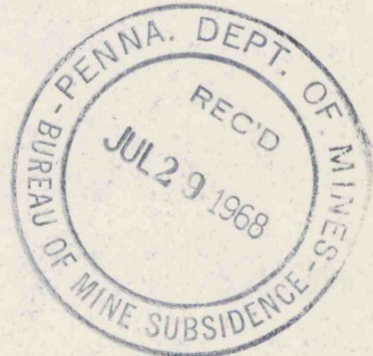
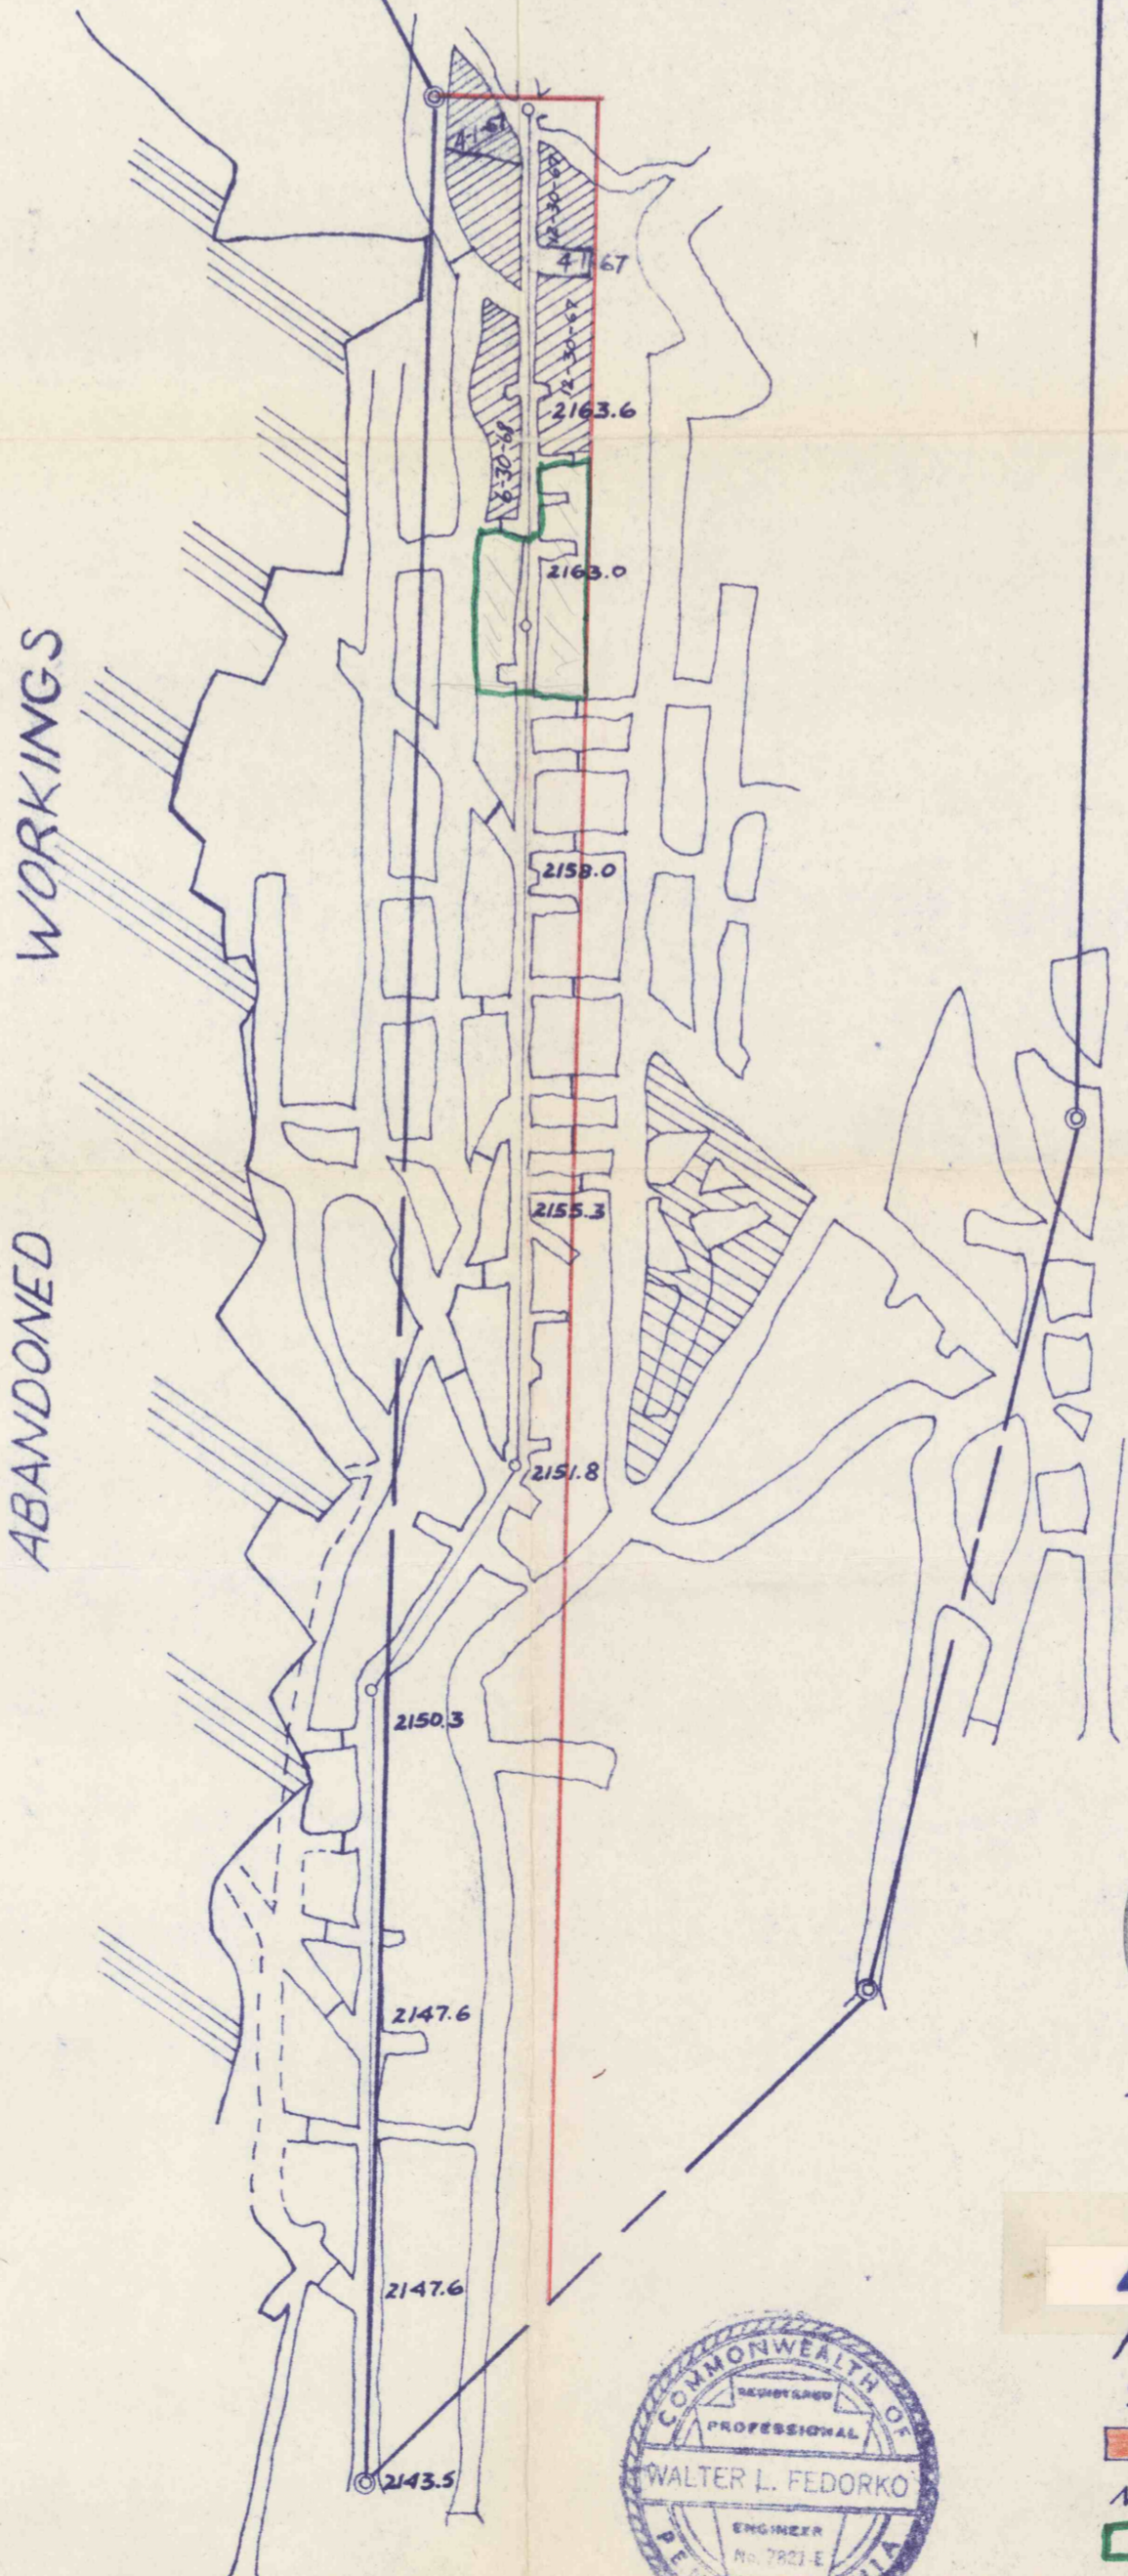


Lonley Coal Co.
Portage Twp.
Cambria Co.
Map Section #4

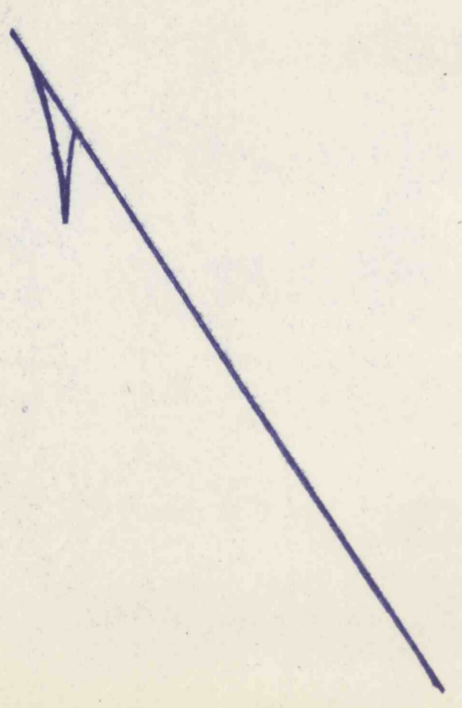

FIELD COPY

LONLEY COAL CO.
PORTAGE, TWP. CAMBRIA CO.

SCALE: 1" = 100' SEPT. 1966

AREA BEING MINED

NOTE - ELEV'S. ARE ON BOTTOM

AREA TO BE MINED 8-68 - 2-69

W.L. FEDORKO R.P.E.



As shown on page 2

670 1230