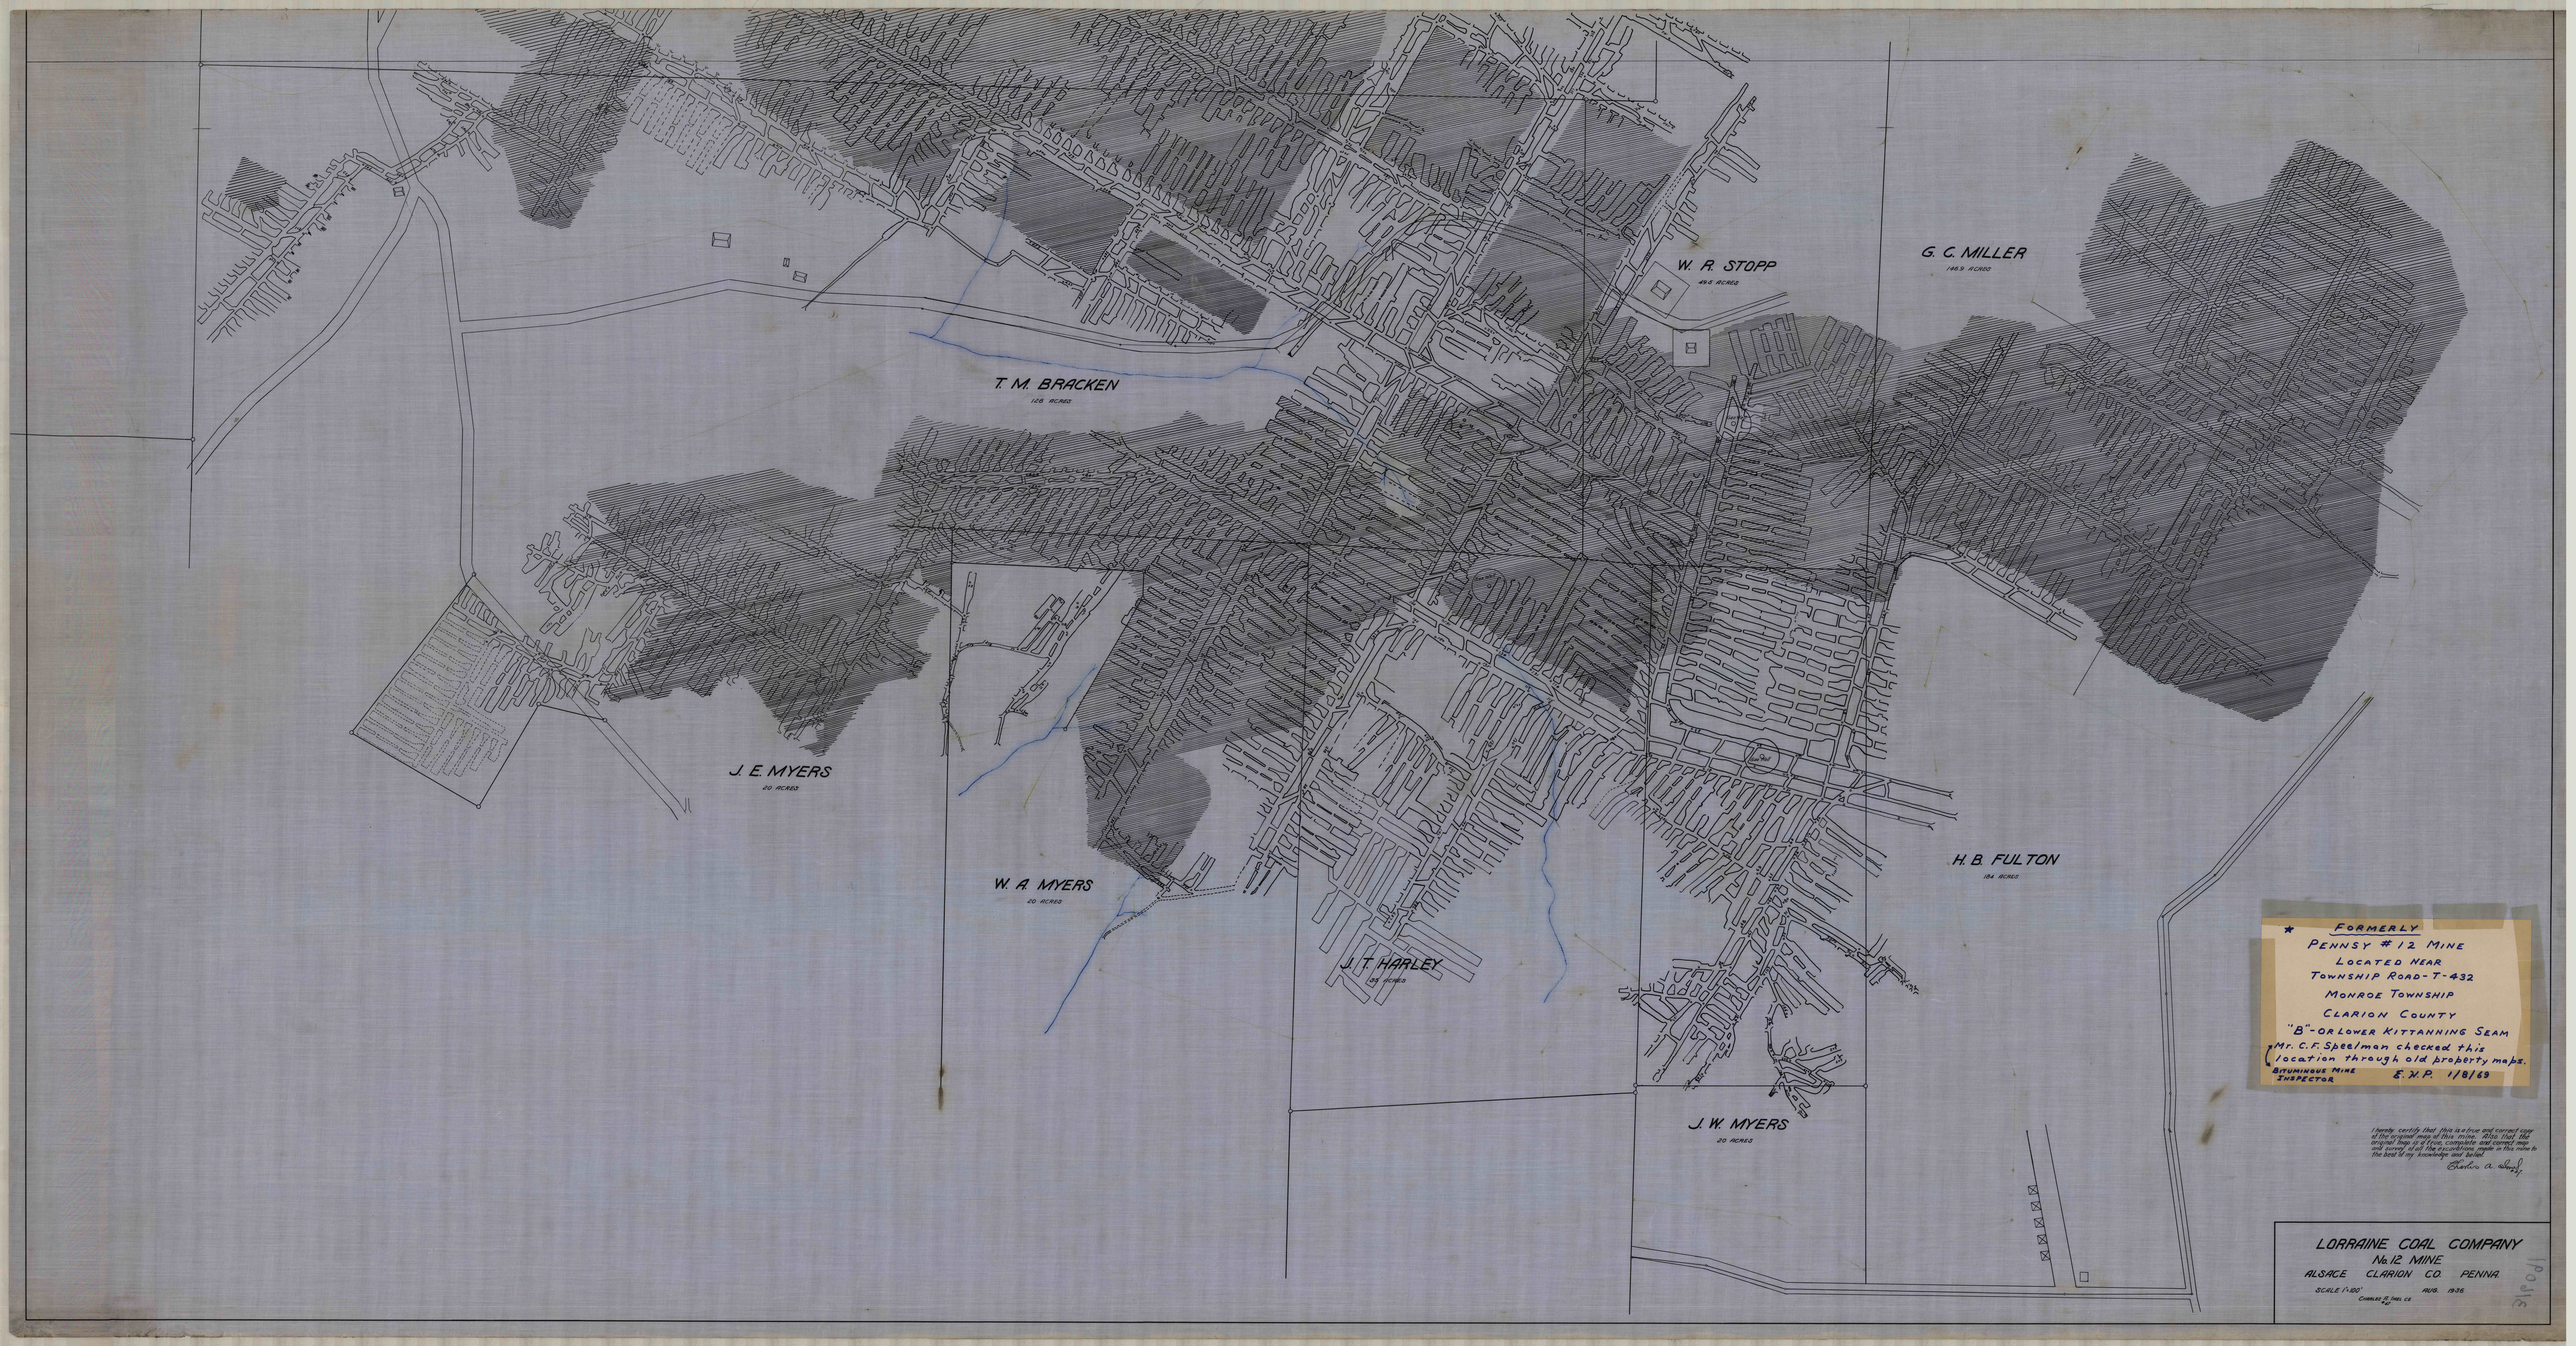

W. R. STOPP
49.8 ACRES
G. C. MILLER
146.9 ACRES
T. M. BRACKEN
126 ACRES
J. E. MYERS
20 ACRES
W. A. MYERS
20 ACRES
J. T. HARLEY
20 ACRES
H. B. FULTON
184 ACRES
J. W. MYERS
20 ACRES
* FORMERLY
PENNSY #12 MINE
LOCATED NEAR
TOWNSHIP ROAD - T-432
MONROE TOWNSHIP
CLARION COUNTY
"B" OR LOWER KITTANNING SEAM
Mr. C. F. Speelman checked this location through old property maps.
BITUMINOUS MINE INSPECTOR E.X.P. 1/8/63
I hereby certify that this is a true and correct copy of the original map of this mine. Also that the original map is a true, complete and correct map and survey of all the excavations made in this mine to the best of my knowledge and belief.
Charles A. Sheaf
LORRAINE COAL COMPANY
No. 12 MINE
ALSACE CLARION CO. PENNA.
SCALE 1-100'
CHARLES E. SHEAF CO.
AUG. 1936