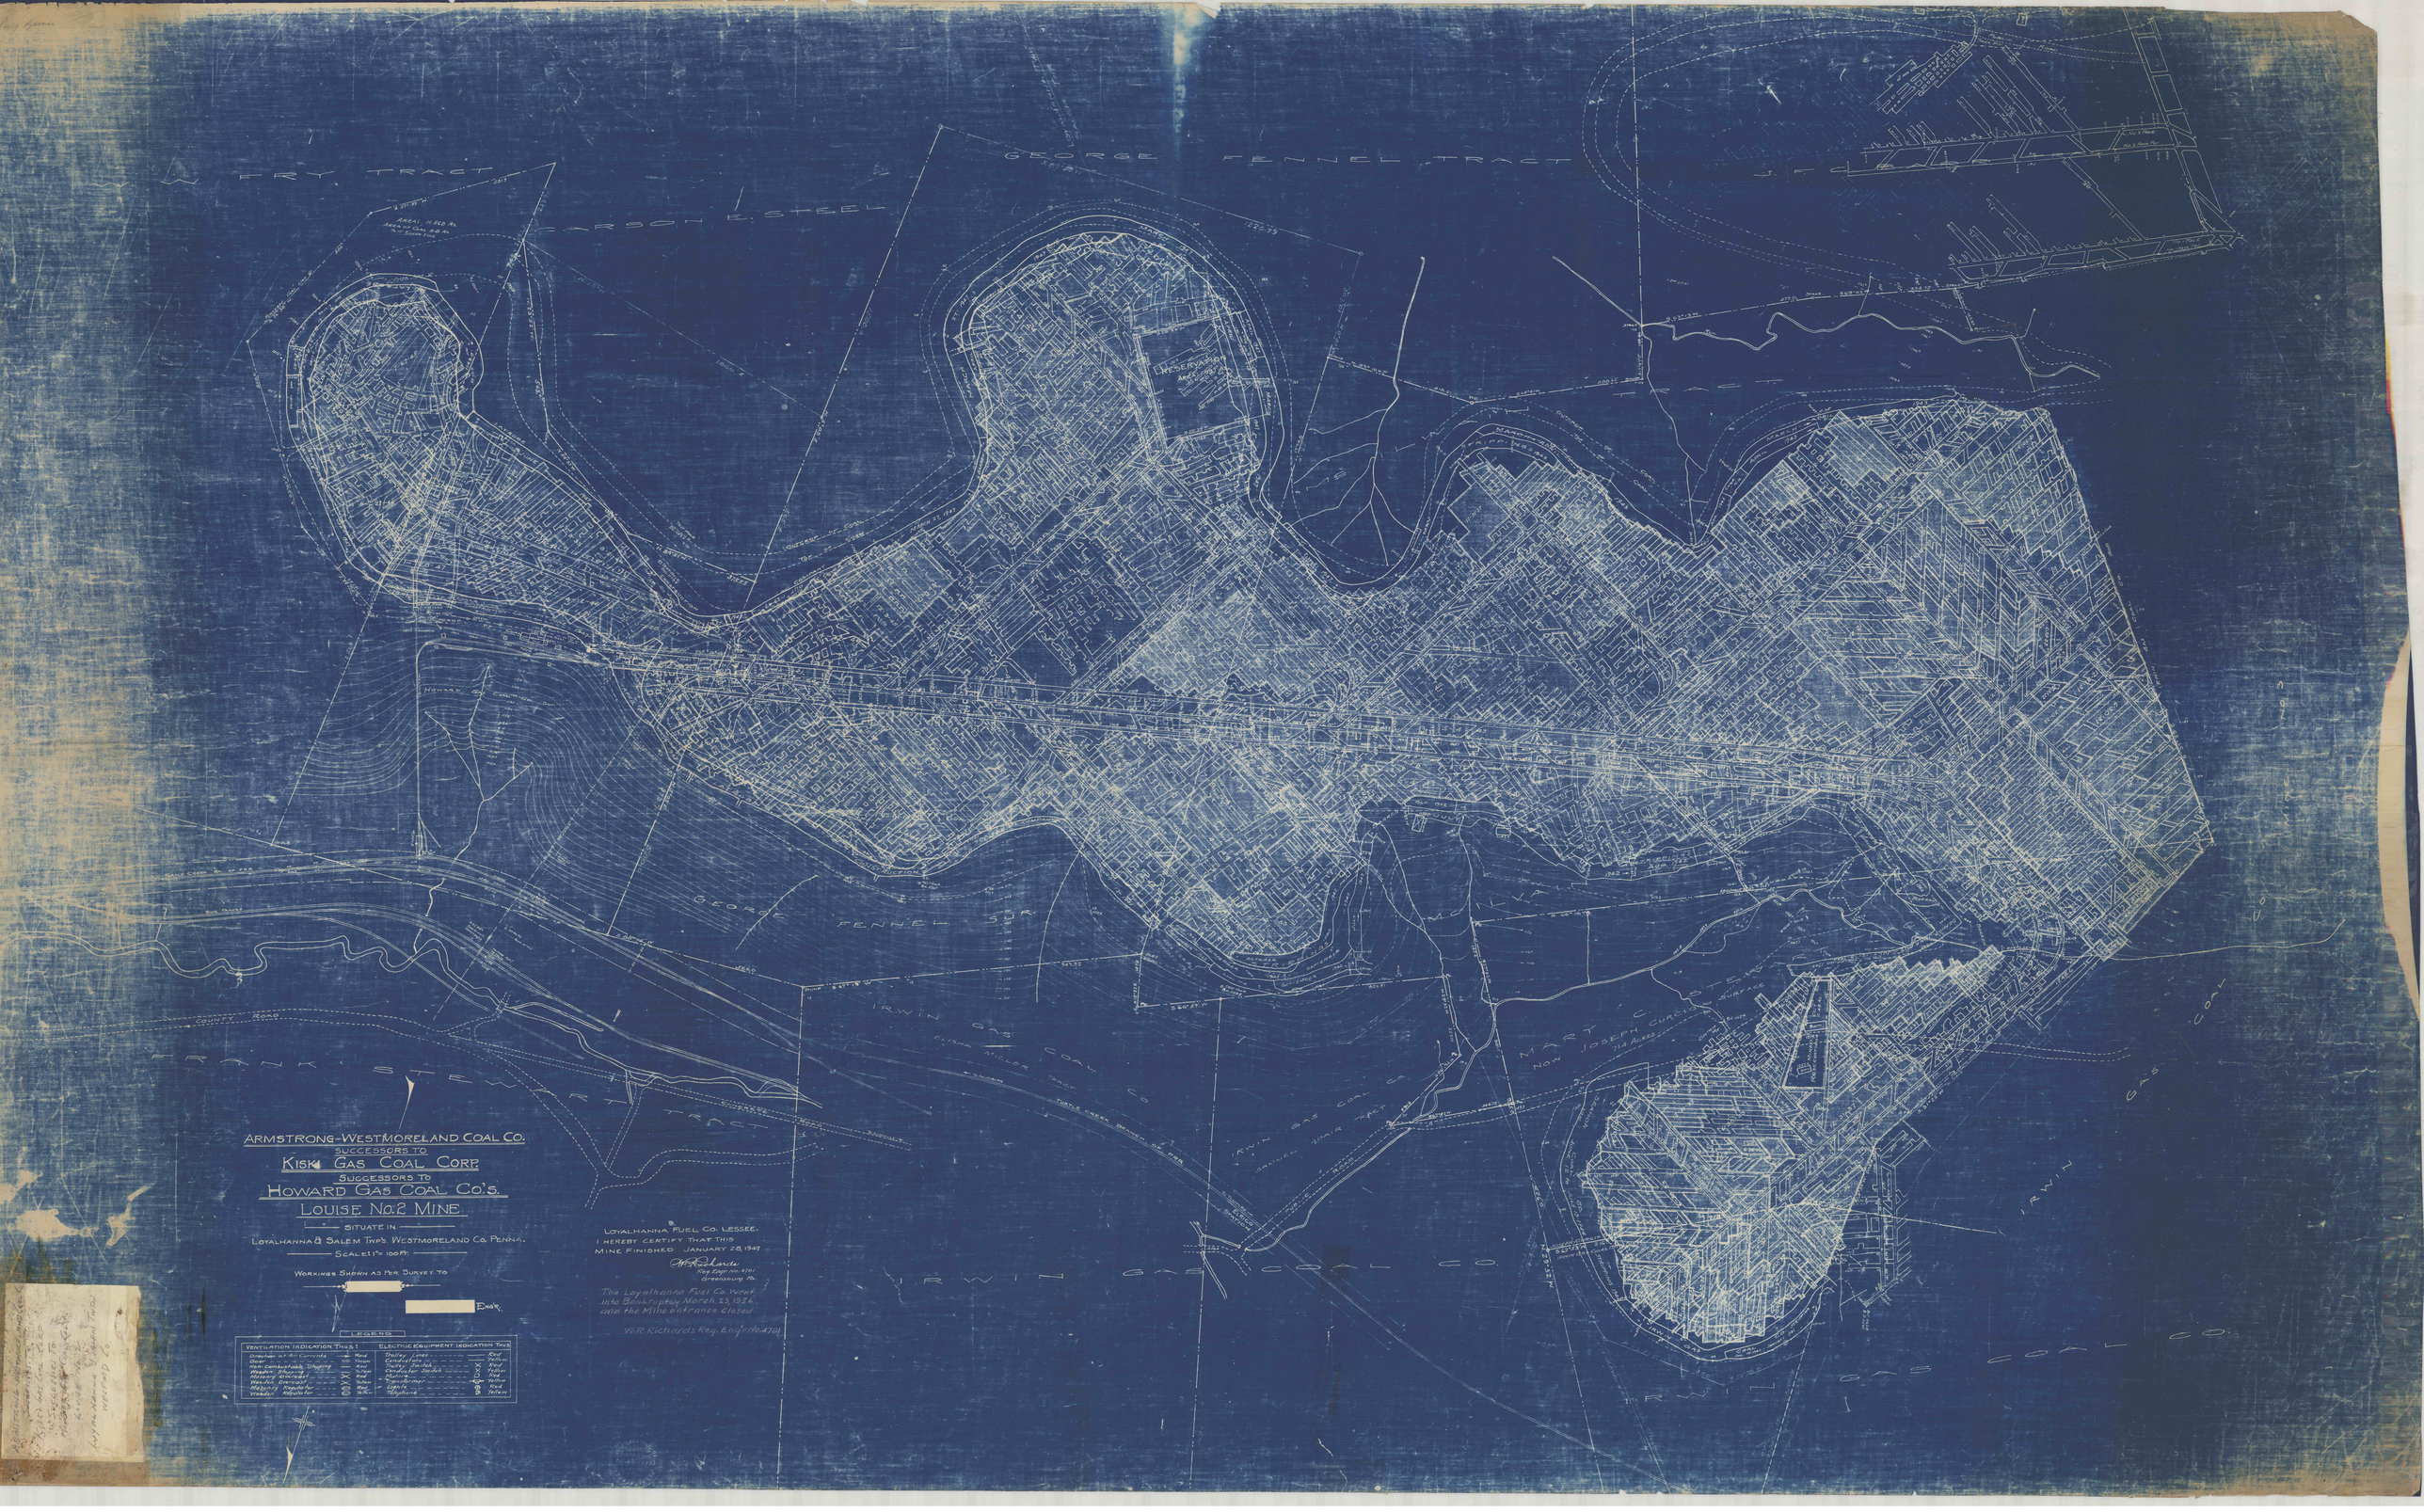

FRY TRACT
CARSON E. STEEL
GEORGE FENNEL TRACT
GEORGE FENNEL SUR.
IRWIN GAS COAL CO.
FRANK STEWART TRACT
MARY C. STEWART
NOW JOSEPH CURCIO
IRWIN GAS COAL CO.
ARMSTRONG-WESTMORELAND COAL CO.
SUCCESSORS TO
KISKI GAS COAL CORP.
SUCCESSORS TO
HOWARD GAS COAL CO'S.
LOUISE No. 2 MINE
SITUATE IN
LOYALHANNA & SALEM TWP'S. WESTMORELAND CO. PENNA.
SCALE: 1" = 100 FT.
WORKINGS SHOWN AS PER SURVEY TO
ENG'R.
LEGEND
VENTILATION INDICATION THUS:
Direction of Air Currents — Red
Door — Yellow
Non-Combustible Stopping — Red
Wooden Stopping — Yellow
Mineral Overcast — Red
Wooden Overcast — Yellow
Mineral Regulator — Red
Wooden Regulator — Yellow
ELECTRIC EQUIPMENT INDICATION THUS:
Trolley Lines — Red
Conductors — Yellow
Trolley Switch — Red
Conductor Switch — Yellow
Motor — Red
Transformer — Yellow
Lights — Red
Telephone — Yellow
LOYALHANNA FUEL CO. LESSEE.
I HEREBY CERTIFY THAT THIS
MINE FINISHED JANUARY 28, 1947
W. R. Richards
Reg. Engr. No. 4781
Greensburg, Pa.
The Loyalhanna Fuel Co. went into Bankruptcy March 23, 1956 and the Mine entrance closed
W. R. Richards Reg. Eng'r No. 4781