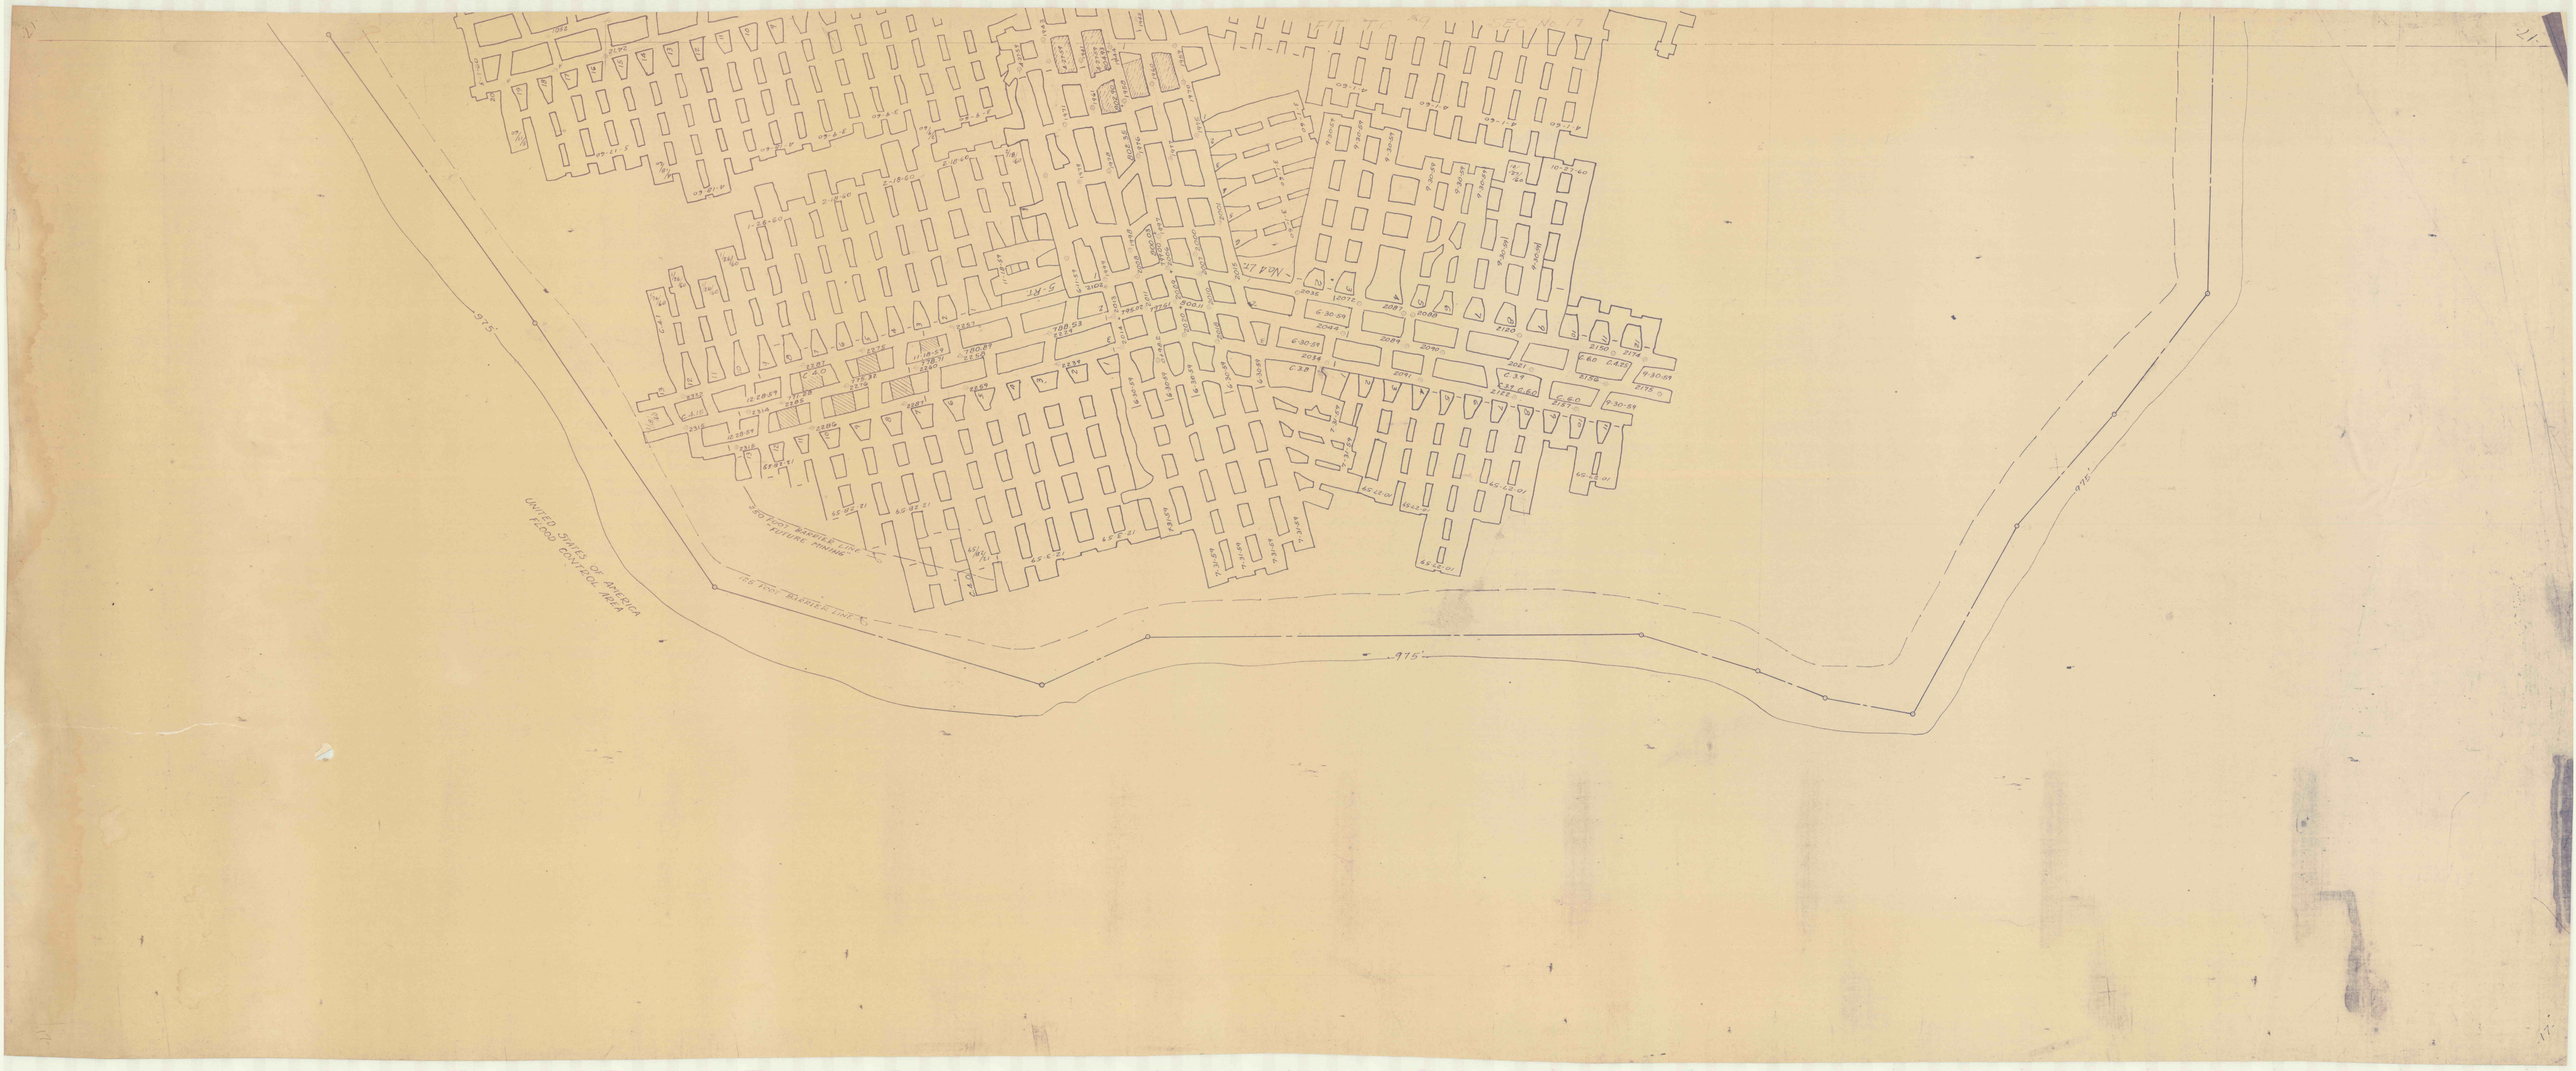
975'
975'
975'
UNITED STATES OF AMERICA
FLOOD CONTROL AREA
