



GAS WELL
○
ACTIVE

SEC. 8
FIT SECTION 7

SECTION 8
FIT SECTION 6

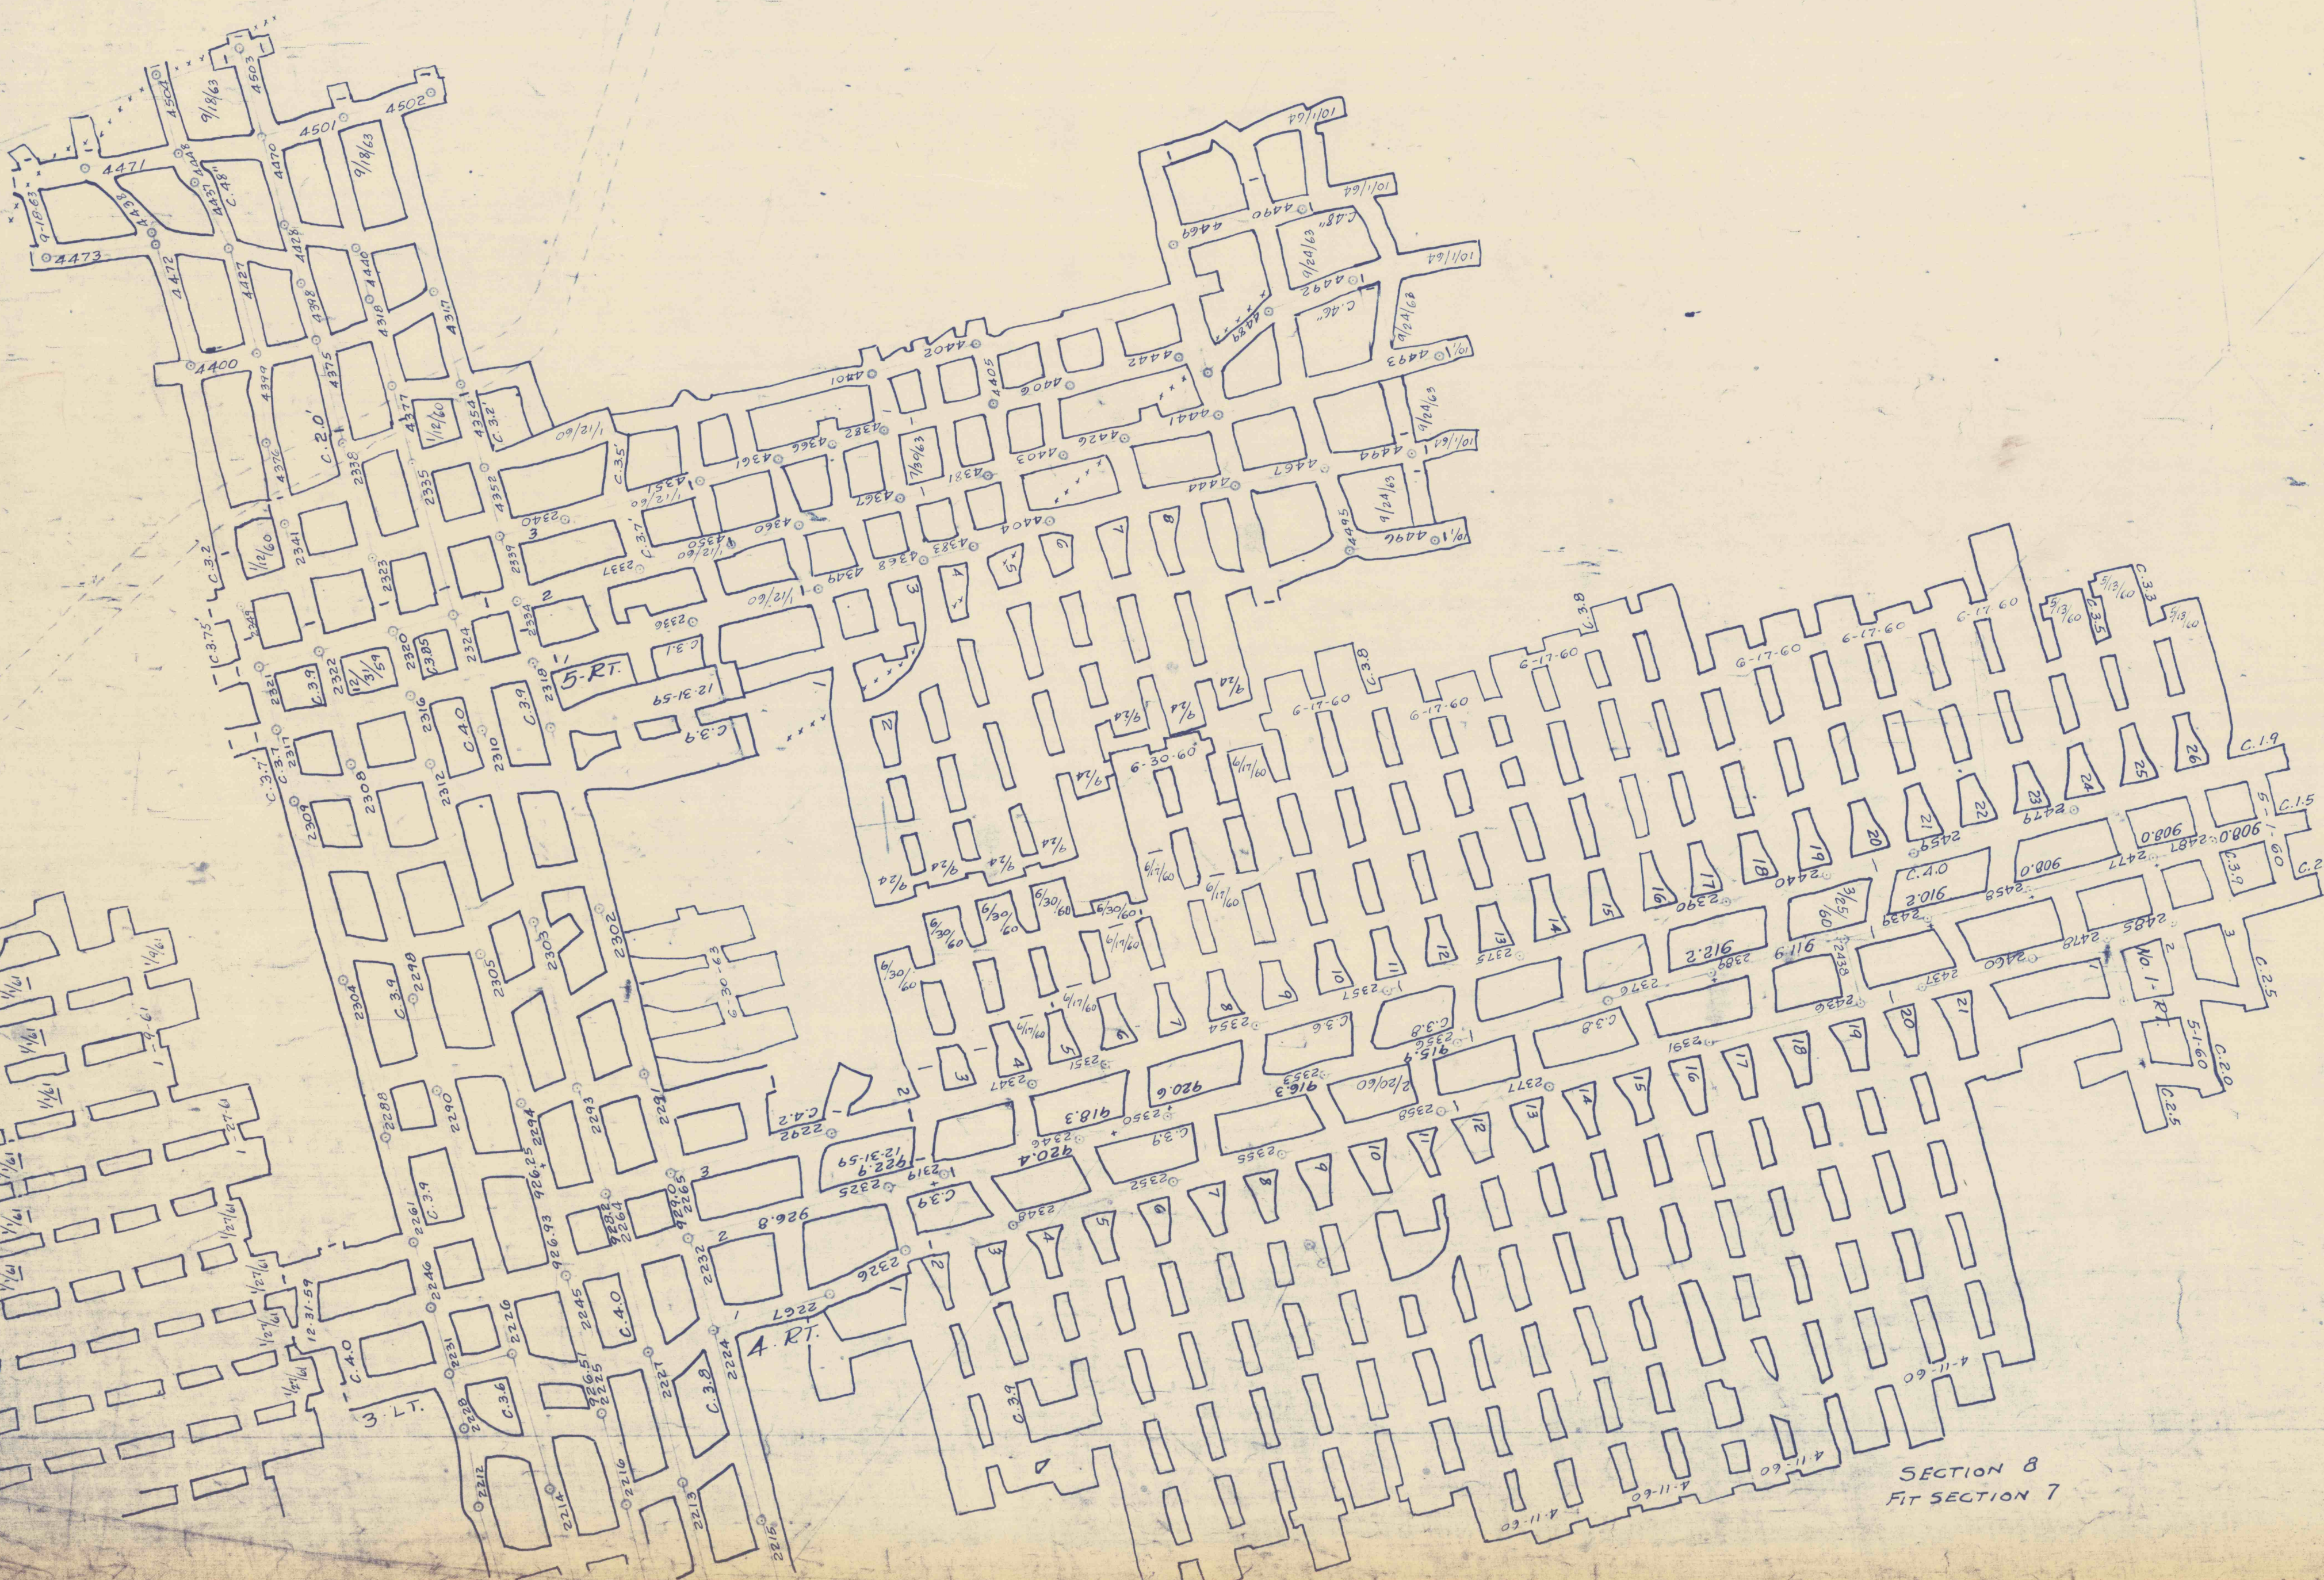

SECTION 8
FIT SECTION 7

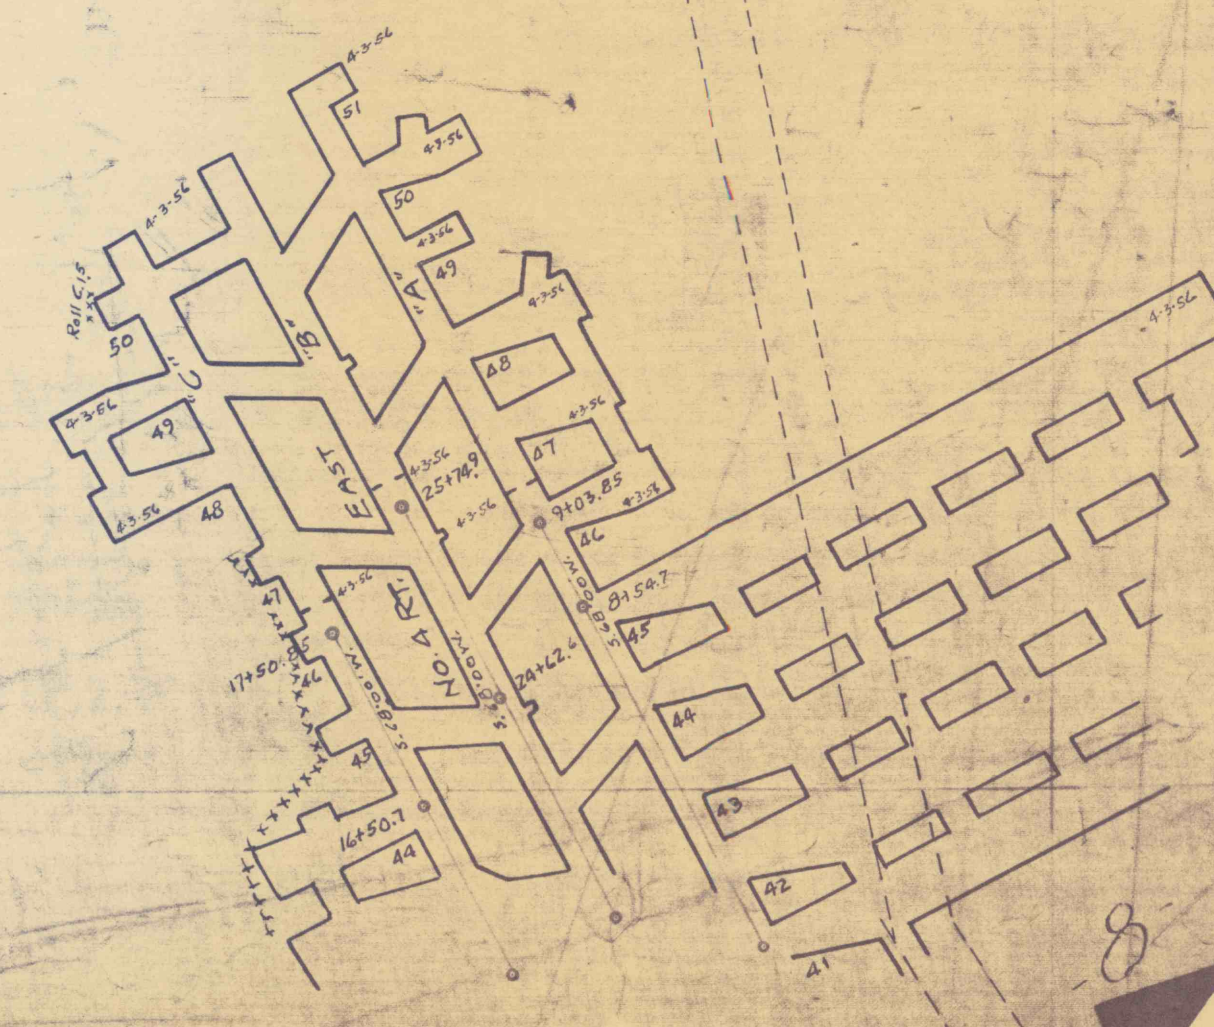

SECTION 8
FIT SECTION 6