
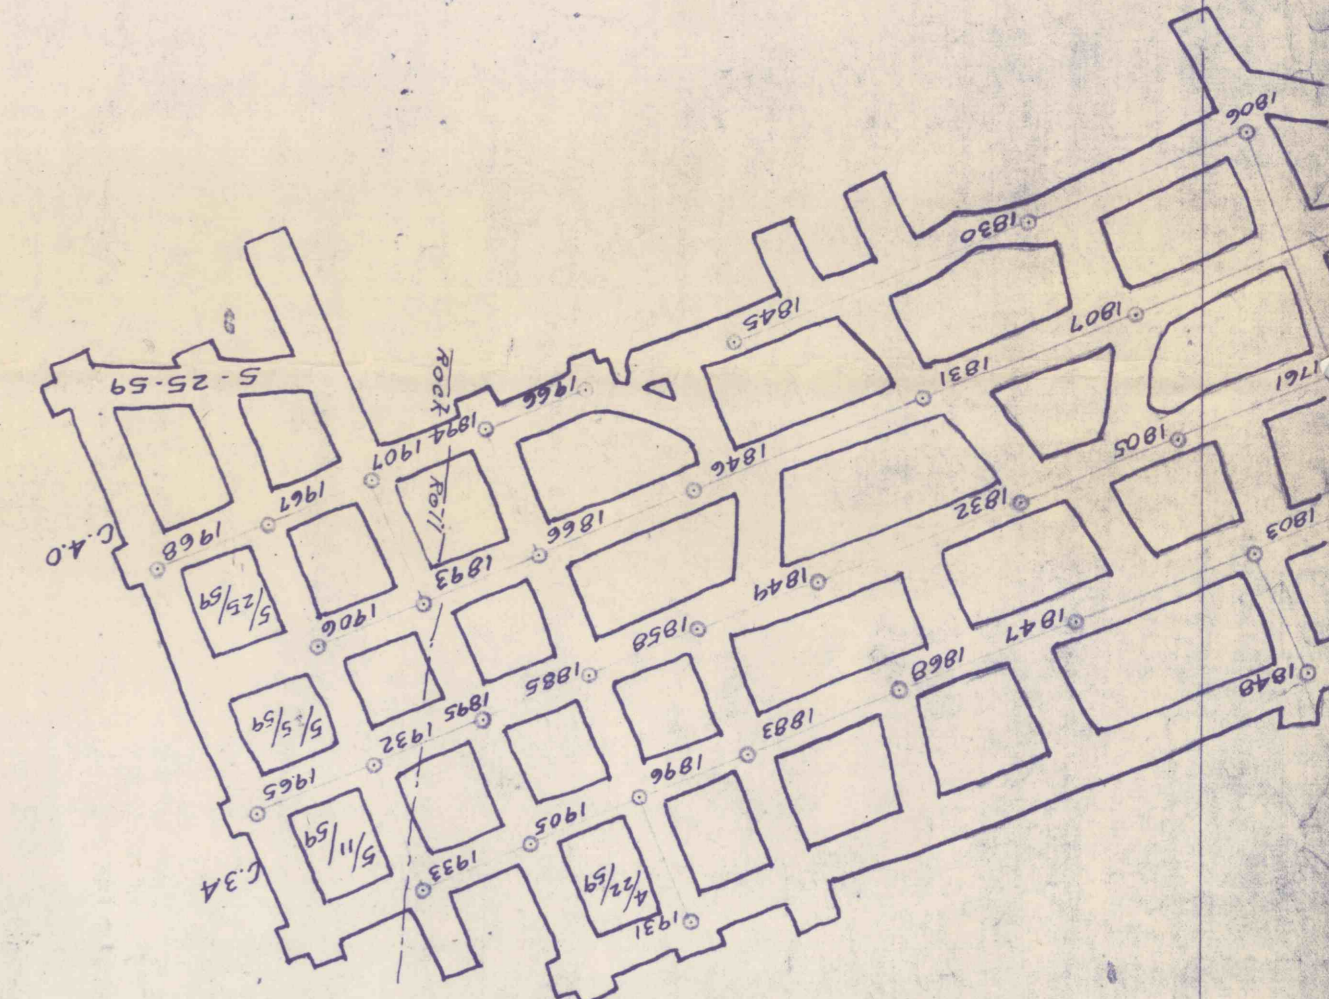


SECTION 44 21 2 2

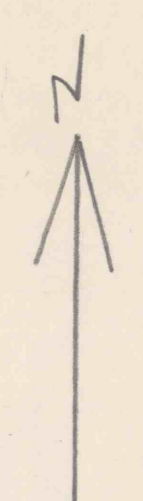

4  
4