



SEC. 8
T11 to T12

GAS WELL
⊙
ACTIVE

SECTION 8
FIT SECTION 6

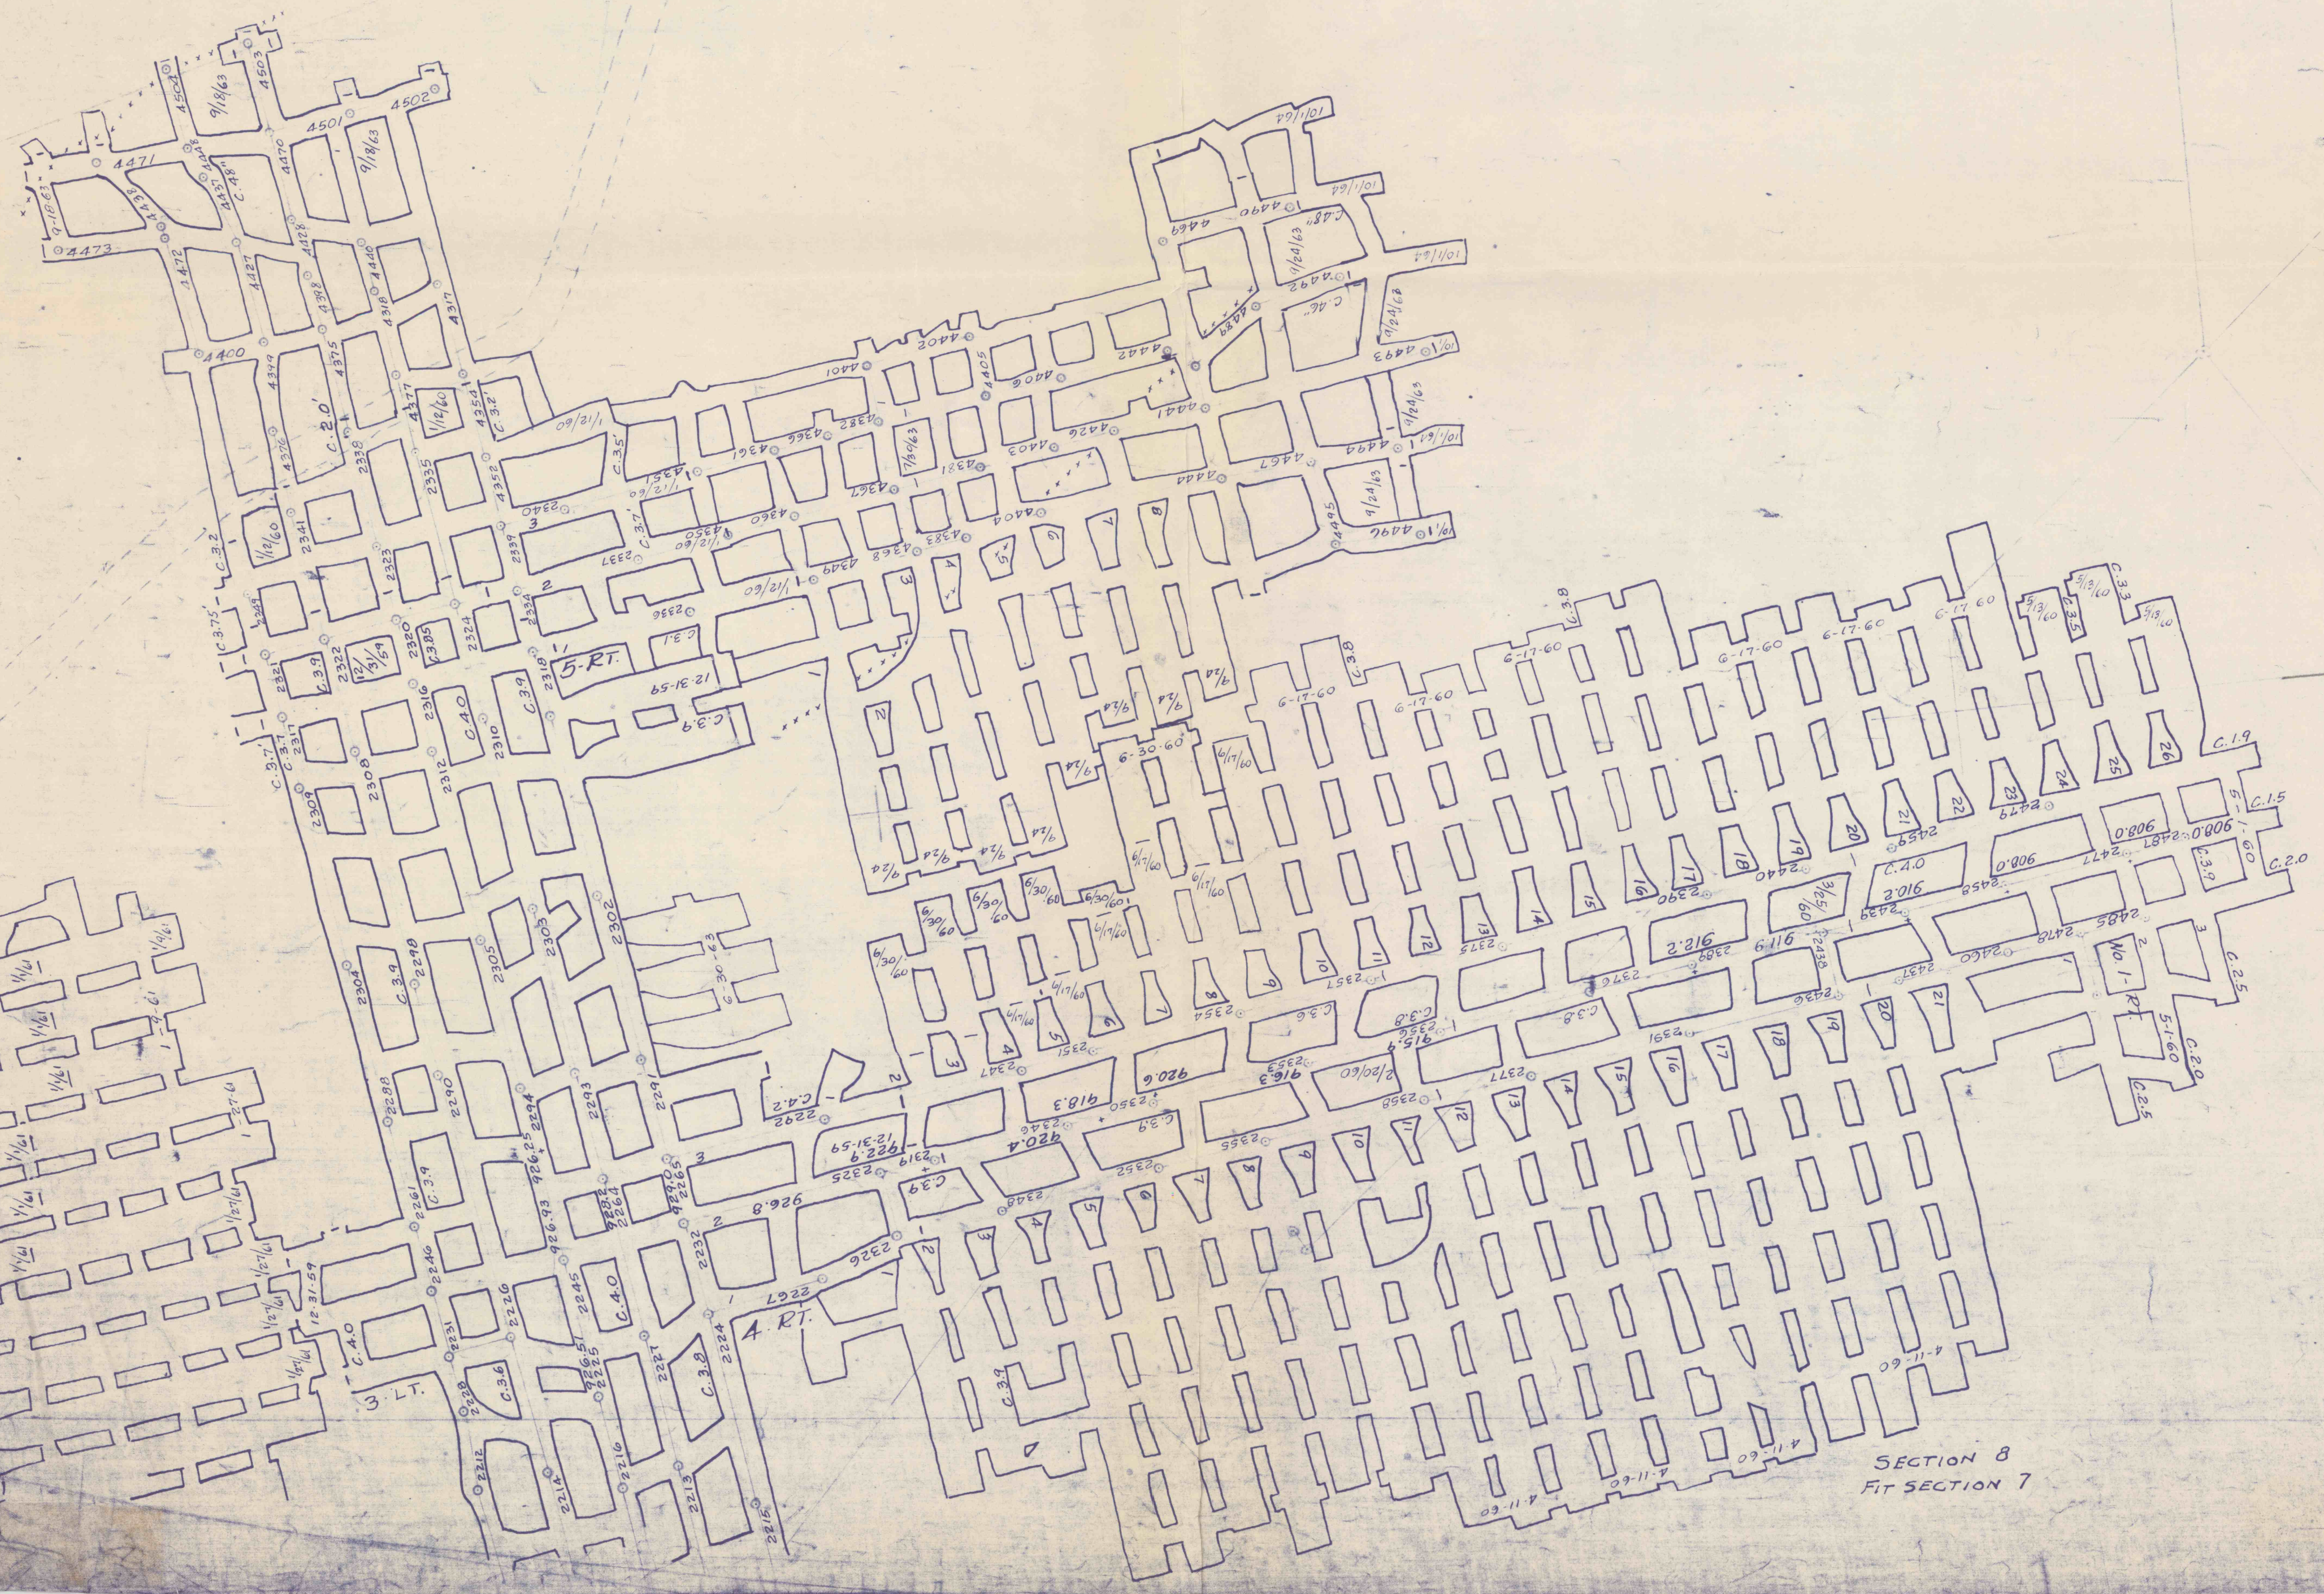

SECTION 8
FIT SECTION 7

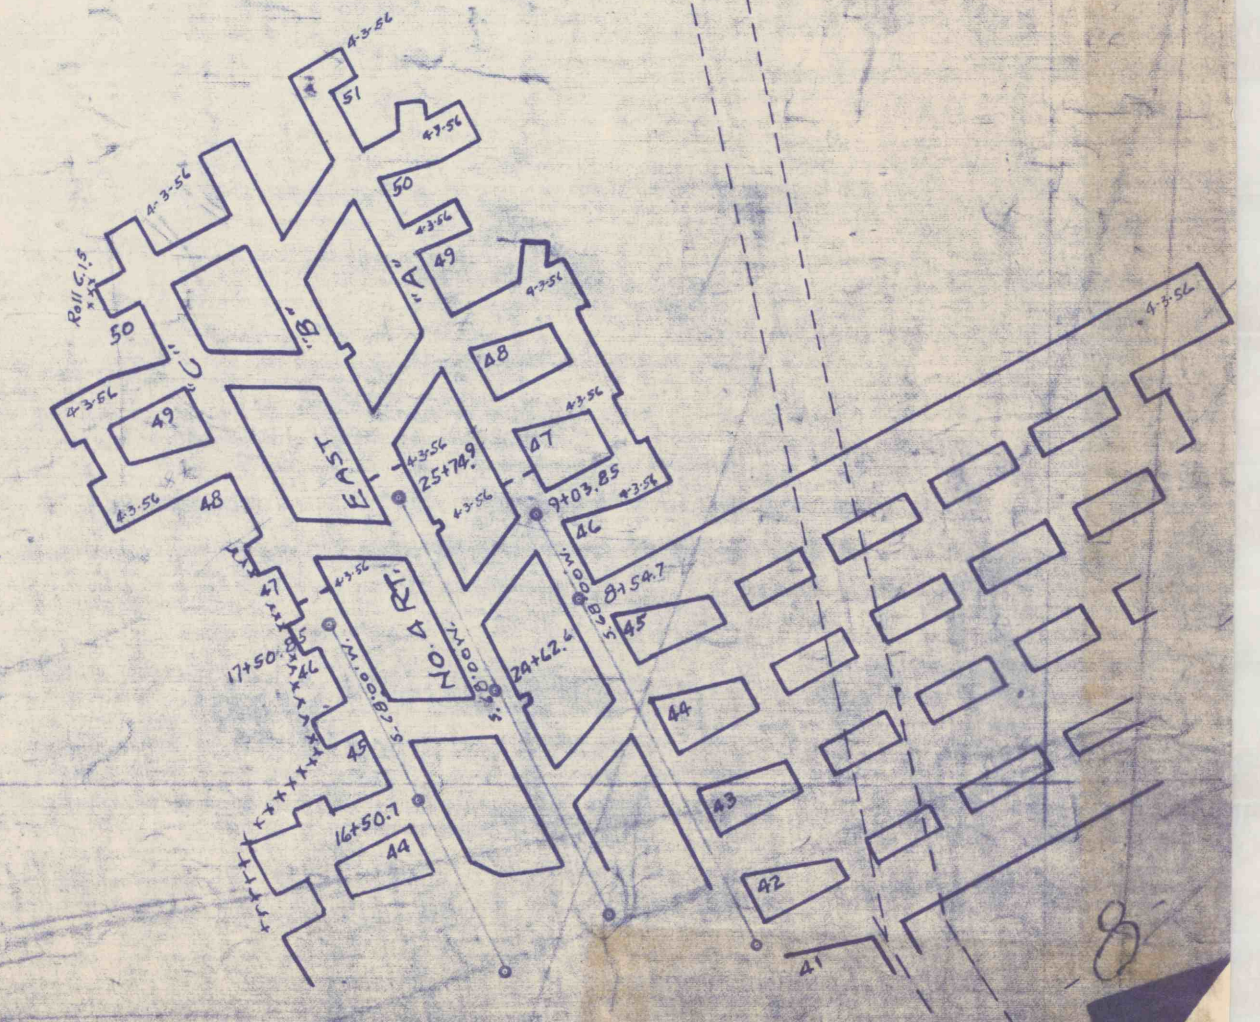

8