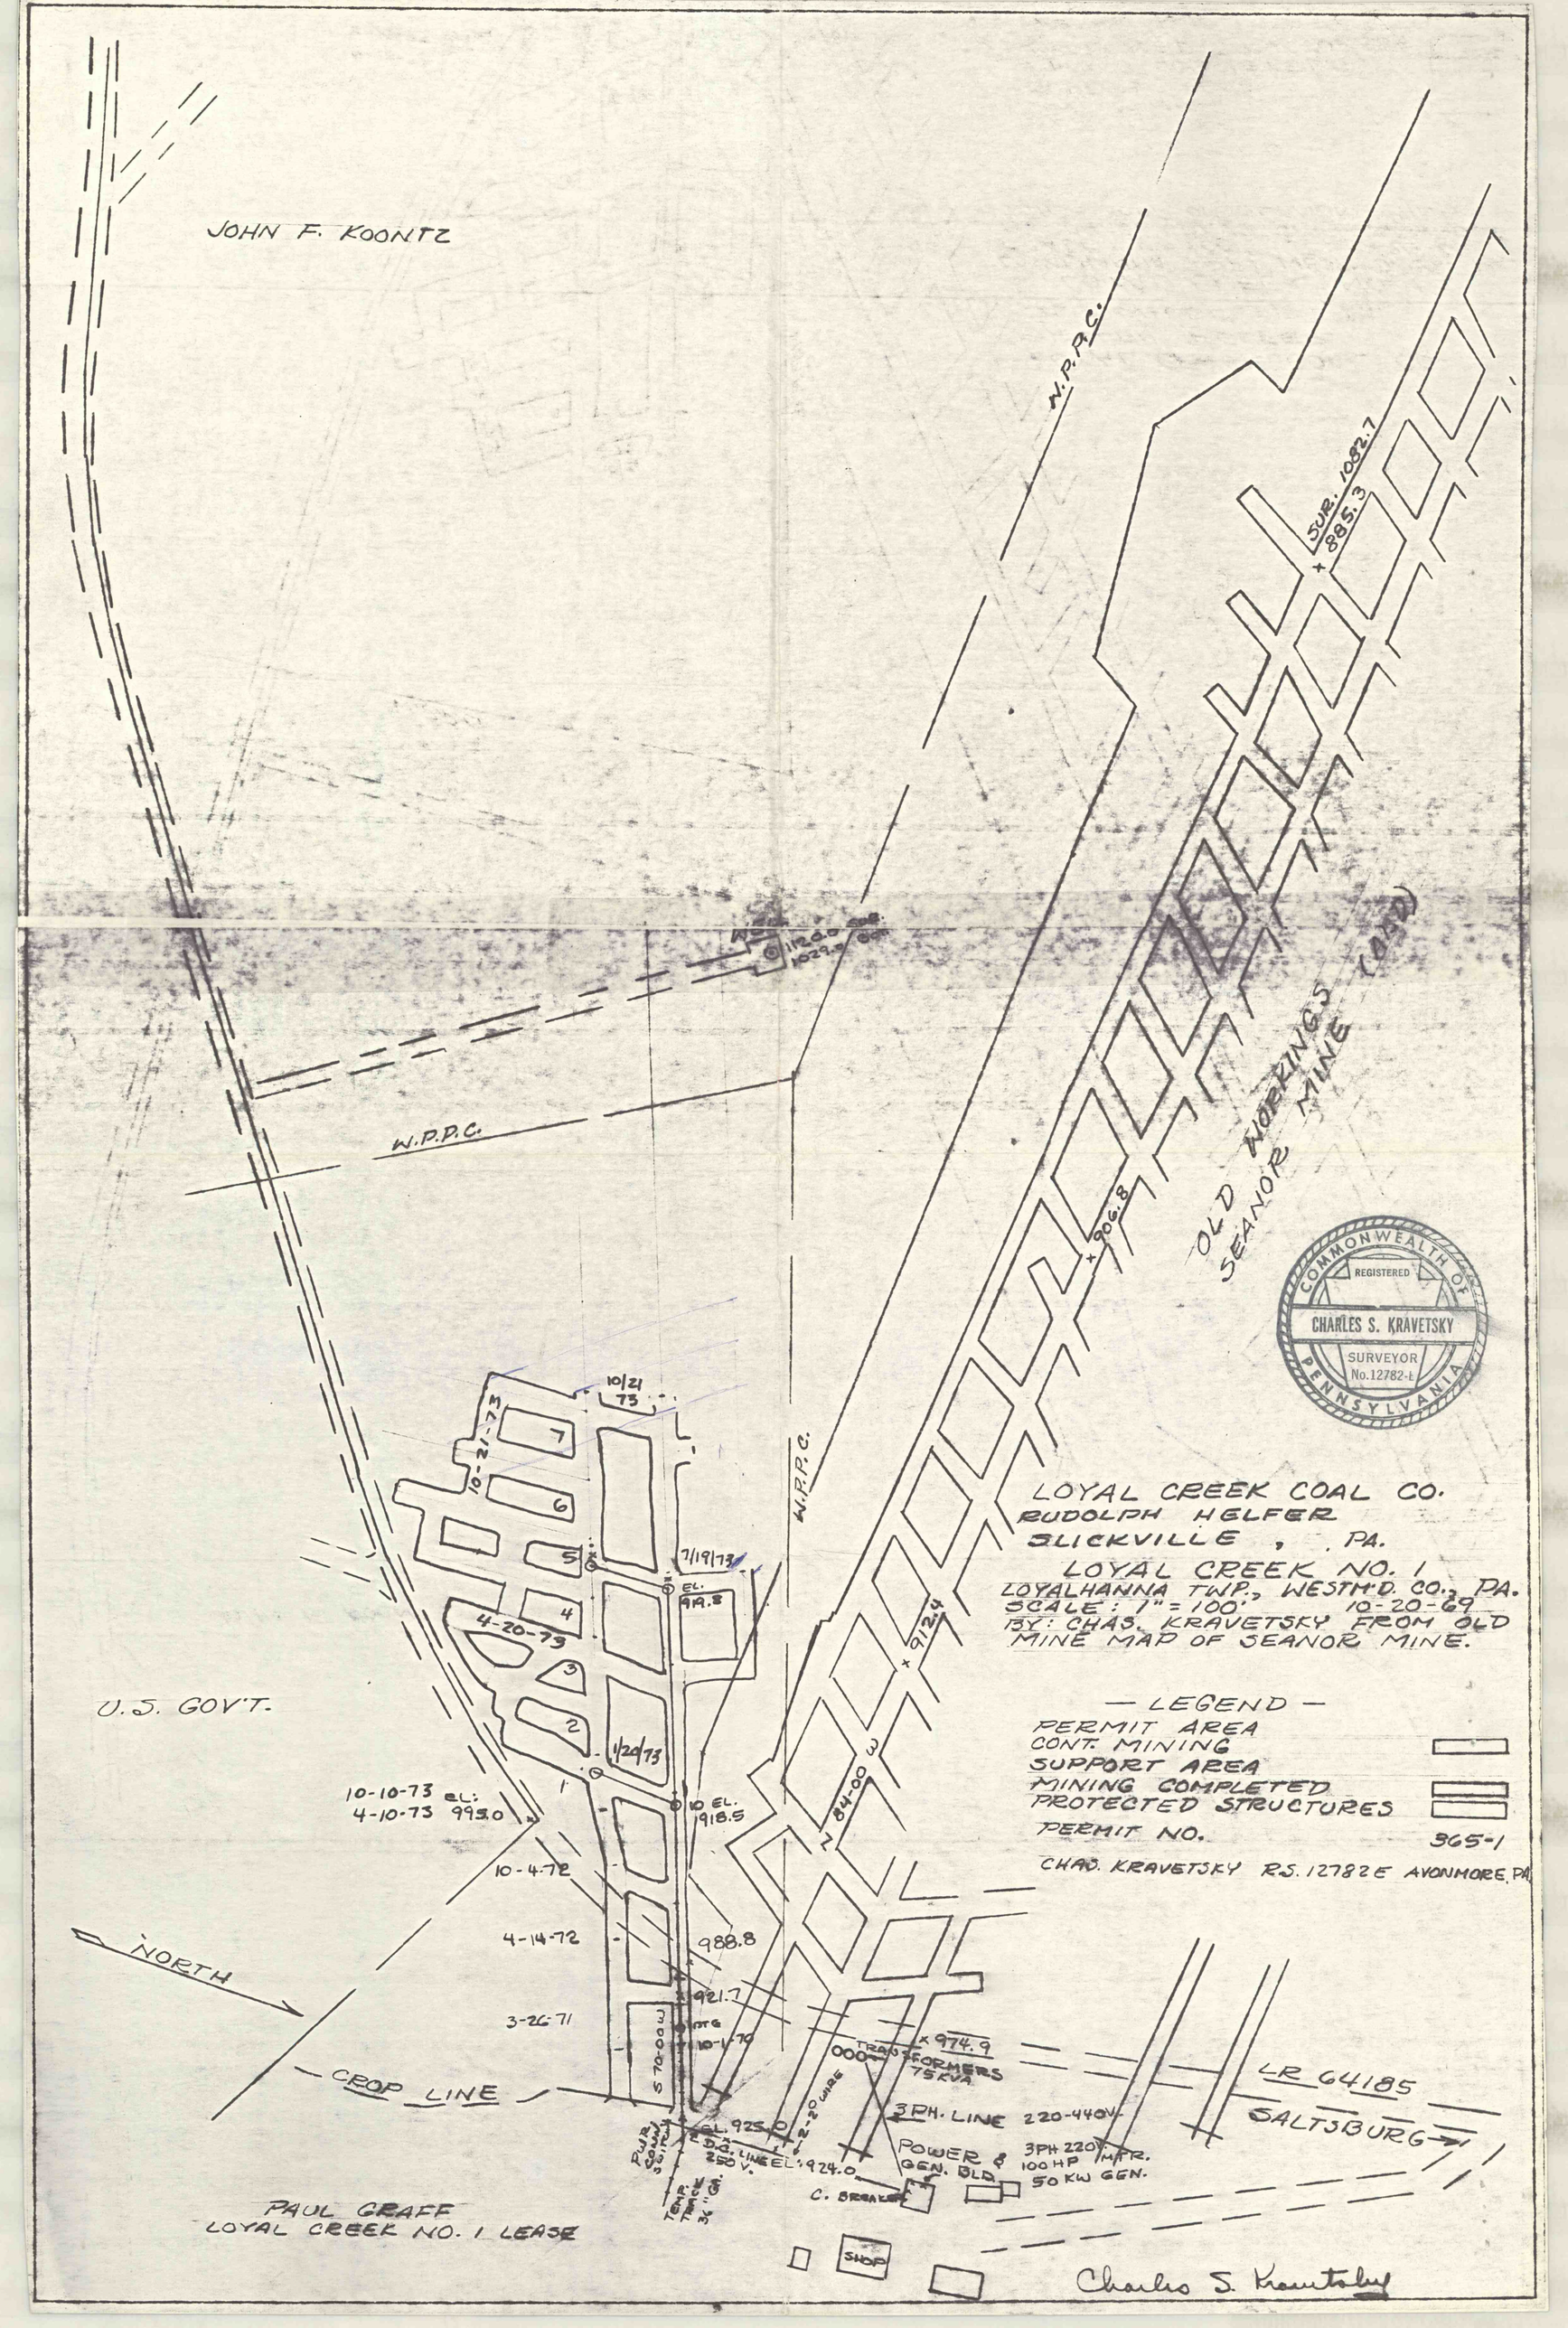

LOYAL CREEK COAL CO.
RUDOLPH HELFER
SLICKVILLE, PA.

LOYAL CREEK NO. 1
LOYALHANNA TWP., WESTM'D. CO., PA.
SCALE: 1" = 100' 10-20-69
BY: CHAS. KRAVETSKY FROM OLD MINE MAP OF SEANOR MINE.

— LEGEND —

PERMIT AREA
CONT. MINING
SUPPORT AREA
MINING COMPLETED
PROTECTED STRUCTURES
PERMIT NO. 365-1

CHAS. KRAVETSKY R.S. 12782E AVONMORE, PA.

Charles S. Kravetsky