


QHP  
of  
NO 5 MINE  
ROYAL HANNA C. & C. Co.  
Situated at  
Cambria Cambria County Penna.  
1906. J. B. BILLYMAN COS.

*L.H.C.*  
*Summit Hill*  
*F.A.P.*

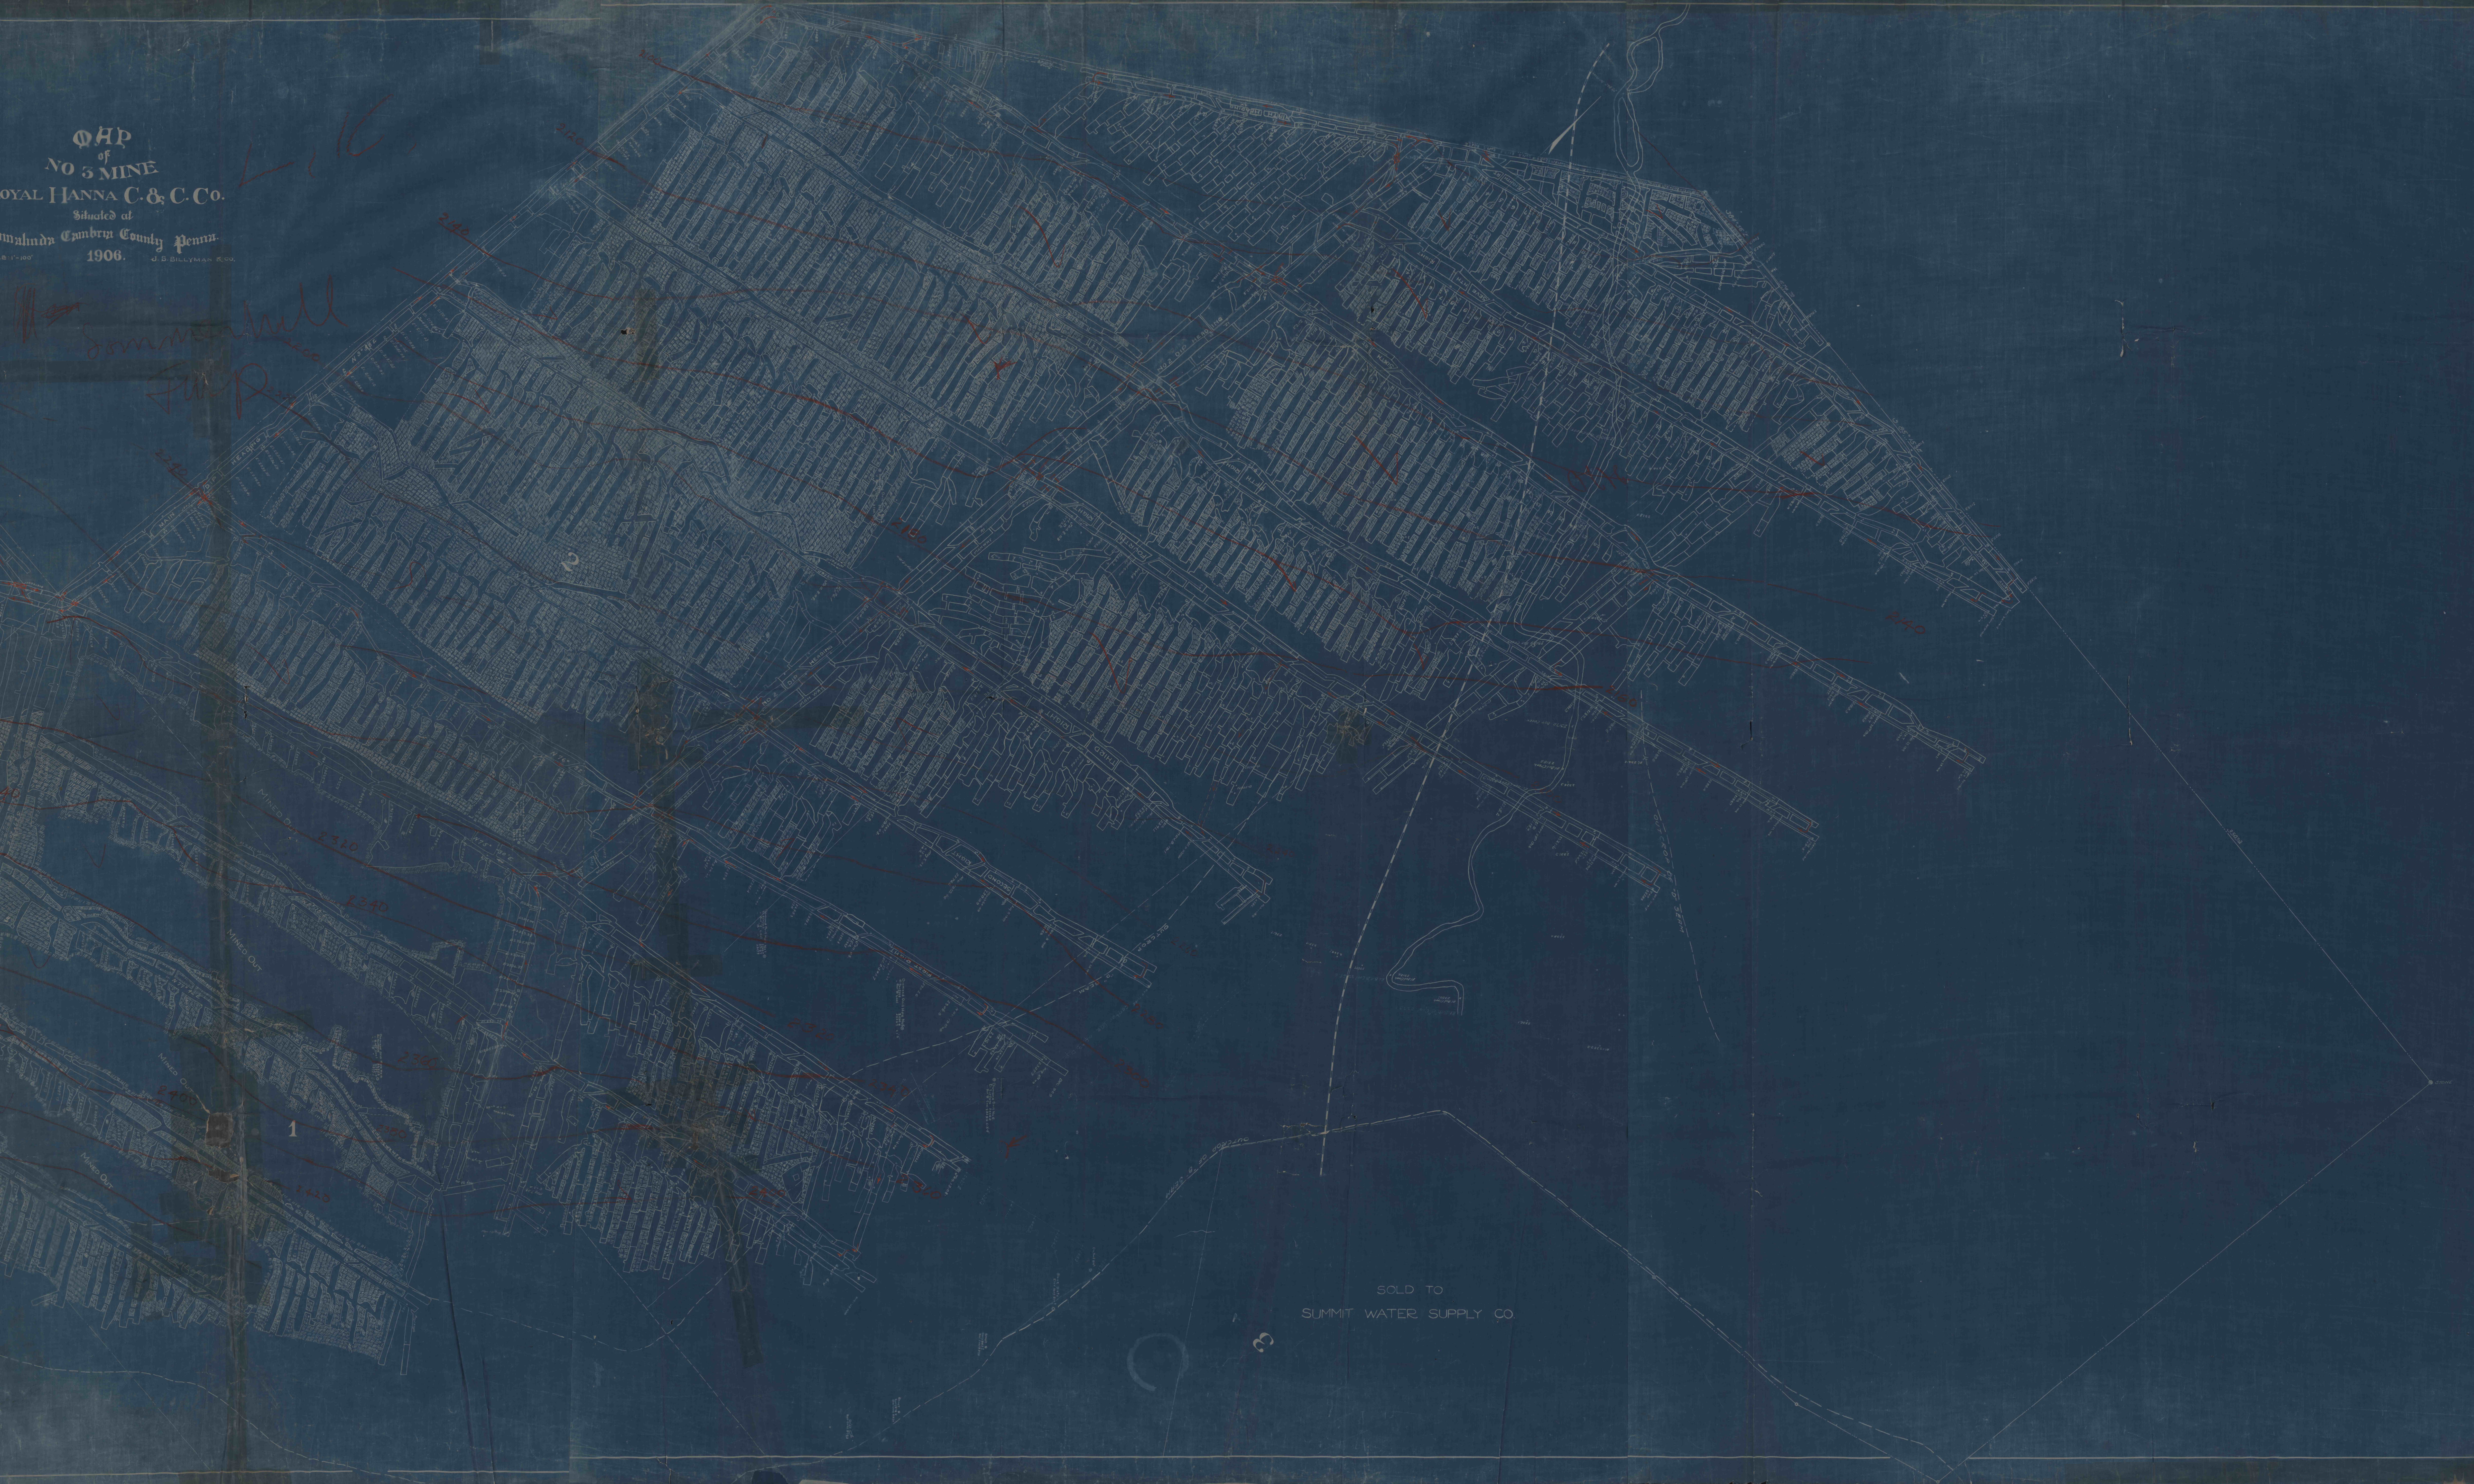

SOLD TO  
SUMMIT WATER SUPPLY CO.

3