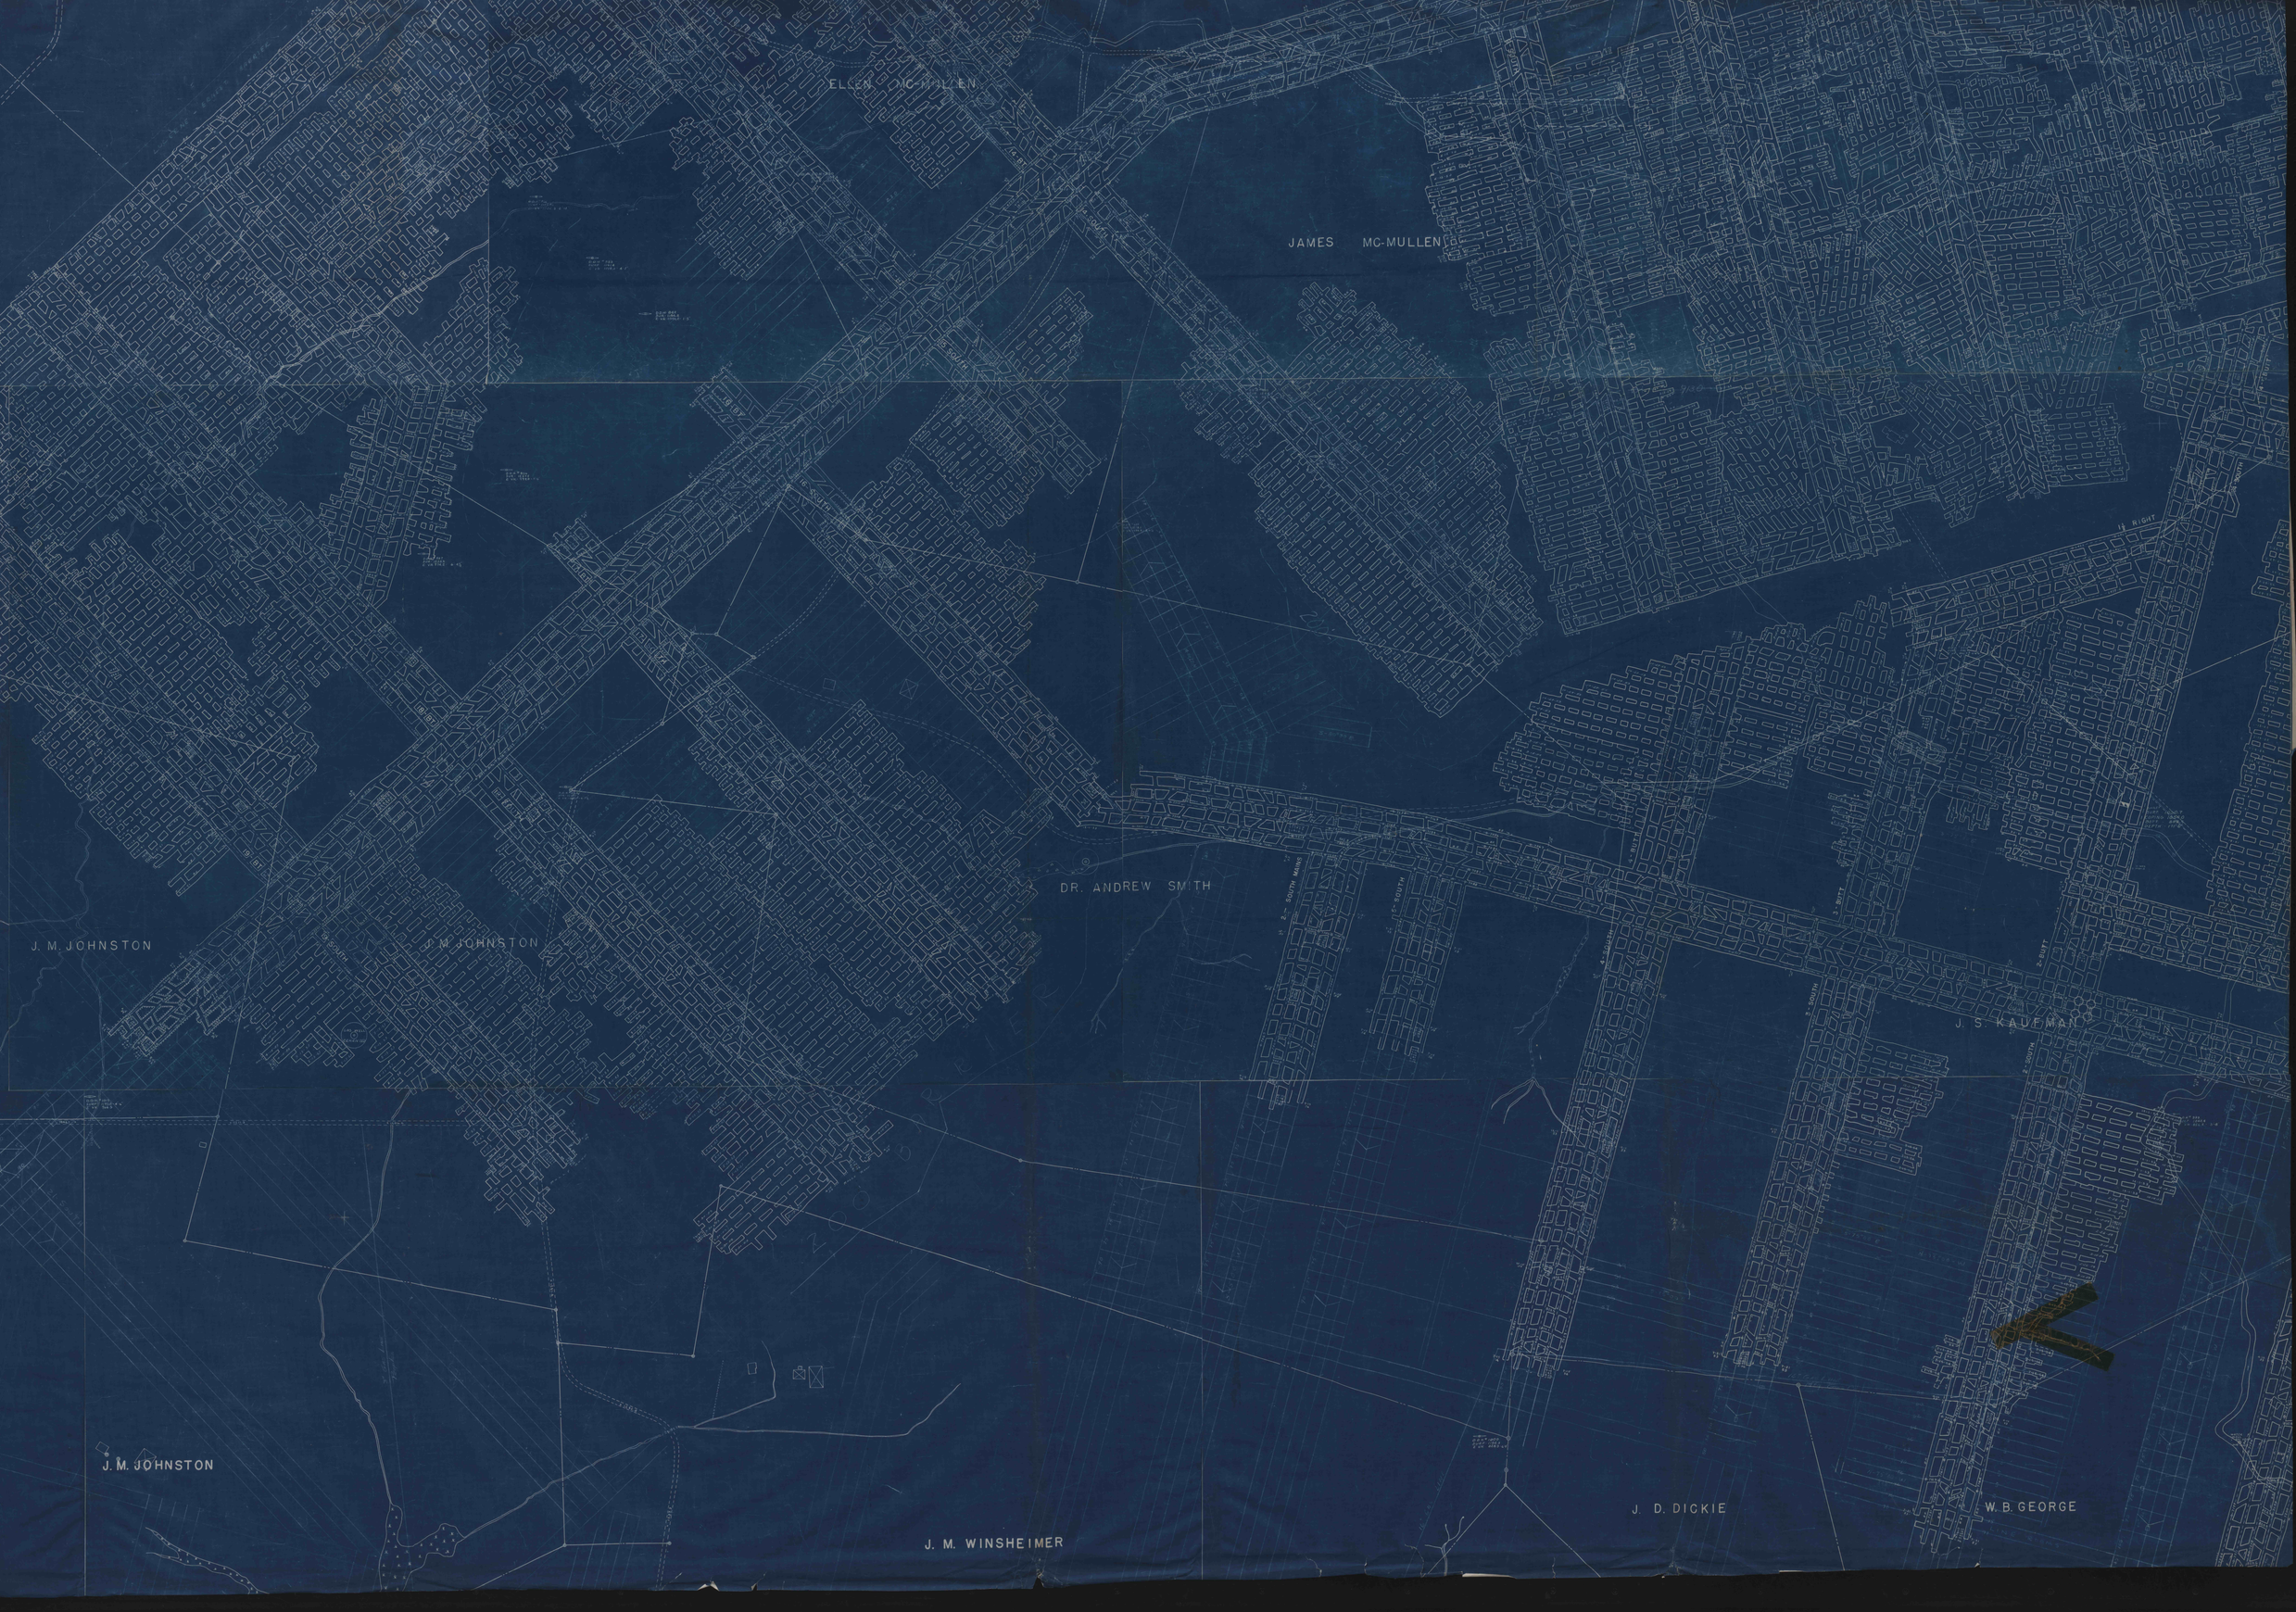
ELLEN MC-MULLEN
JAMES MC-MULLEN
DR. ANDREW SMITH
J. M. JOHNSTON
J. M. JOHNSTON
J. S. KAUFMAN
J. M. JOHNSTON
J. M. WINSHEIMER
J. D. DICKIE
W. B. GEORGE