


LEGEND


- Contemplated Mining 55A
February 9, 1966 to August 9, 1969
- Mining Completed

Mine Works	11/9/68	G.A.P.
Mine Works	7/30/68	R.S.T.
Mine Works	6/1/68	W.S.S.
Mine Works	4/21/67	R.S.T.
Mine Works	3/1/67	G.B.T.
Mine Works	12/20/65	R.S.T.

- REVISIONS -

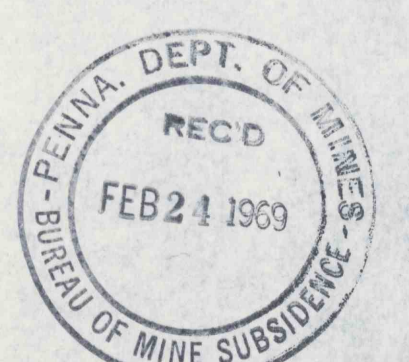

PERMIT #64-1

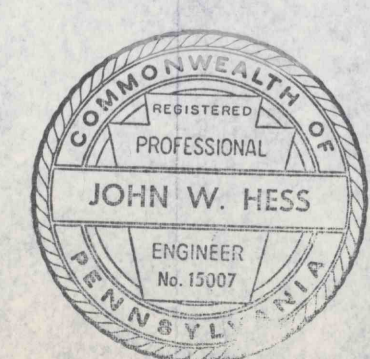

HEPBURNIA COAL CO.
LULA MAY NO. 1
SUSQUEHANNA TWP. CAMBRIA CO. PA.
SCALE - 1 inch = 100 feet
AUGUST 2, 1965 JOHN W. HESS
CLEARFIELD PA. ENGINEER
#1655