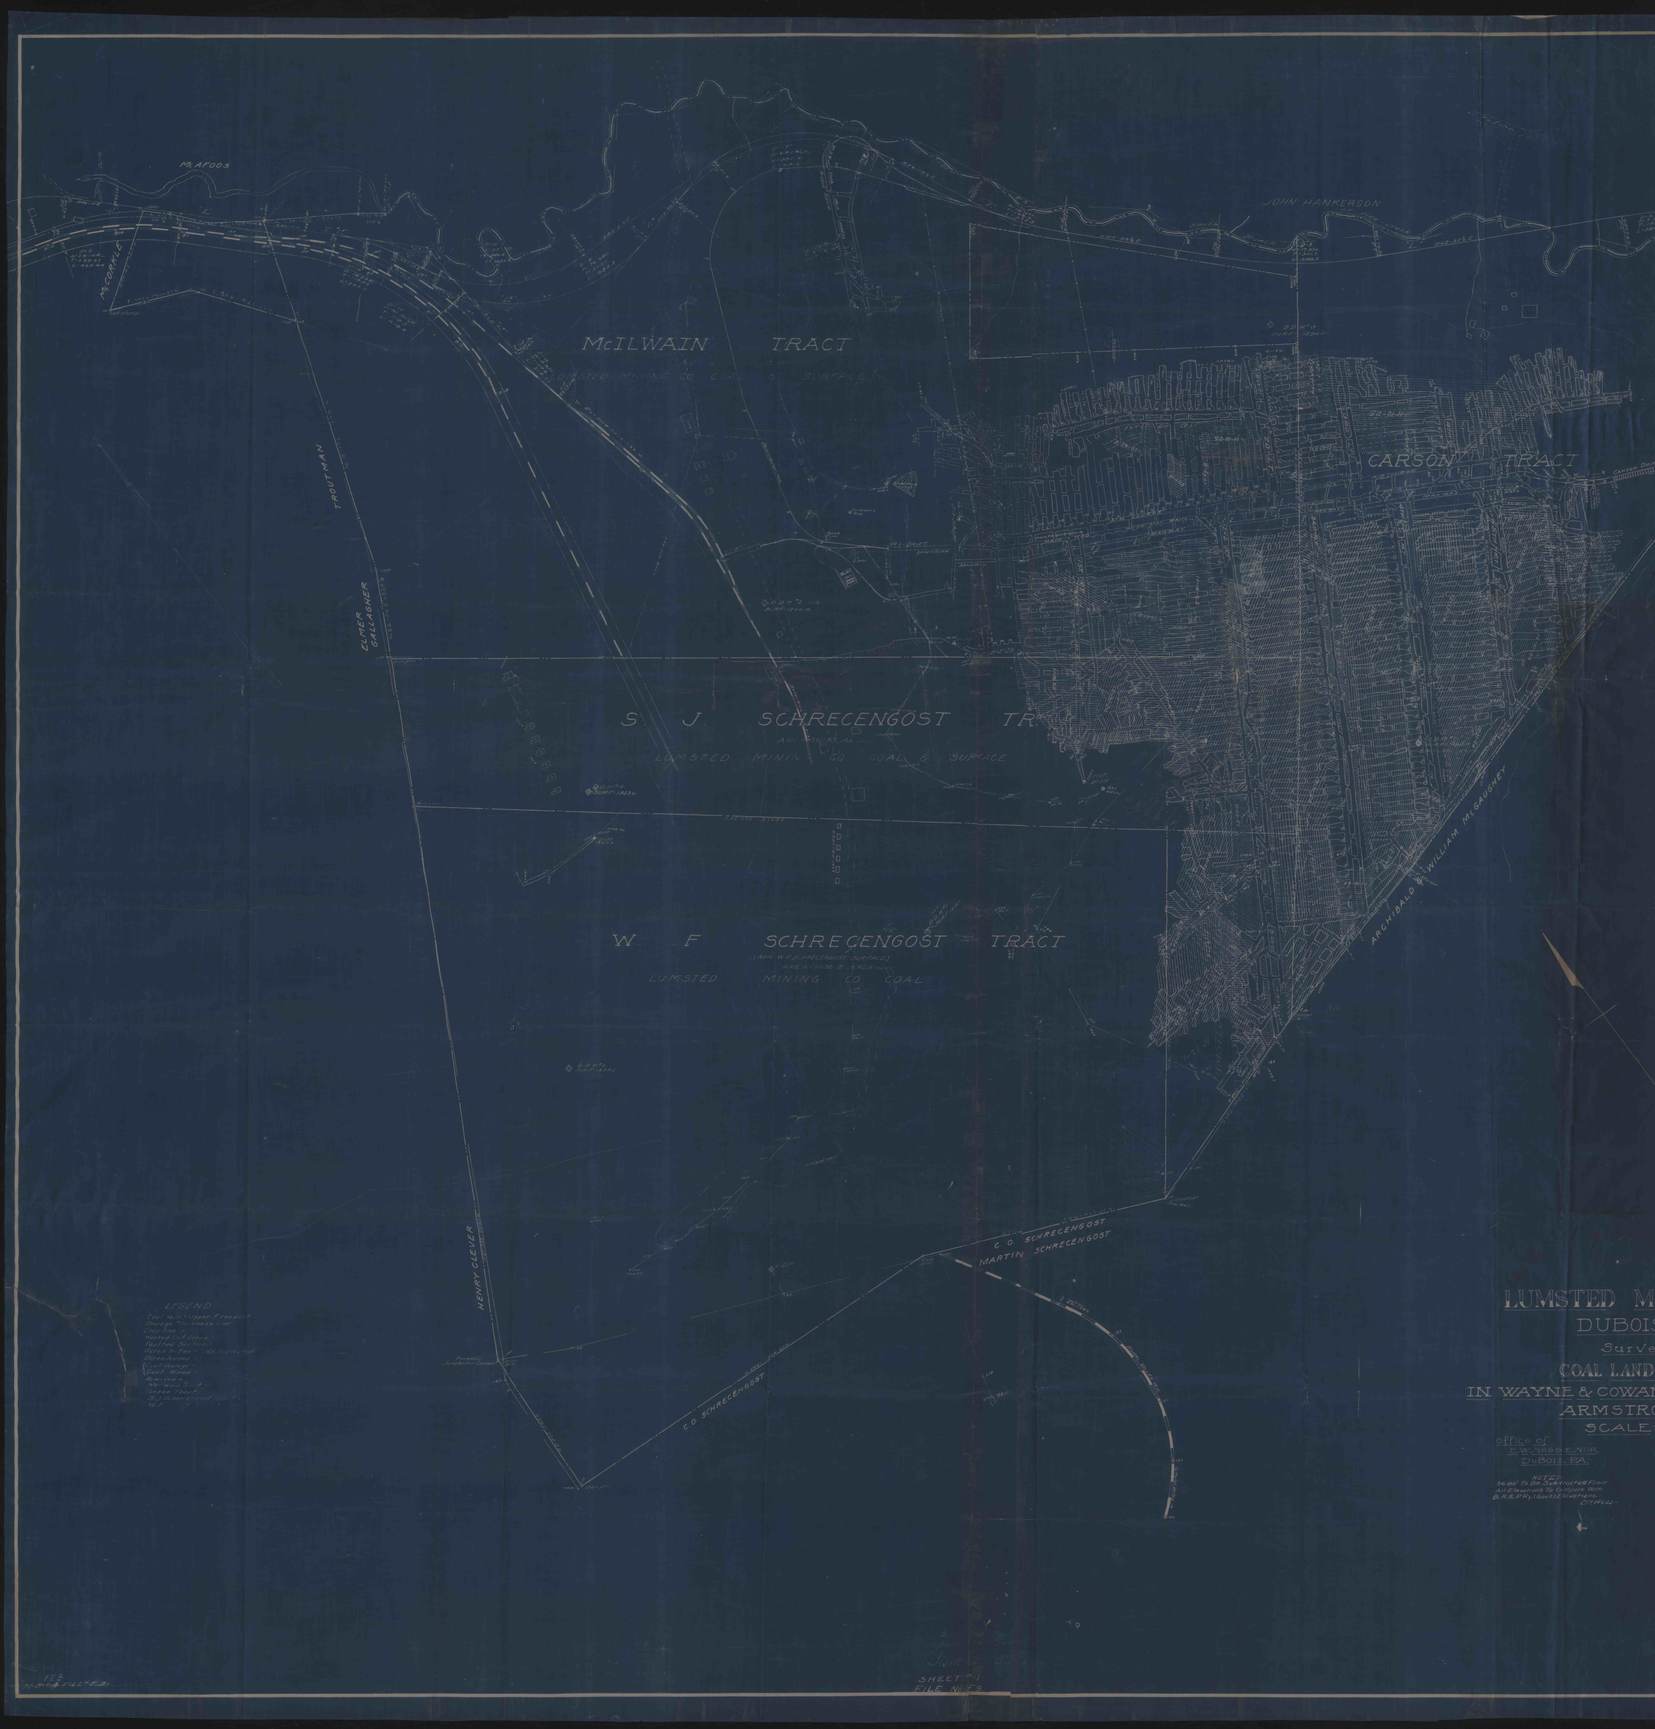
McILWAIN TRACT
CARSON TRACT
S J SCHRECENGOST TR
LUMSTED MINING CO COAL & SURFACE
W F SCHRECENGOST TRACT
LUMSTED MINING CO COAL
JOHN HANKERSON
TROUTMAN
ELMER GALLAGHER
HENRY CLEVER
ARCHIBALD & WILLIAM McGAUGHEY
C O SCHRECENGOST
MARTIN SCHRECENGOST
LEGEND
LUMSTED M
DUBOIS
Surve
COAL LAND
IN WAYNE & COWAN
ARMSTRO
SCALE
Office of
E.W. HAGGENOR
DUBOIS, PA.
NOTES
Named To Dr. Schrecengost From
All Elevations To Compare With
B.R.R.P.Ry. (Govt.) Elevations.
CITY LOT
SHEET 1
FILE NO. 5