

MINED OUT
TO OCT. 24, 1968

MINED OUT
TO APR. 24, 1968

MINED
TO APR. 24, 1969

MINED OUT TO
OCT. 24, 1967

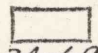
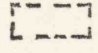

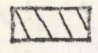
MINED OUT TO APR. 24, 1969

MCCRACKEN COAL CO. #2 MINE
YOUNG TWP., INDIANA CO., PA.

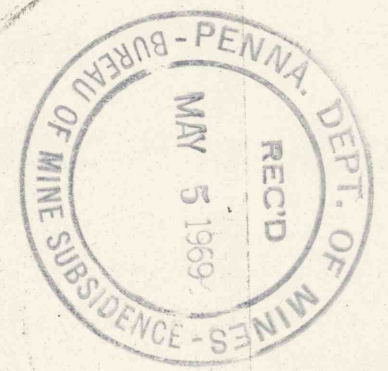
POSTED APRIL 24, 1969

Edward Sohler #90.E

LEGEND

- Contemplated Mining- NONE 
- ALL MINING COMPLETED 4-24-69
- Support Area 
- Protected Structure 
- Mining Completed Area 

SCALE 1"=100'



FIELD COPY

NOW OR FORMERLY

558' 26" E
675.00

450.00

COAL LINE
N 96° 07' E

10-24-68

4-24-68

10-24-67

4-24-69

240.00

700.00

533.00