


Red = PITTSBURGH COAL SEAM
Yellow = AREA WORKED OUT -
GREEN = SURFACE
Av. Height of Coal = 4' 10"

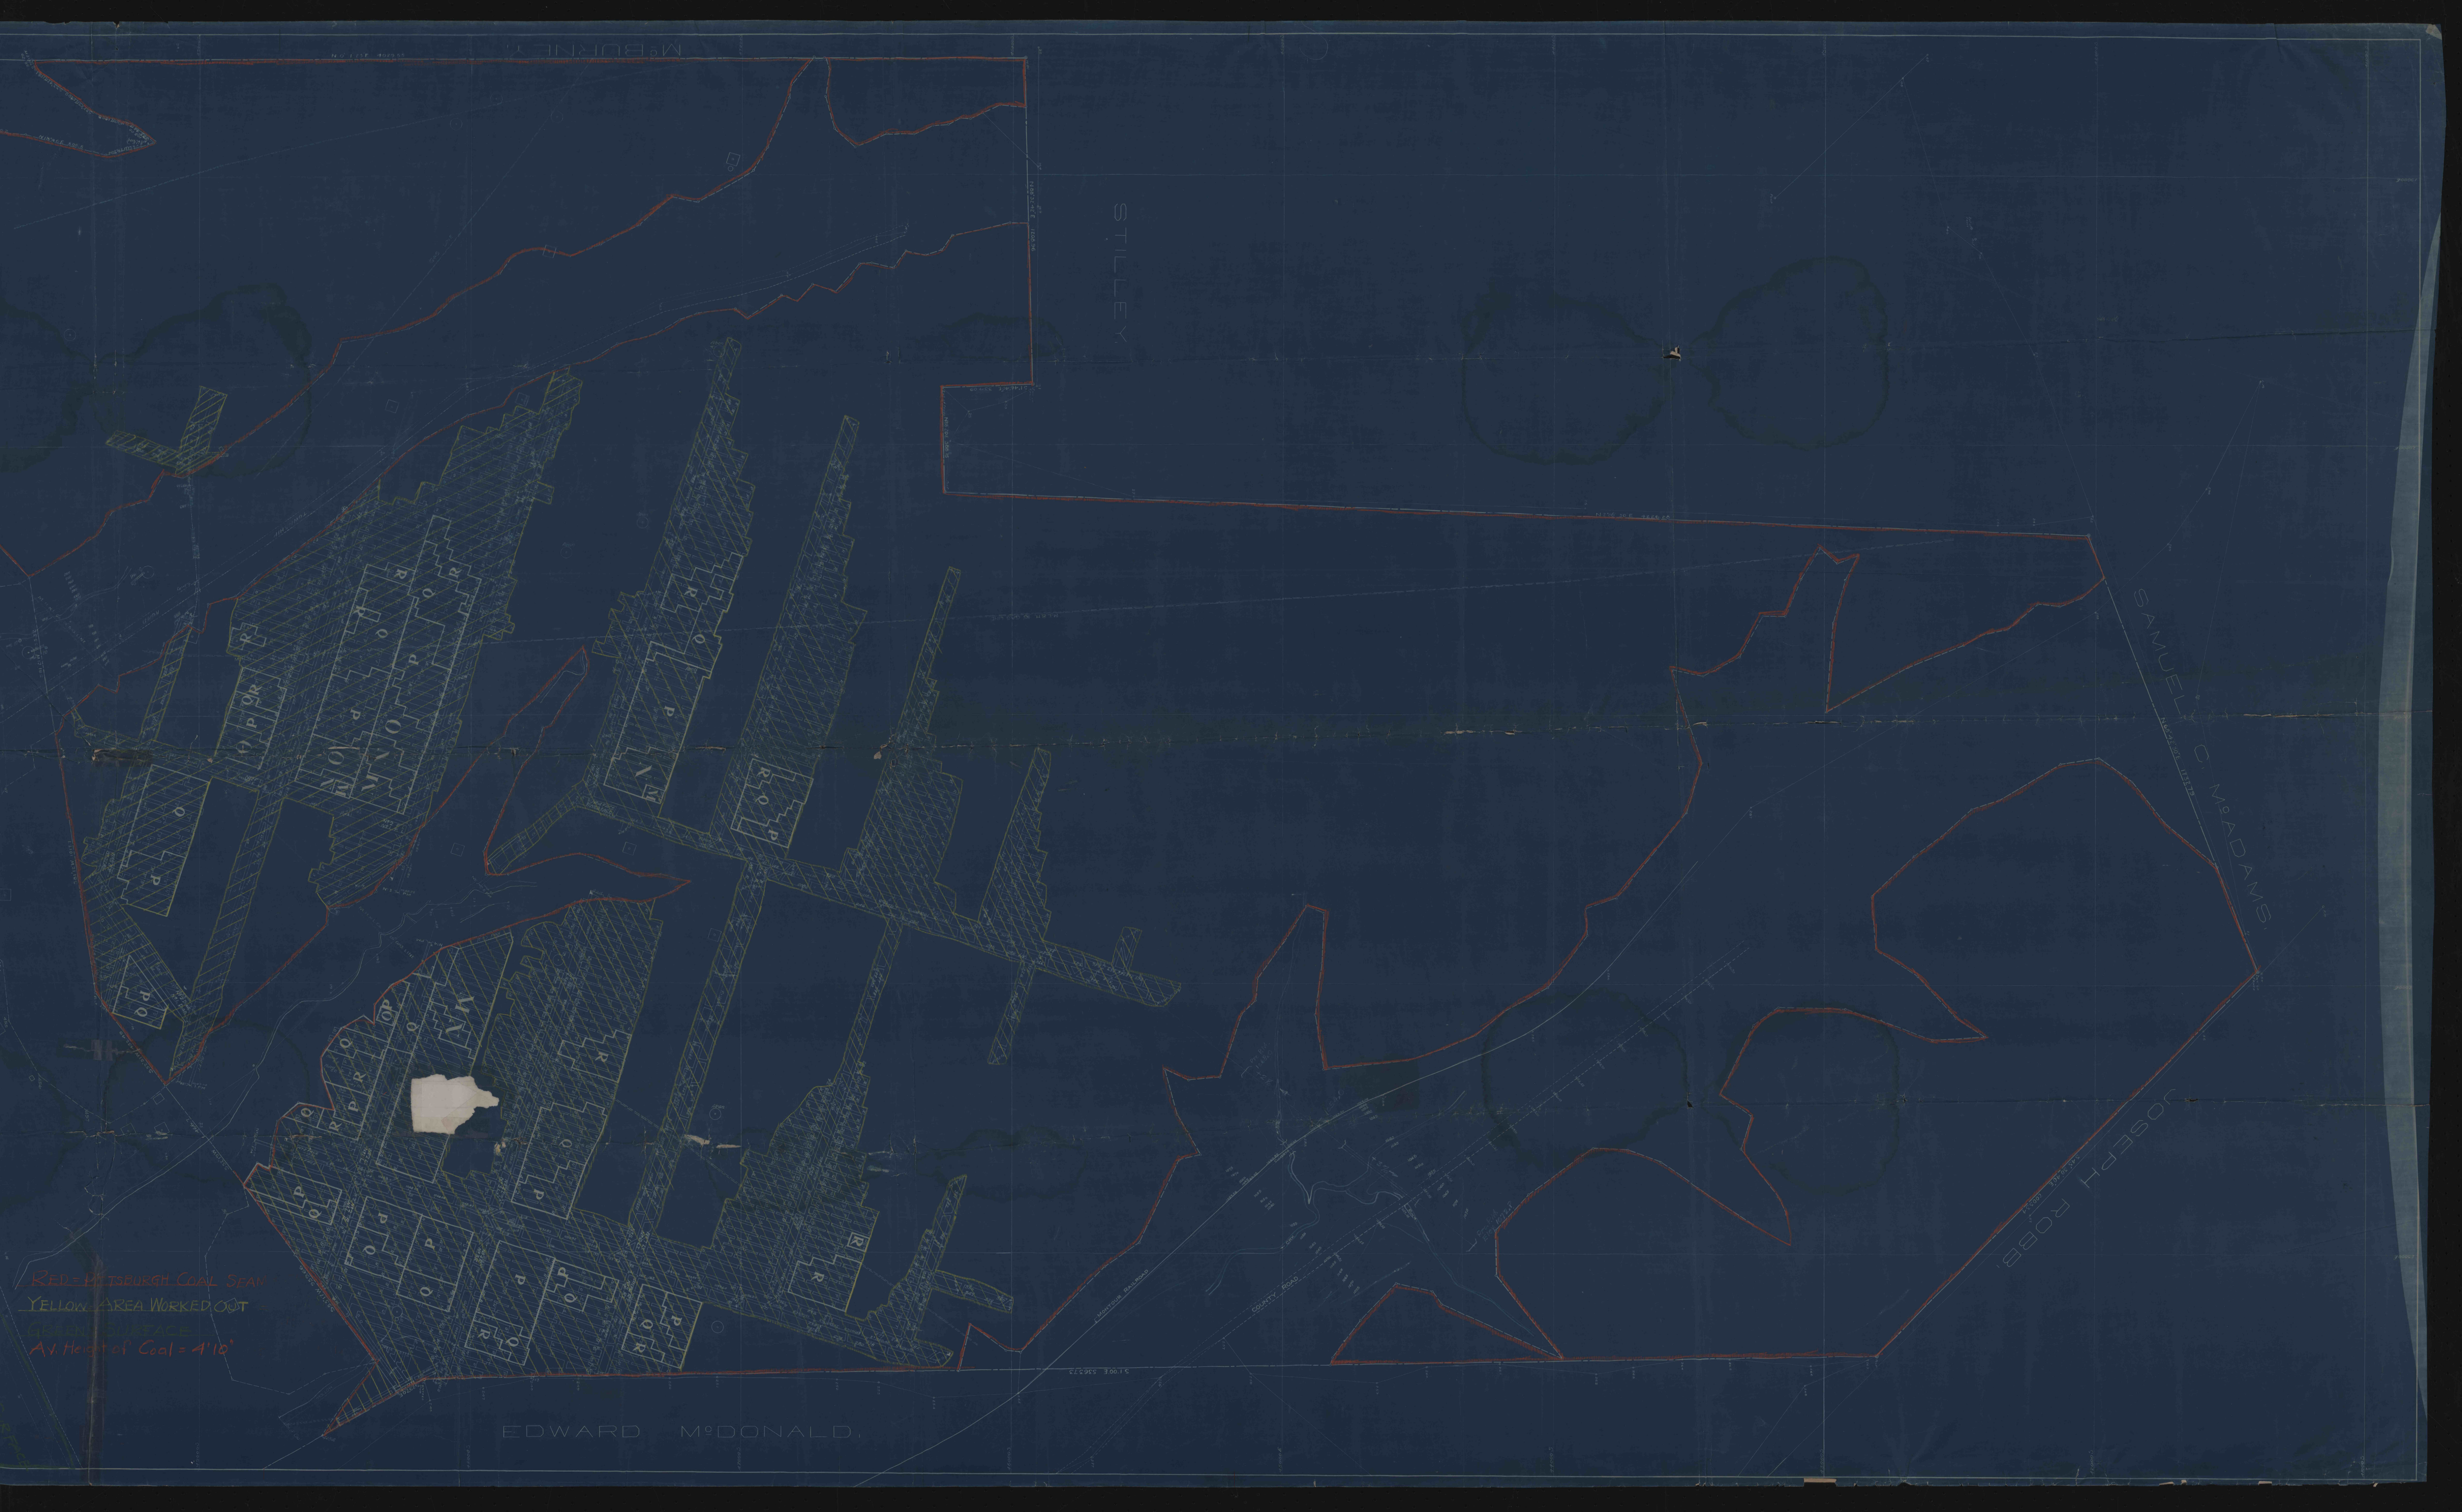

STILLEY

SAMUEL O. MADAMS

JOSEPH H. ROBB

EDWARD McDONALD

1" = 100'