

MAP SHOWING MINING OPERATIONS
OF
F.B. ROBBINS

ASHVILLE, PENNSYLVANIA.
IN - GALLITZAN TOWNSHIP - CAMBRIA COUNTY

SCALE - 1" = 100'

DRAWN BY - J.C.P.

MAP REVISED TO - 8-26-63

REFERENCE - W.A. SILLIMAN SURVEY



J. A. MCGUIRE


ALTOONA COAL & COKE CO.

SURVEYED BY - JOHN C. PASSMORE R.S.

400 WEST MILTON ST.

EBENSBURG, PA.

TELE - 6R-28008

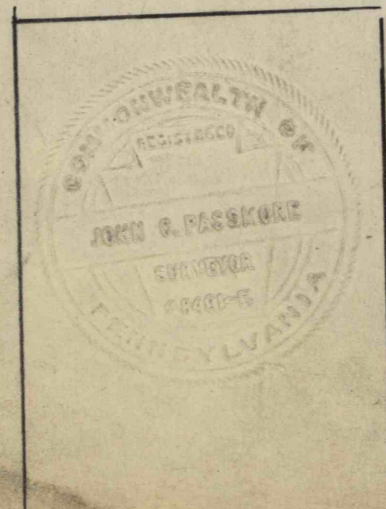

McGUIRE COAL CO.
McGUIRE No. 1

FOX MINE DRIFT

11/64