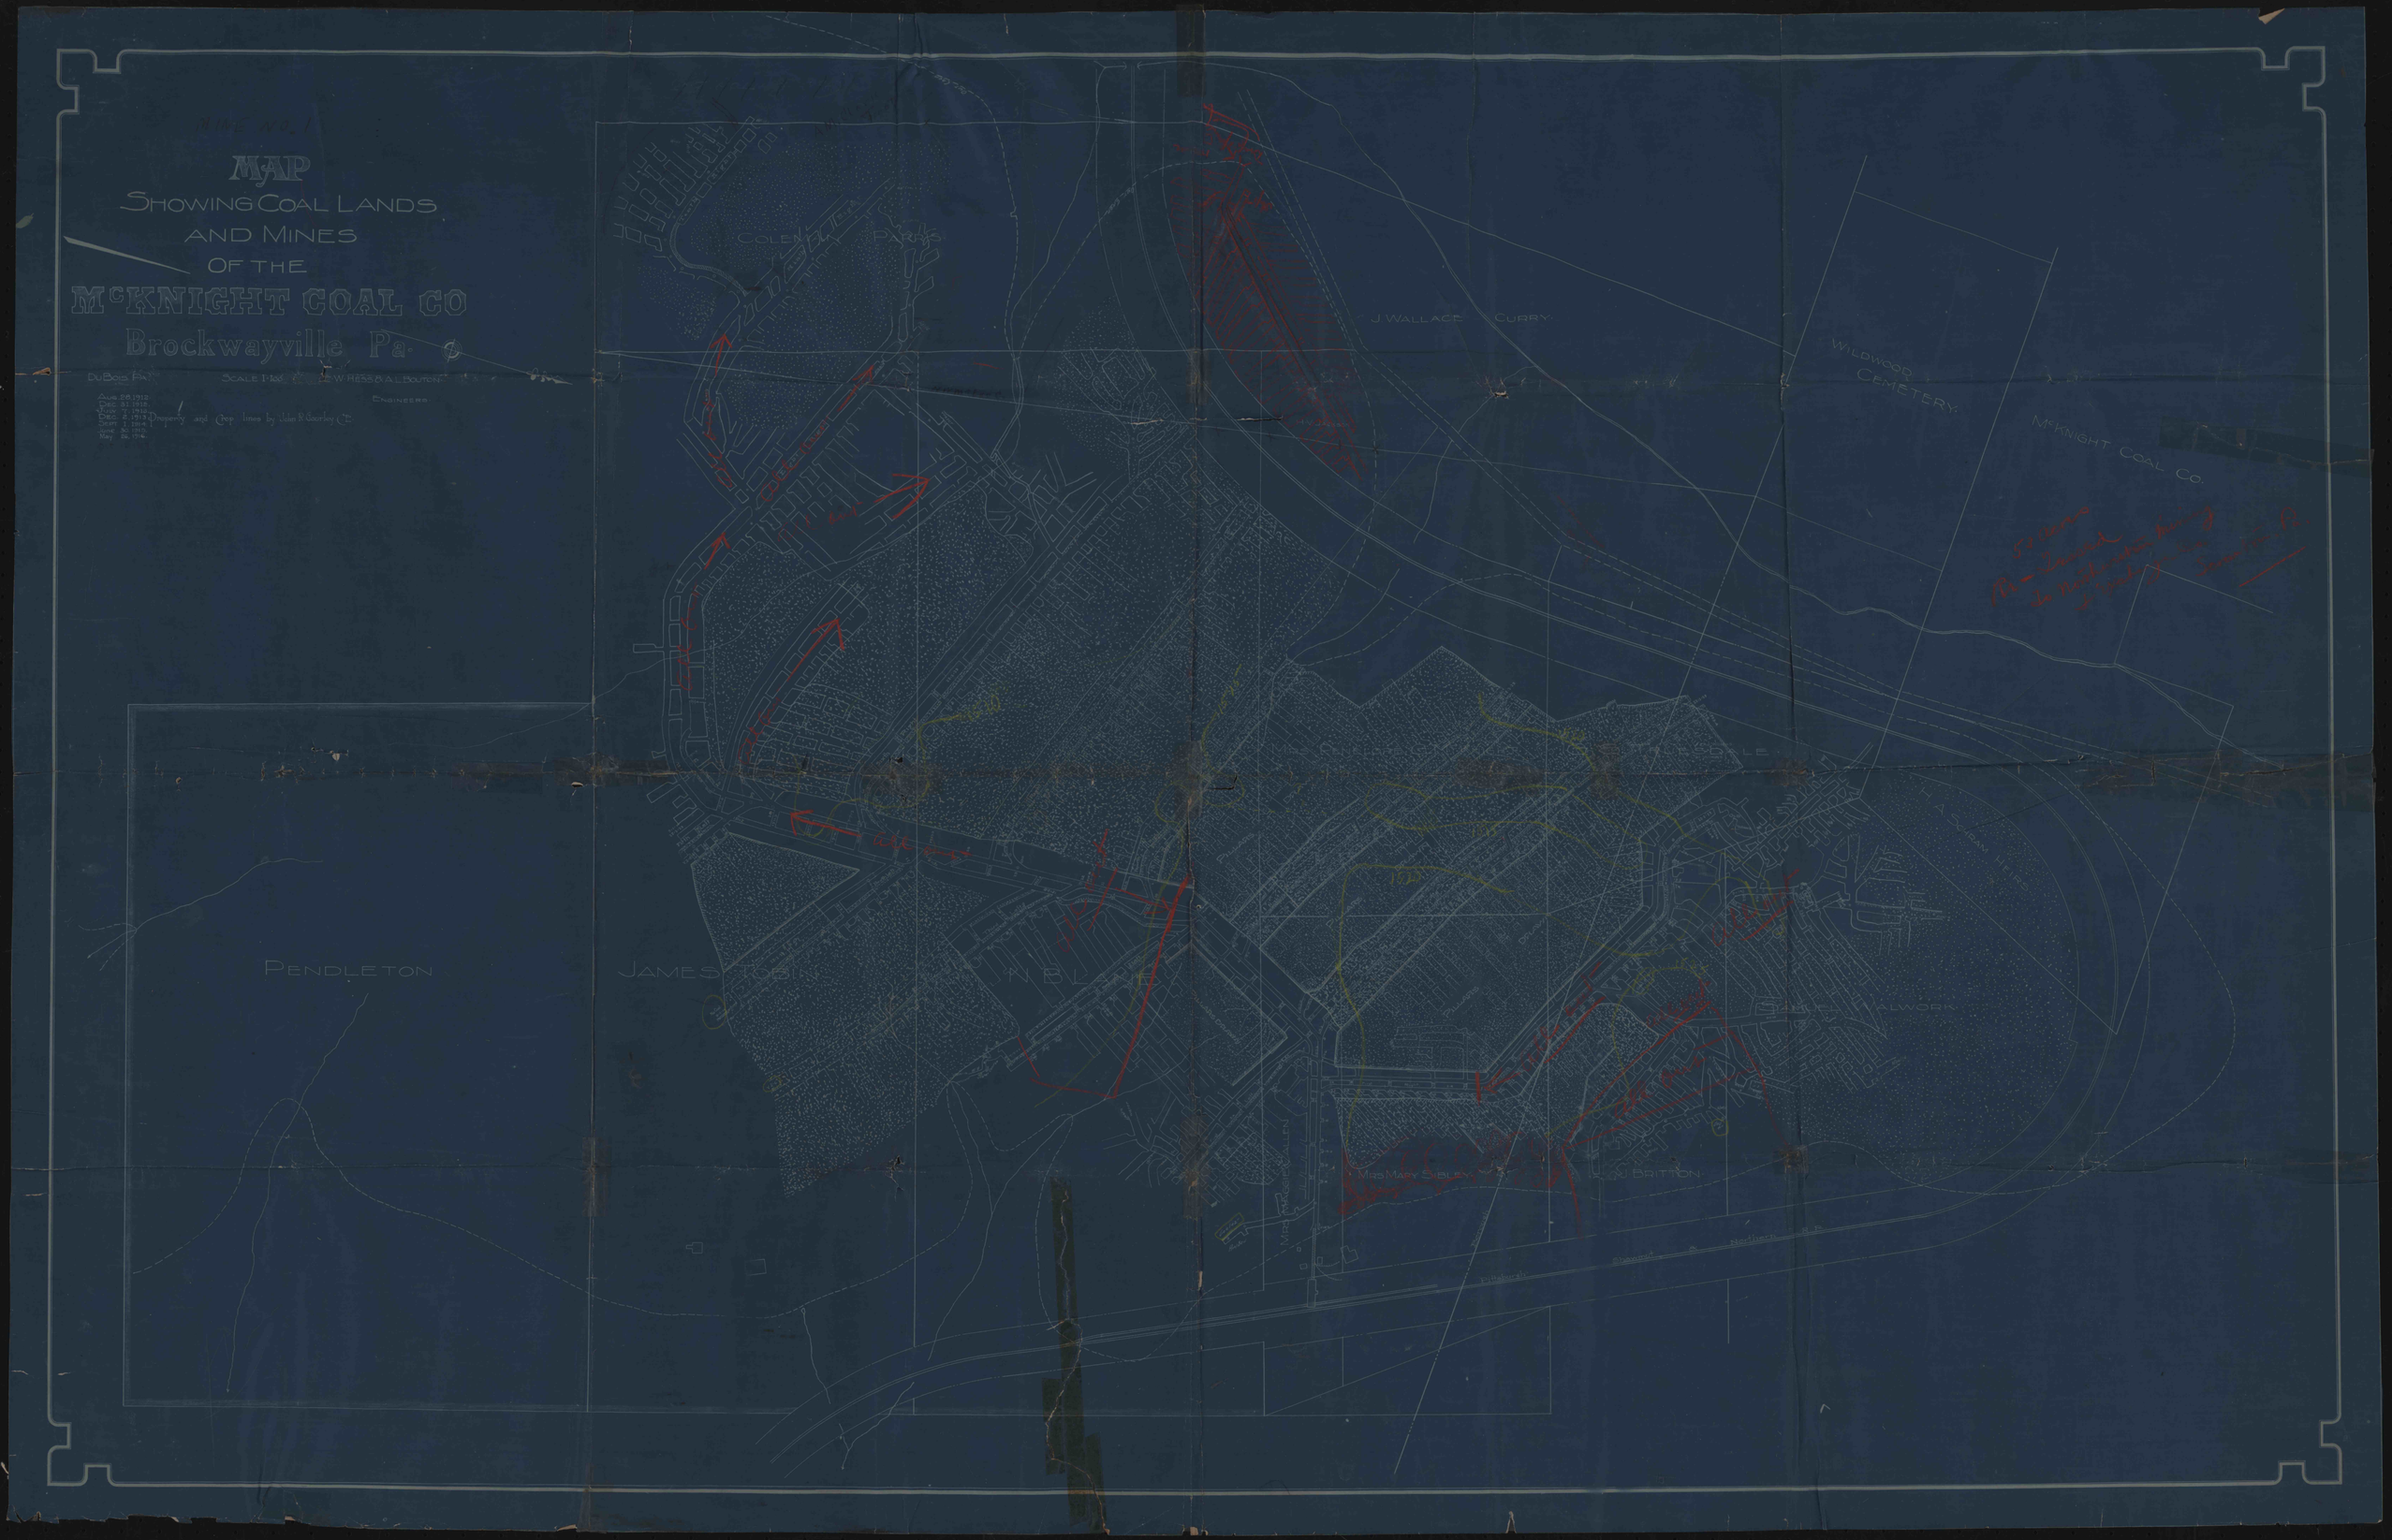
MINE NO. 1
MAP
SHOWING COAL LANDS
AND MINES
OF THE
McKNIGHT COAL CO
Brockwayville Pa.
DuBois Pa.
Scale 1:400
Aug. 28, 1912
Dec. 31, 1912
July 7, 1913
Dec. 2, 1913
Sept. 1, 1914
June 30, 1915
May 26, 1916
Property and Crop lines by John R. Courtley C.E.
Engineers
J. Wallace Curry
Wildwood Cemetery
McKnight Coal Co.
Pendleton
James Tobin
N. B. Lane
Mrs Mary Sibley
J. Britton
Pittsburgh
Shawmut
Northern R.R.