


NORTHWESTERN
MINING & EXCHANGE
MINE

LANE #1
MINE
M'EWEN
RUN C.O.

LANE #3
MINE
M'EWEN
RUN C.O.

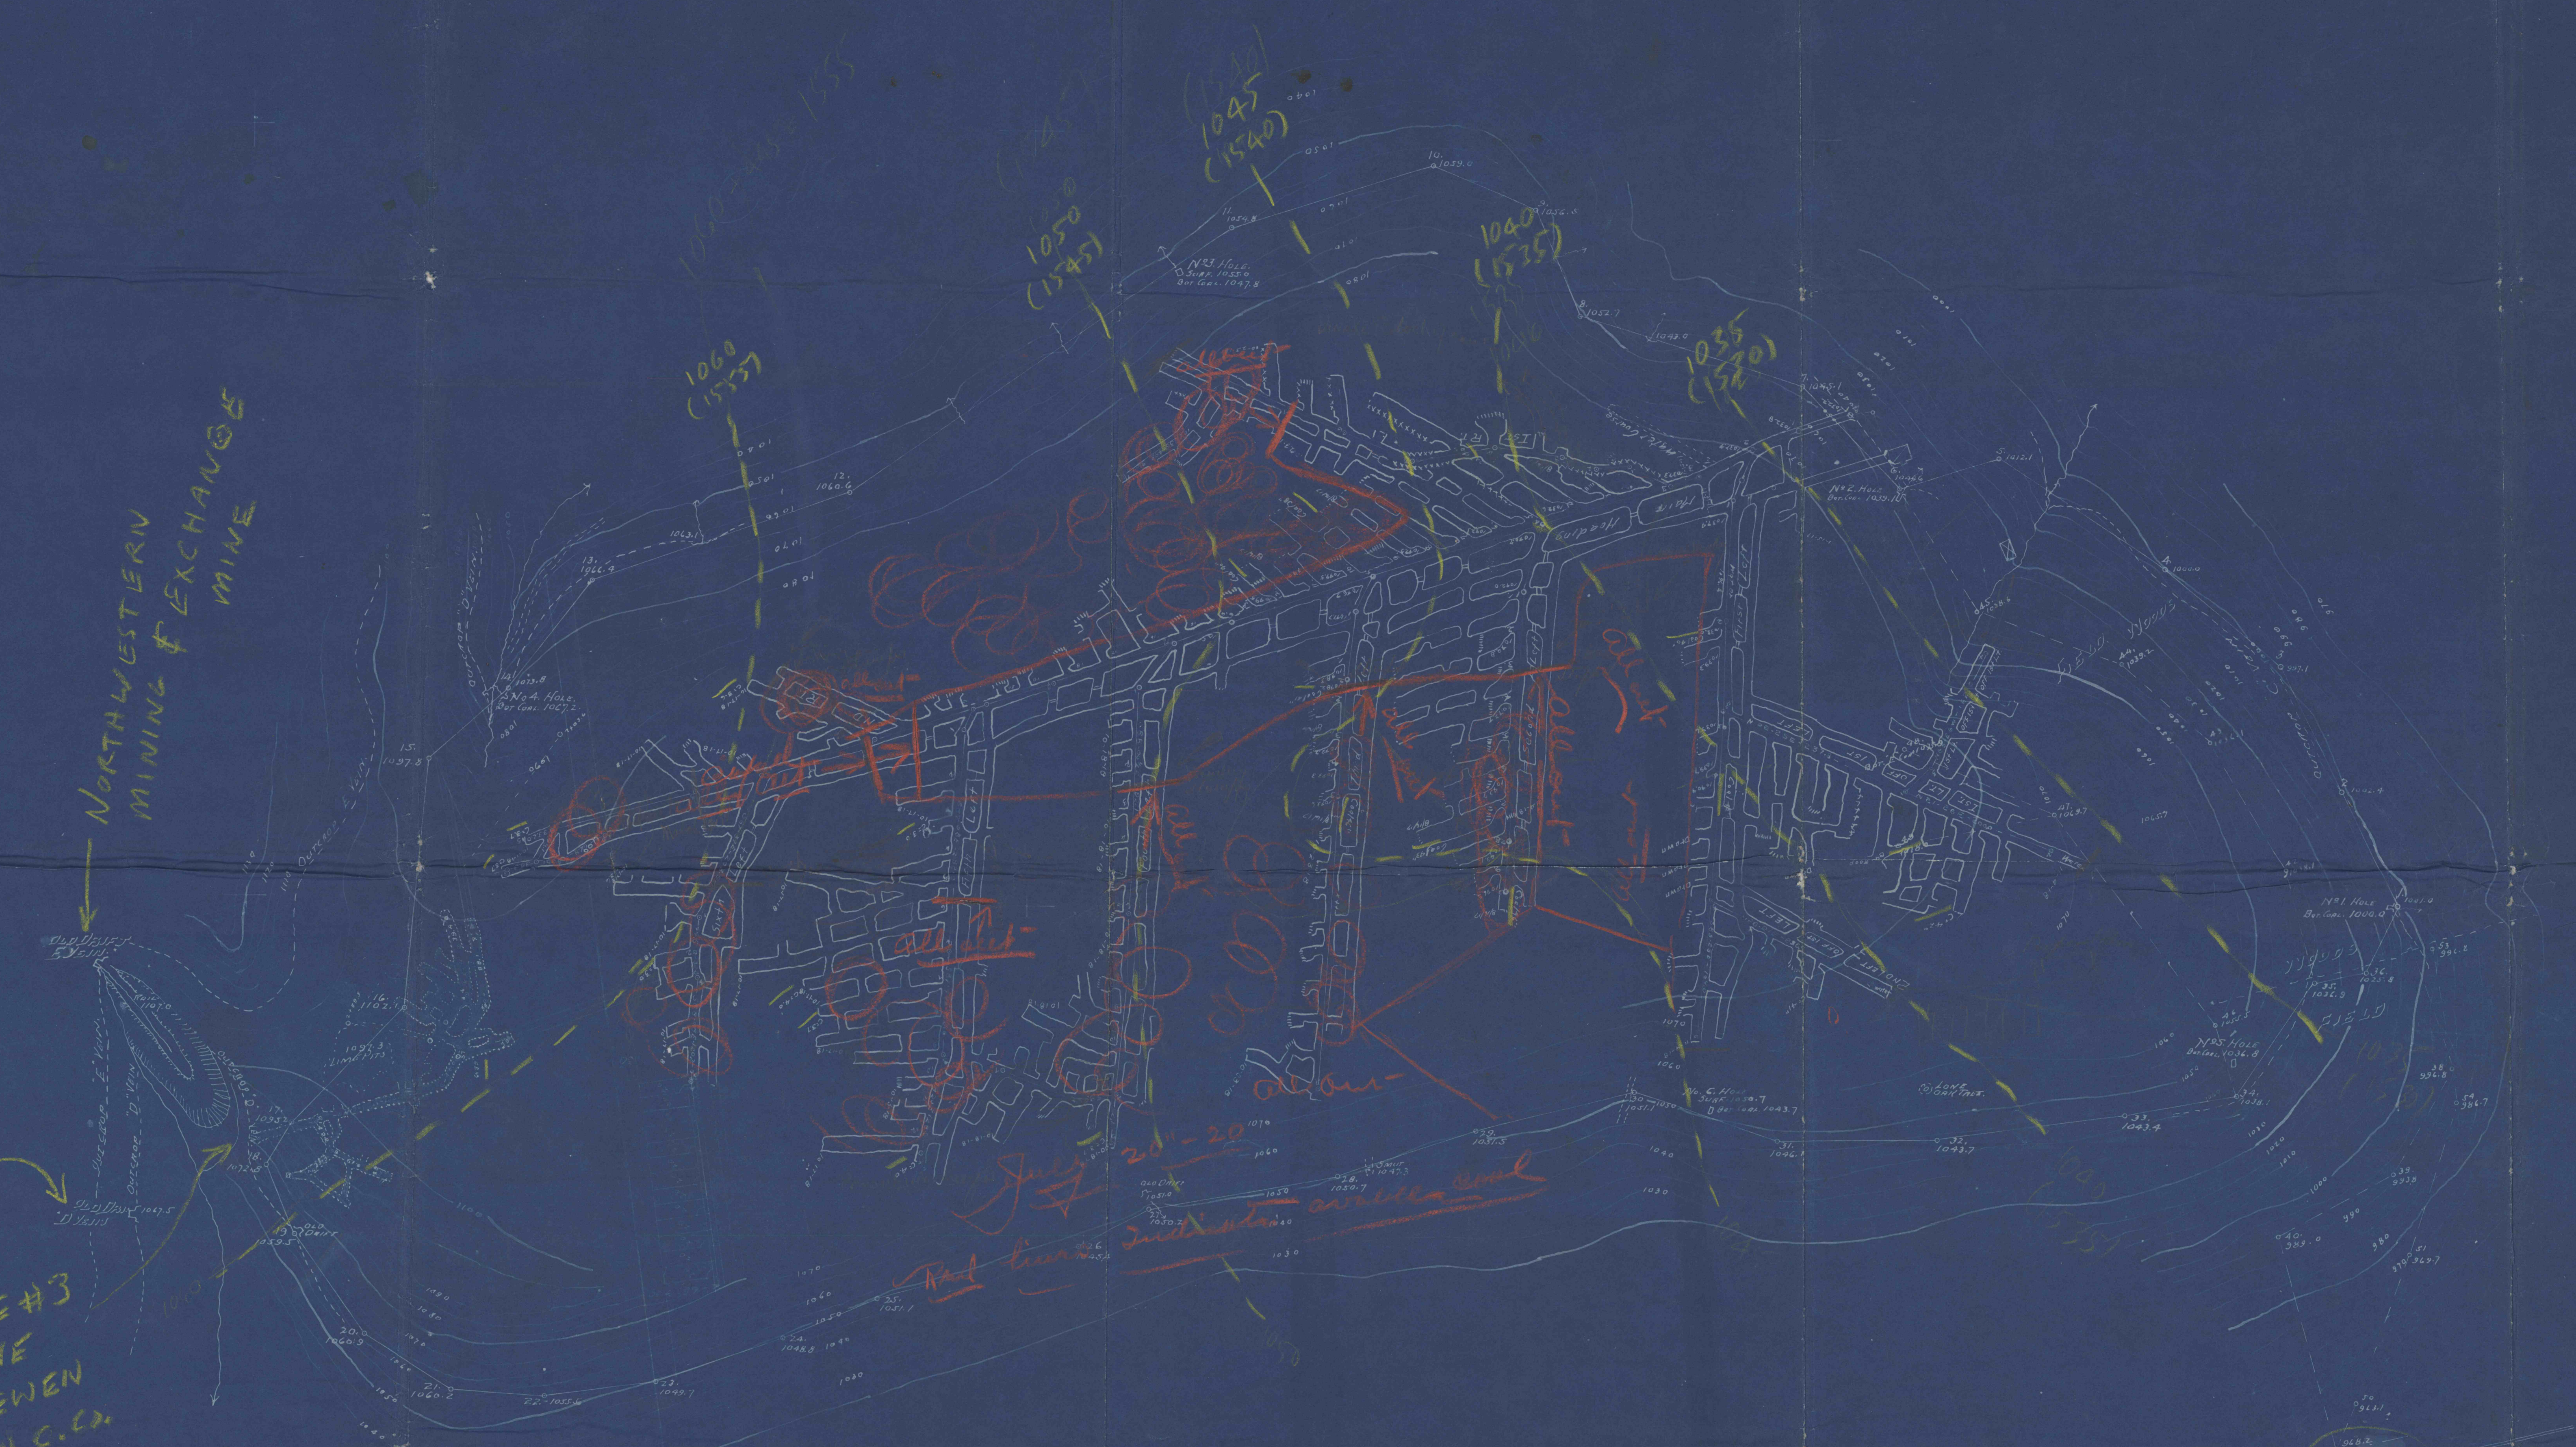

MCKNIGHT COAL CO

MINE No. 2

AT

Brockwayville Pa.

SNYDER TWP, JEFFERSON CO, PA

SCALE 1"=100'

DU BOIS, PENNA. OFFICE OF ENGINEERS.
OCT. 12, 1919. ENGINEERS.
RESURVEYED 7-10-23-1919



APPROX. TRUE ELEVATIONS
= MAP ELEV. + 495'
NEE 1970