


*CHICKADEE*

*FRED H. FINNE*

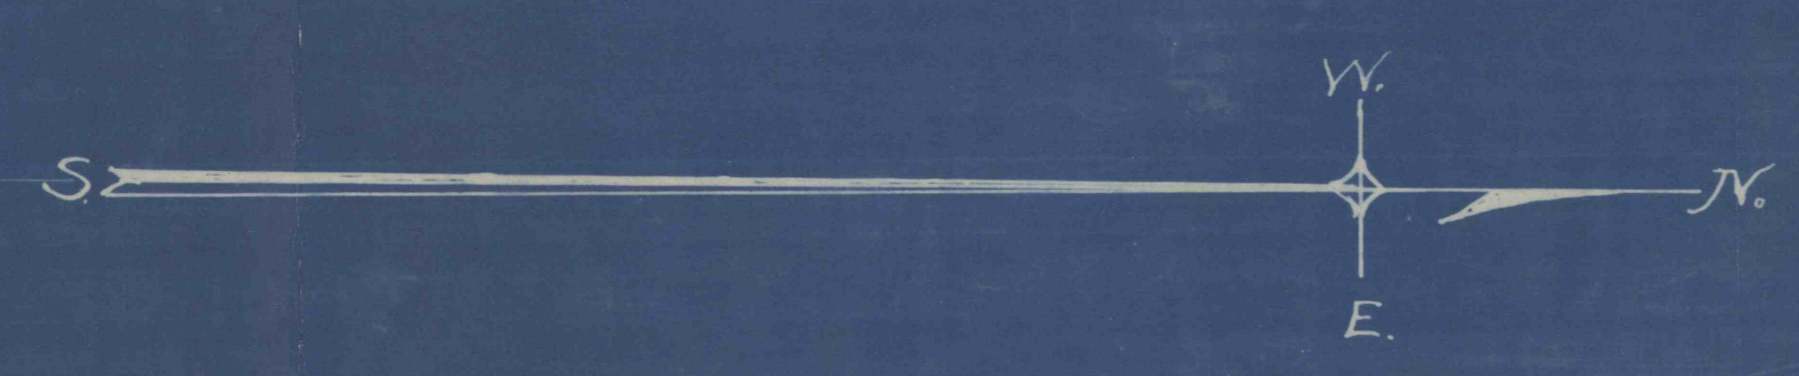

**MCKNIGHT COAL CO**

MINE No. 2

AT

**Brockwayville Pa.**  
 SNYDER TWP. JEFFERSON CO. PA.

SCALE 1"=100'

EDWIN FINNE, ENGINEER  
 OCT. 12-1919  
 RESURVEYED 1917-19-23-1918

FINISHED MAY 6, 1923

*2 1/2 MILES MIN  
 1/2 MILE*

*BRP*