



REVISED  
JULY 8-1968.

PLAN SHOWING PORTION  
MC NAIR MINE  
LEASED TO MC NAIR COAL COMPANY  
JULY 12, 1968  
SPRINGHILLS TXP FAYETTE CO PA


HARAH MINE Nov-1917  
SCALE 1"=100'  
AUG 30-1963. ER DEFORSER, R.R.E.

STATE HWY LR 20083  
TO FAIRMONT

OFFICE COPY

LEGEND  
PERMIT AREA  
CONTINGENTIAL MINING  
7-10-68 - To 1-12-69

SURVEY DATES	
A	4/6/30-1963
B	JUNE 24-1964
C	AUG 19-1966

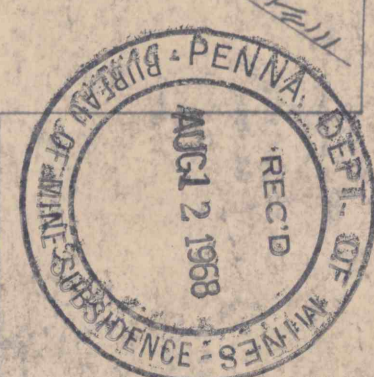

COAL SURFACE OWNED BY FRANK SABATINE.