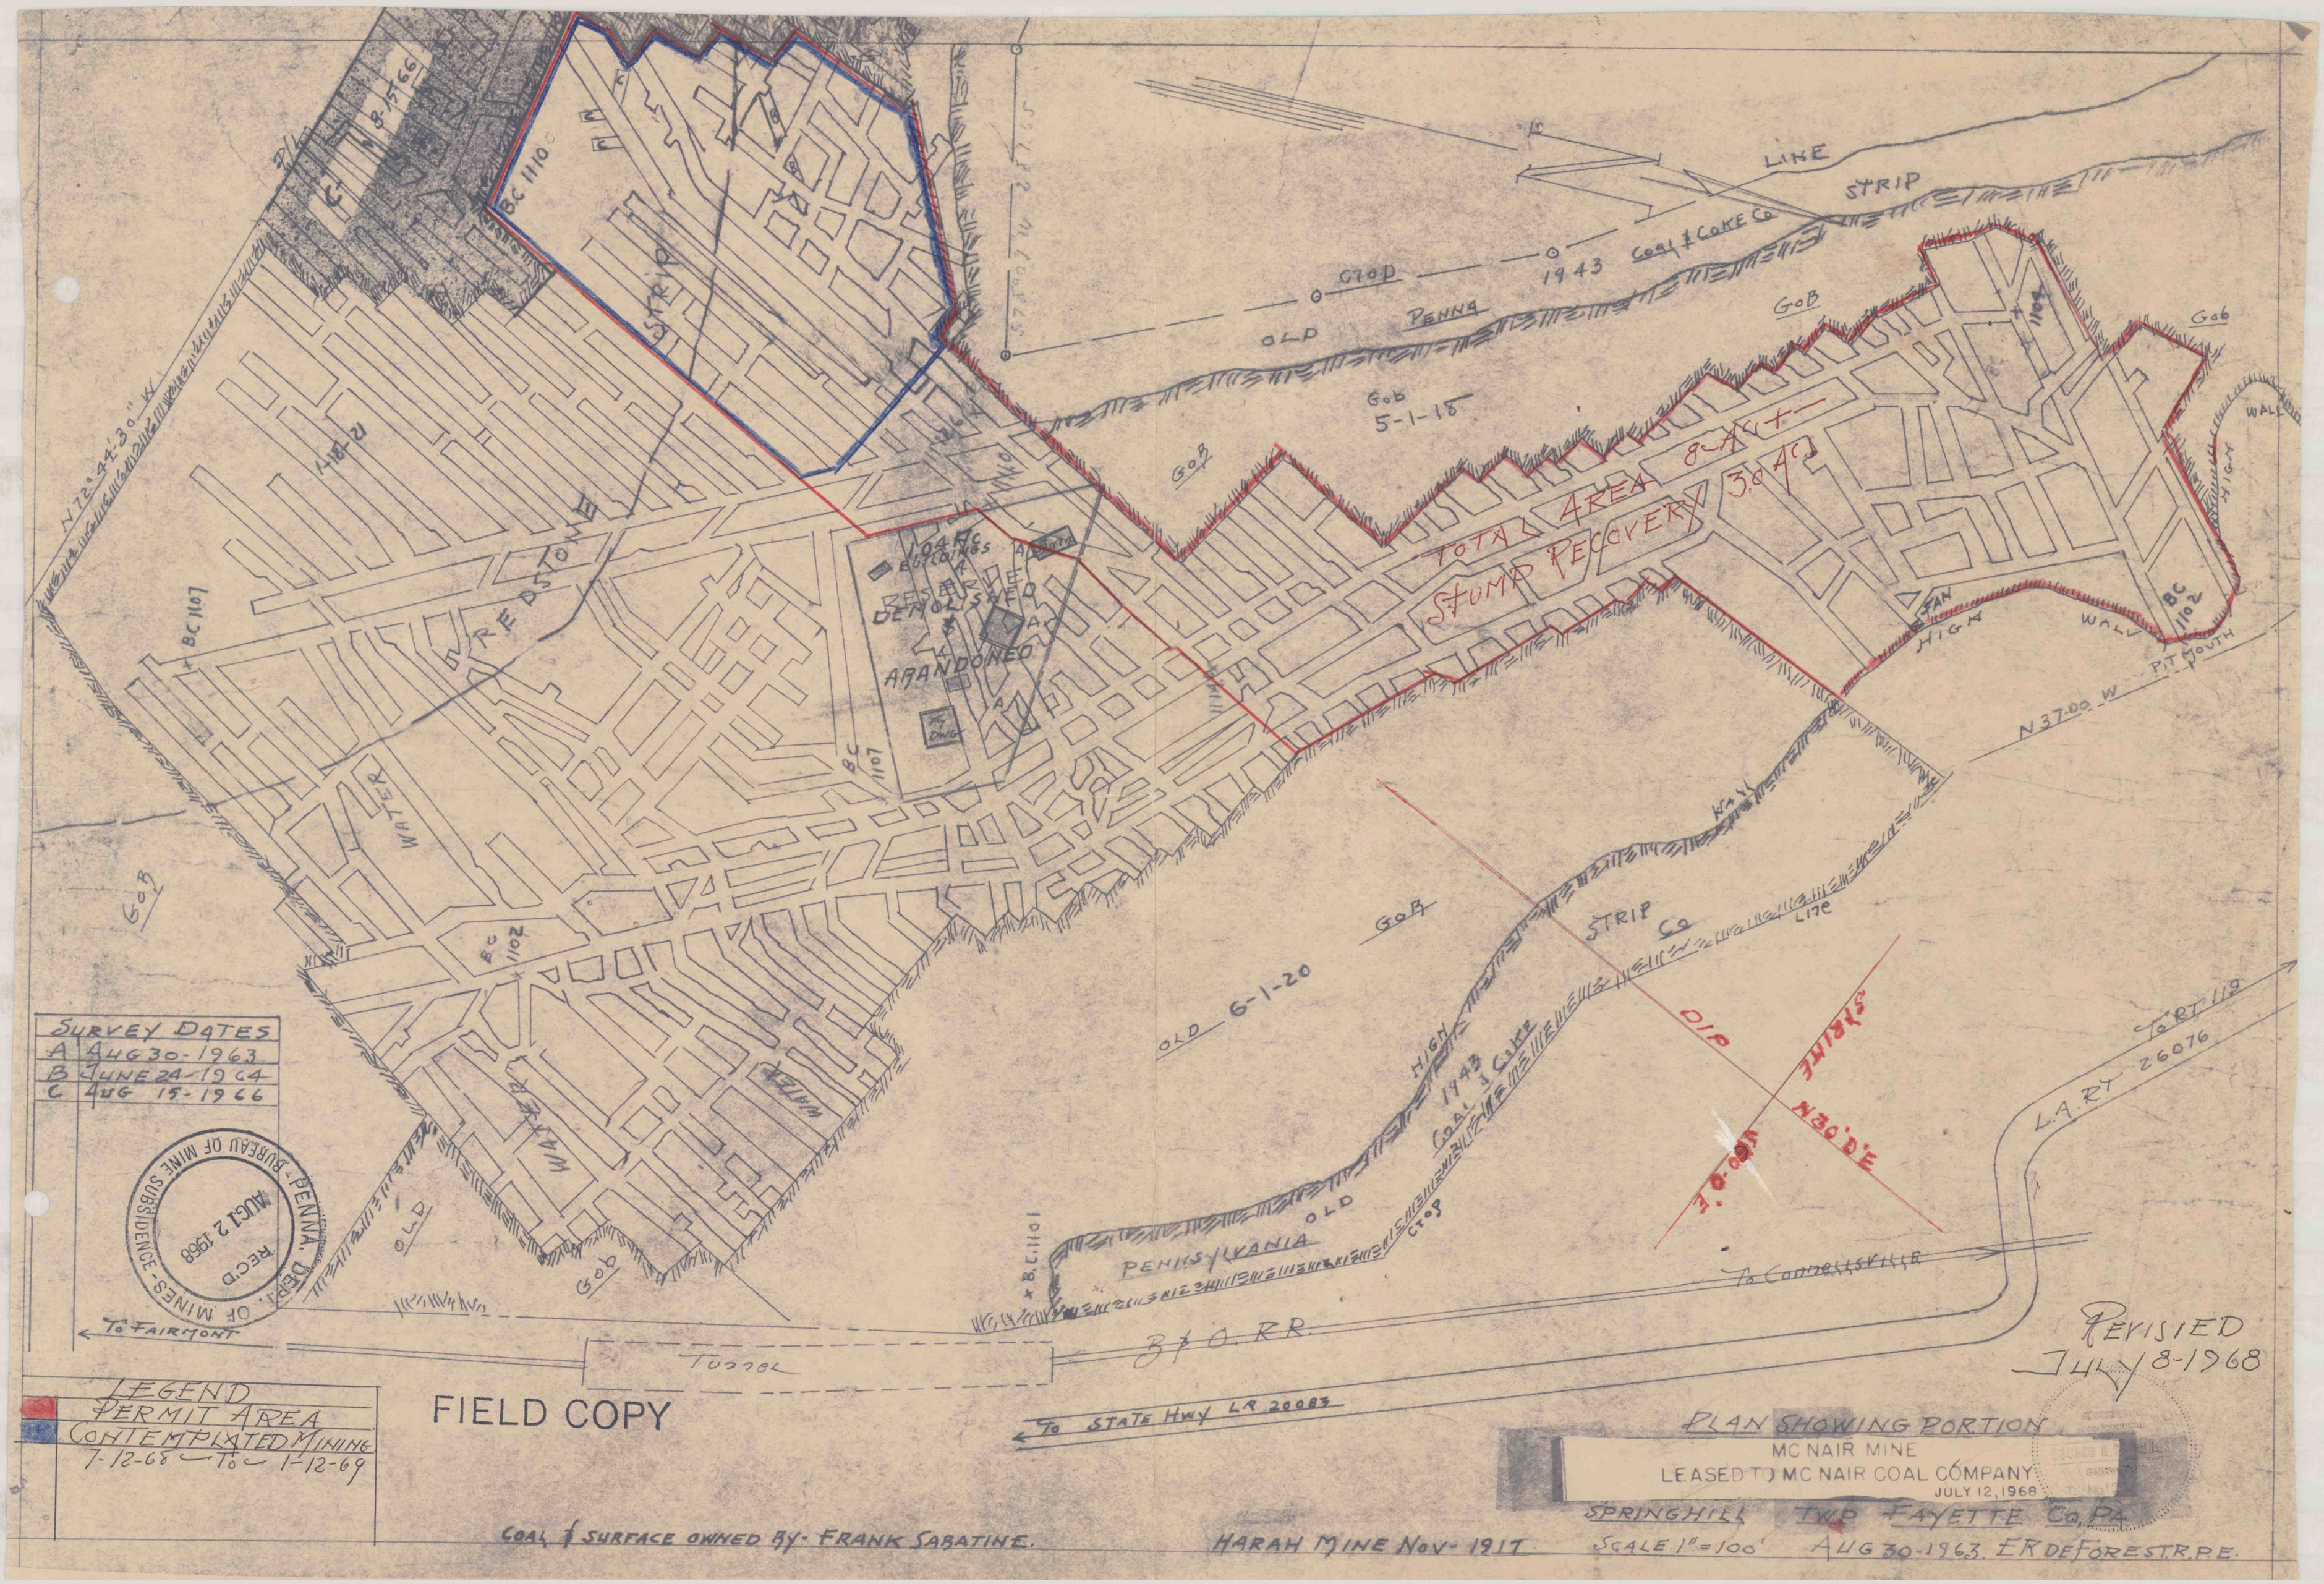

SURVEY DATES	
A	AUG 30-1963
B	JUNE 24-1964
C	AUG 15-1966

PENNA. DEPT. OF MINES - BUREAU OF MINE SUBSIDENCE - REC'D AUG 12 1968

LEGEND
PERMIT AREA
CONTEMPLATED MINING
7-12-68 — To — 1-12-69

FIELD COPY

REVISED JULY 8-1968

PLAN SHOWING PORTION
MC NAIR MINE
LEASED TO MC NAIR COAL COMPANY
JULY 12, 1968

SPRINGHILL TWP FAYETTE Co. PA

COAL & SURFACE OWNED BY - FRANK SABATINE.

HARAH MINE NOV - 1917

SCALE 1" = 100'

AUG 30-1963. E R DEFOREST R.P.E.