

FRED RAPACH

A.G. HUGHMANIC

FRED RAPACH

WADE BERKEYPILE

FRED RAPACH

25 DEGREE GUIDE
SOLID COAL
NO MINING
50% MINING ZONE
290' COVER

25 DEGREE GUIDE
SOLID COAL
NO MINING
50% MINING ZONE
280' COVER

25 DEGREE GUIDE
SOLID COAL
NO MINING
50% MINING ZONE
230' COVER

SOLID BLOCK
NO MINING

J.E. LITTLE

H.L. DEABENDORFER

PENNSYLVANIA ELECTRIC COMPANY



LEGEND

○ CONTINUOUS MINER	○ FAN MOTOR
○ BRIDGE CONVEYOR	○ ROCK DUSTER
○ LO-LO BELT HEAD	○ ROOF BOLTER
○ BELT HEAD	○ BATTERY MINE TRACTOR
○ PERMANENT PUMP	○ LOCOMOTIVE
○ CUTTING MACHINE	○ ESCAPEWAY
○ AUXILIARY FAN UNIT	○ CIRCULAR WALL FEED LINE

LEGEND

→ INTAKE AIR	→ RETURN AIR
— SEAL	— PERMANENT STOPPING
— TEMPORARY STOPPING	— TEMPORARY STOPPING - BRATTICE CLASH
— LINE BRATTICE	— CHECK CURTAIN
○ REGULATOR	× OVERCAST
— PERMANENT DOOR	— TEMPORARY DOOR

M.Y. COAL COMPANY
M.Y. NO. 1 MINE
CHERRYHILL TWP. - INDIANA CO. PA.
 LOWER KITTANNING COAL SEAM
 SCALE 1" = 100' - SURVEY DATE Nov 15-22 PERMIT NO. 371-1
 JOHN C. PASSMORE - SURVEYOR DRAWING BY G.R.G.
 Contemplated mining _____ to _____
 6 month extraction _____ to _____
 Revised additions _____
 SIGNED: *John C. Passmore*
 R.S. NO. 8491 SEAL

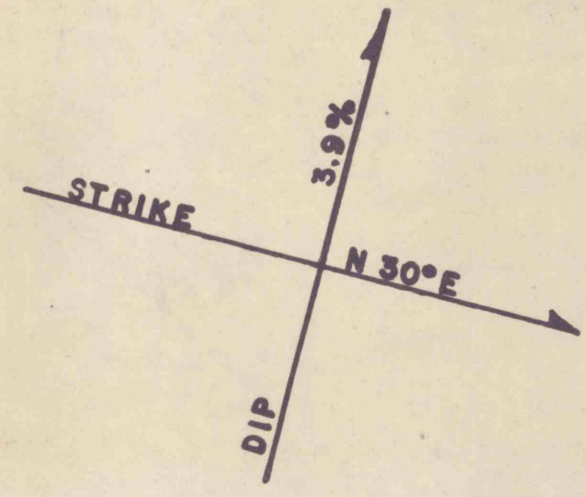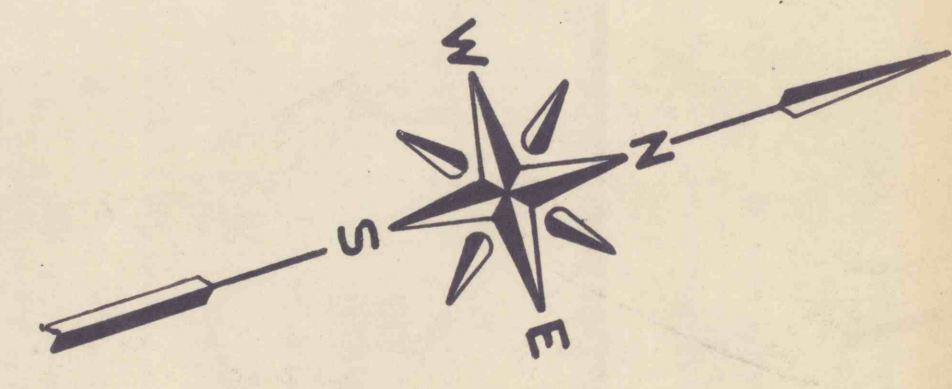

