

D.D.M. 53
304-140.84
87-97.07


A. DEEMER

R. CONRAD

P. WAGNER

D. WOODSIDE

H. LOWMAN

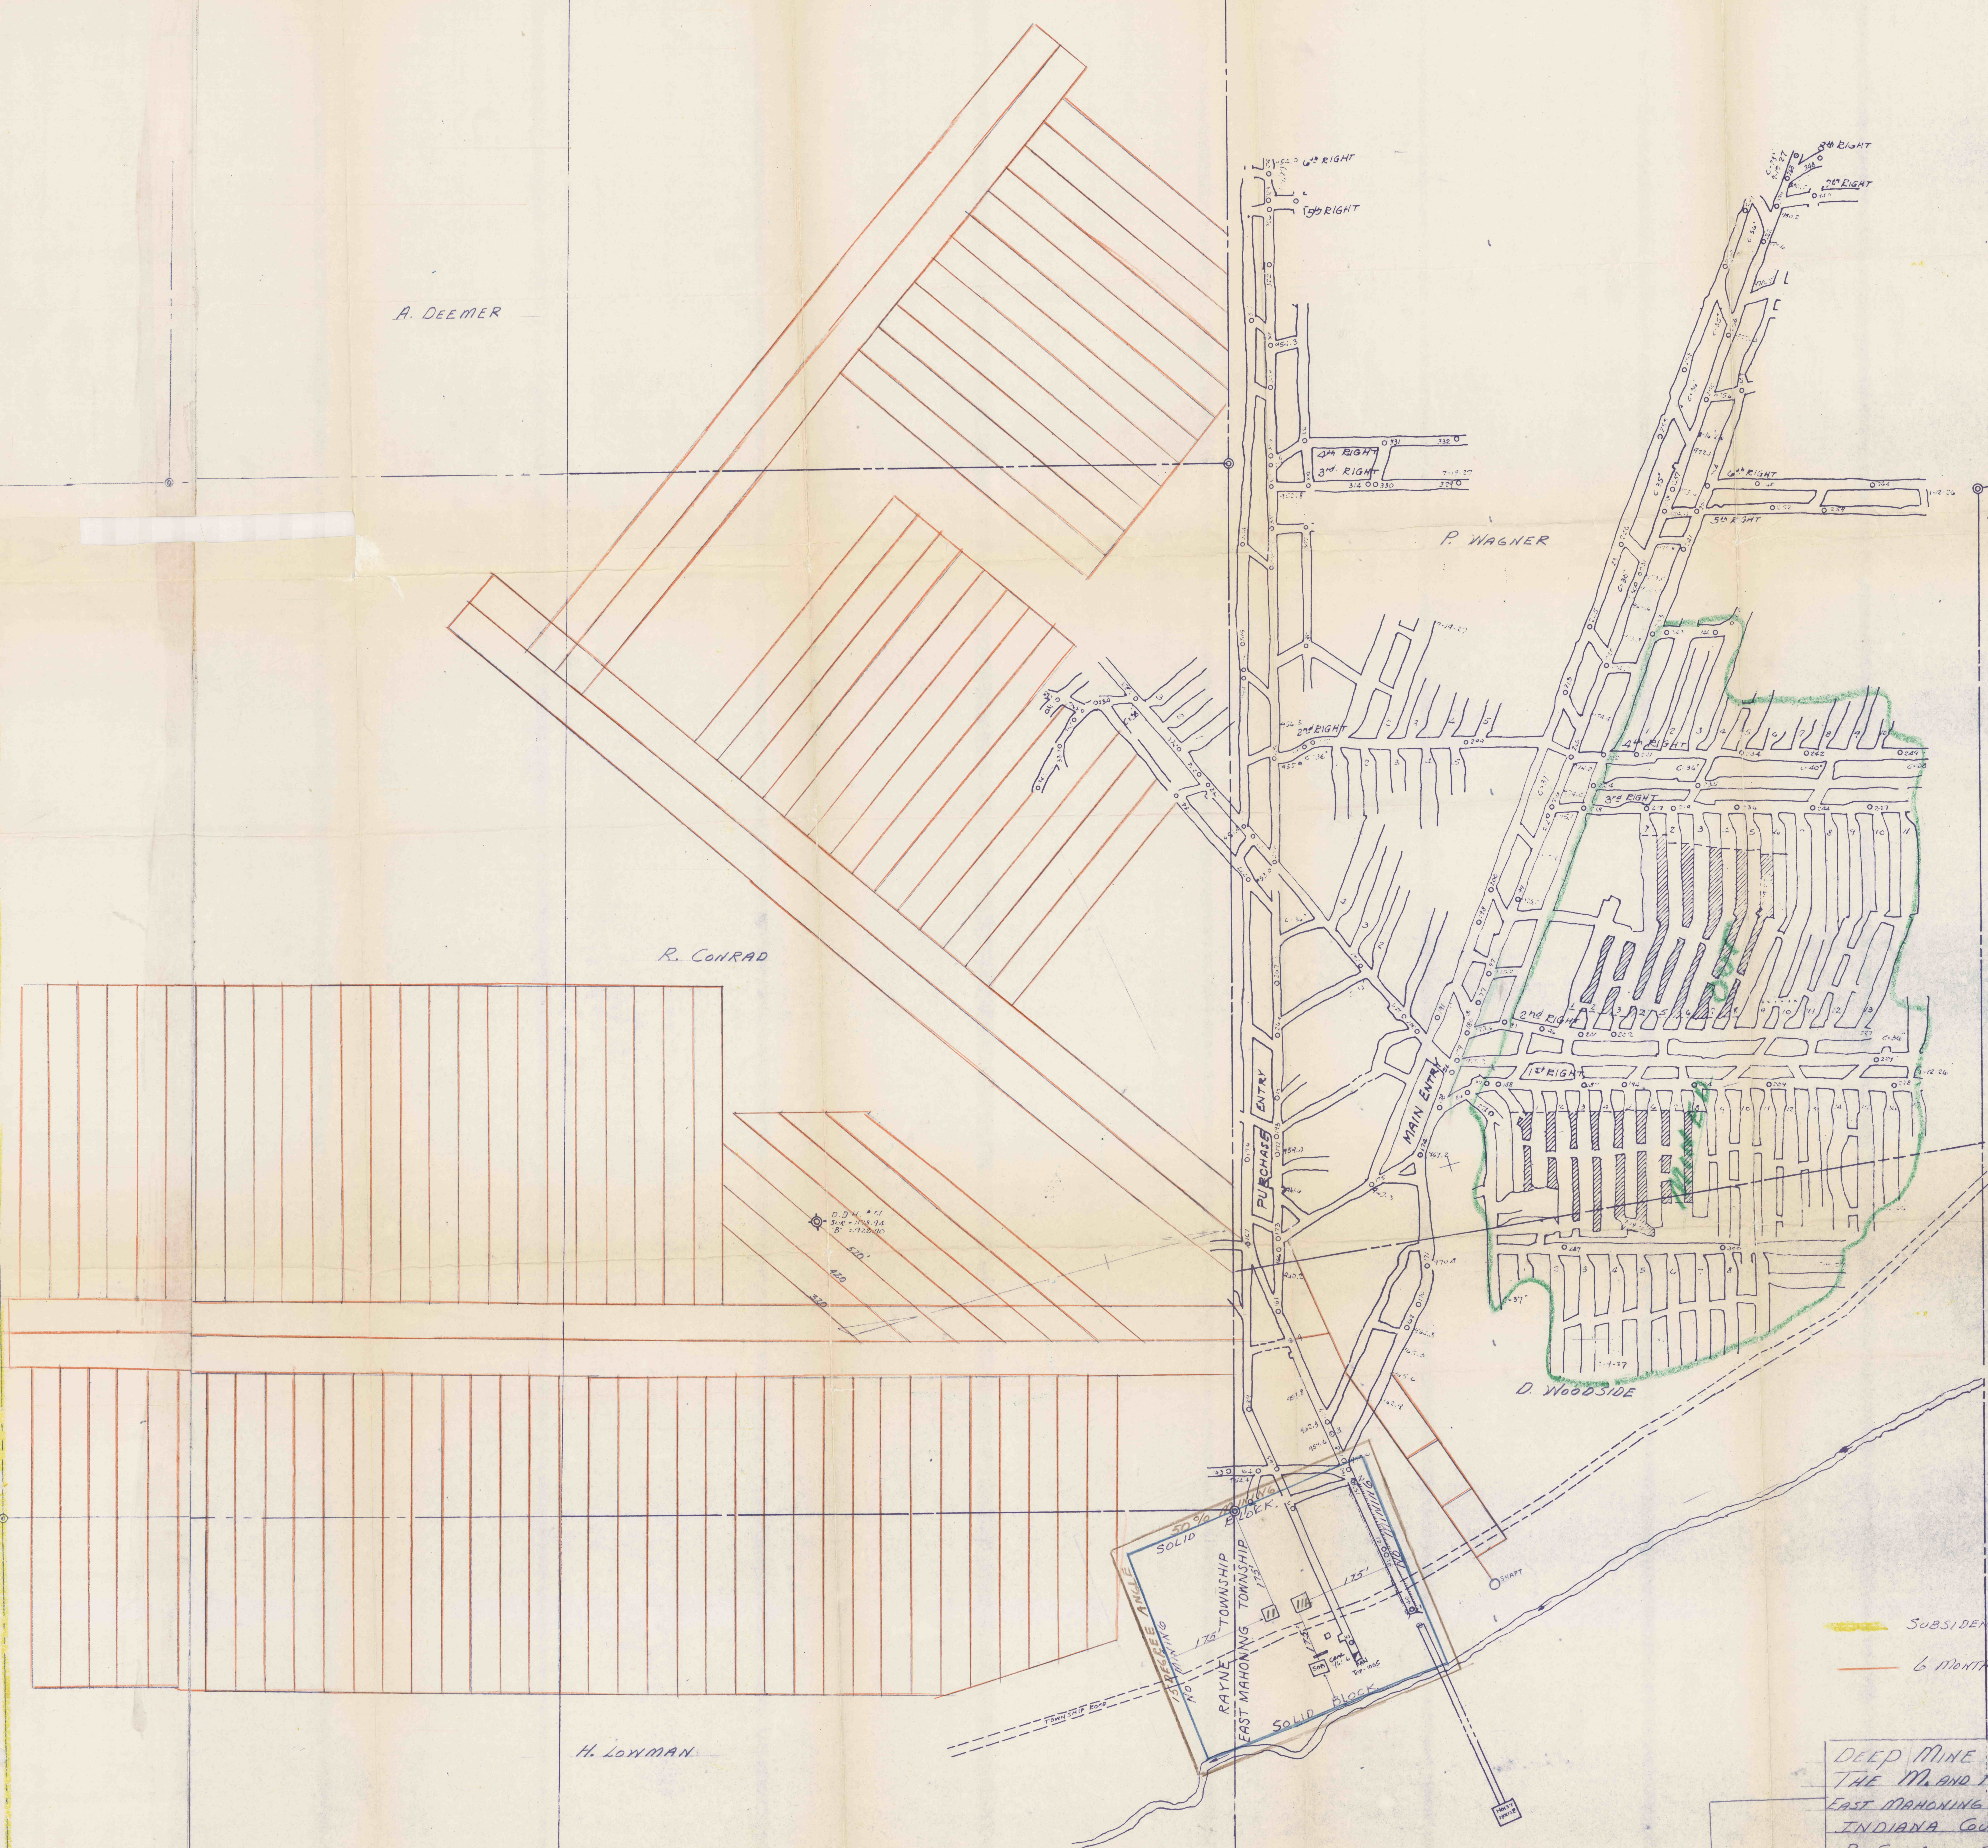

- SUBSIDENCE BOUNDARY
- 6 MONTH PROTECTION
- FIELD COPY

DEEP MINE PROPERTY MAP
 THE M. AND K. COAL COMPANY
 EAST MAHONING AND RAYNE TOWNSHIPS
 INDIANA COUNTY, PENNA.
 B-SEAM SCALE - 1" = 100'
 DRAWN BY - A.K.B. AND J.C.P.