

STATE HIGHWAY ROUTE # 56

E. STEWART


APPROX. OUTCROP

MACK No 5 MINE
CENTER TWP INDIANA CO.
SCALE 1" = 100'

I hereby certify this to
be a true and correct
copy of the map showing
all workings and excavations
of the Mack No 5 Mine

S. W. Duke

PROBABLY CROP

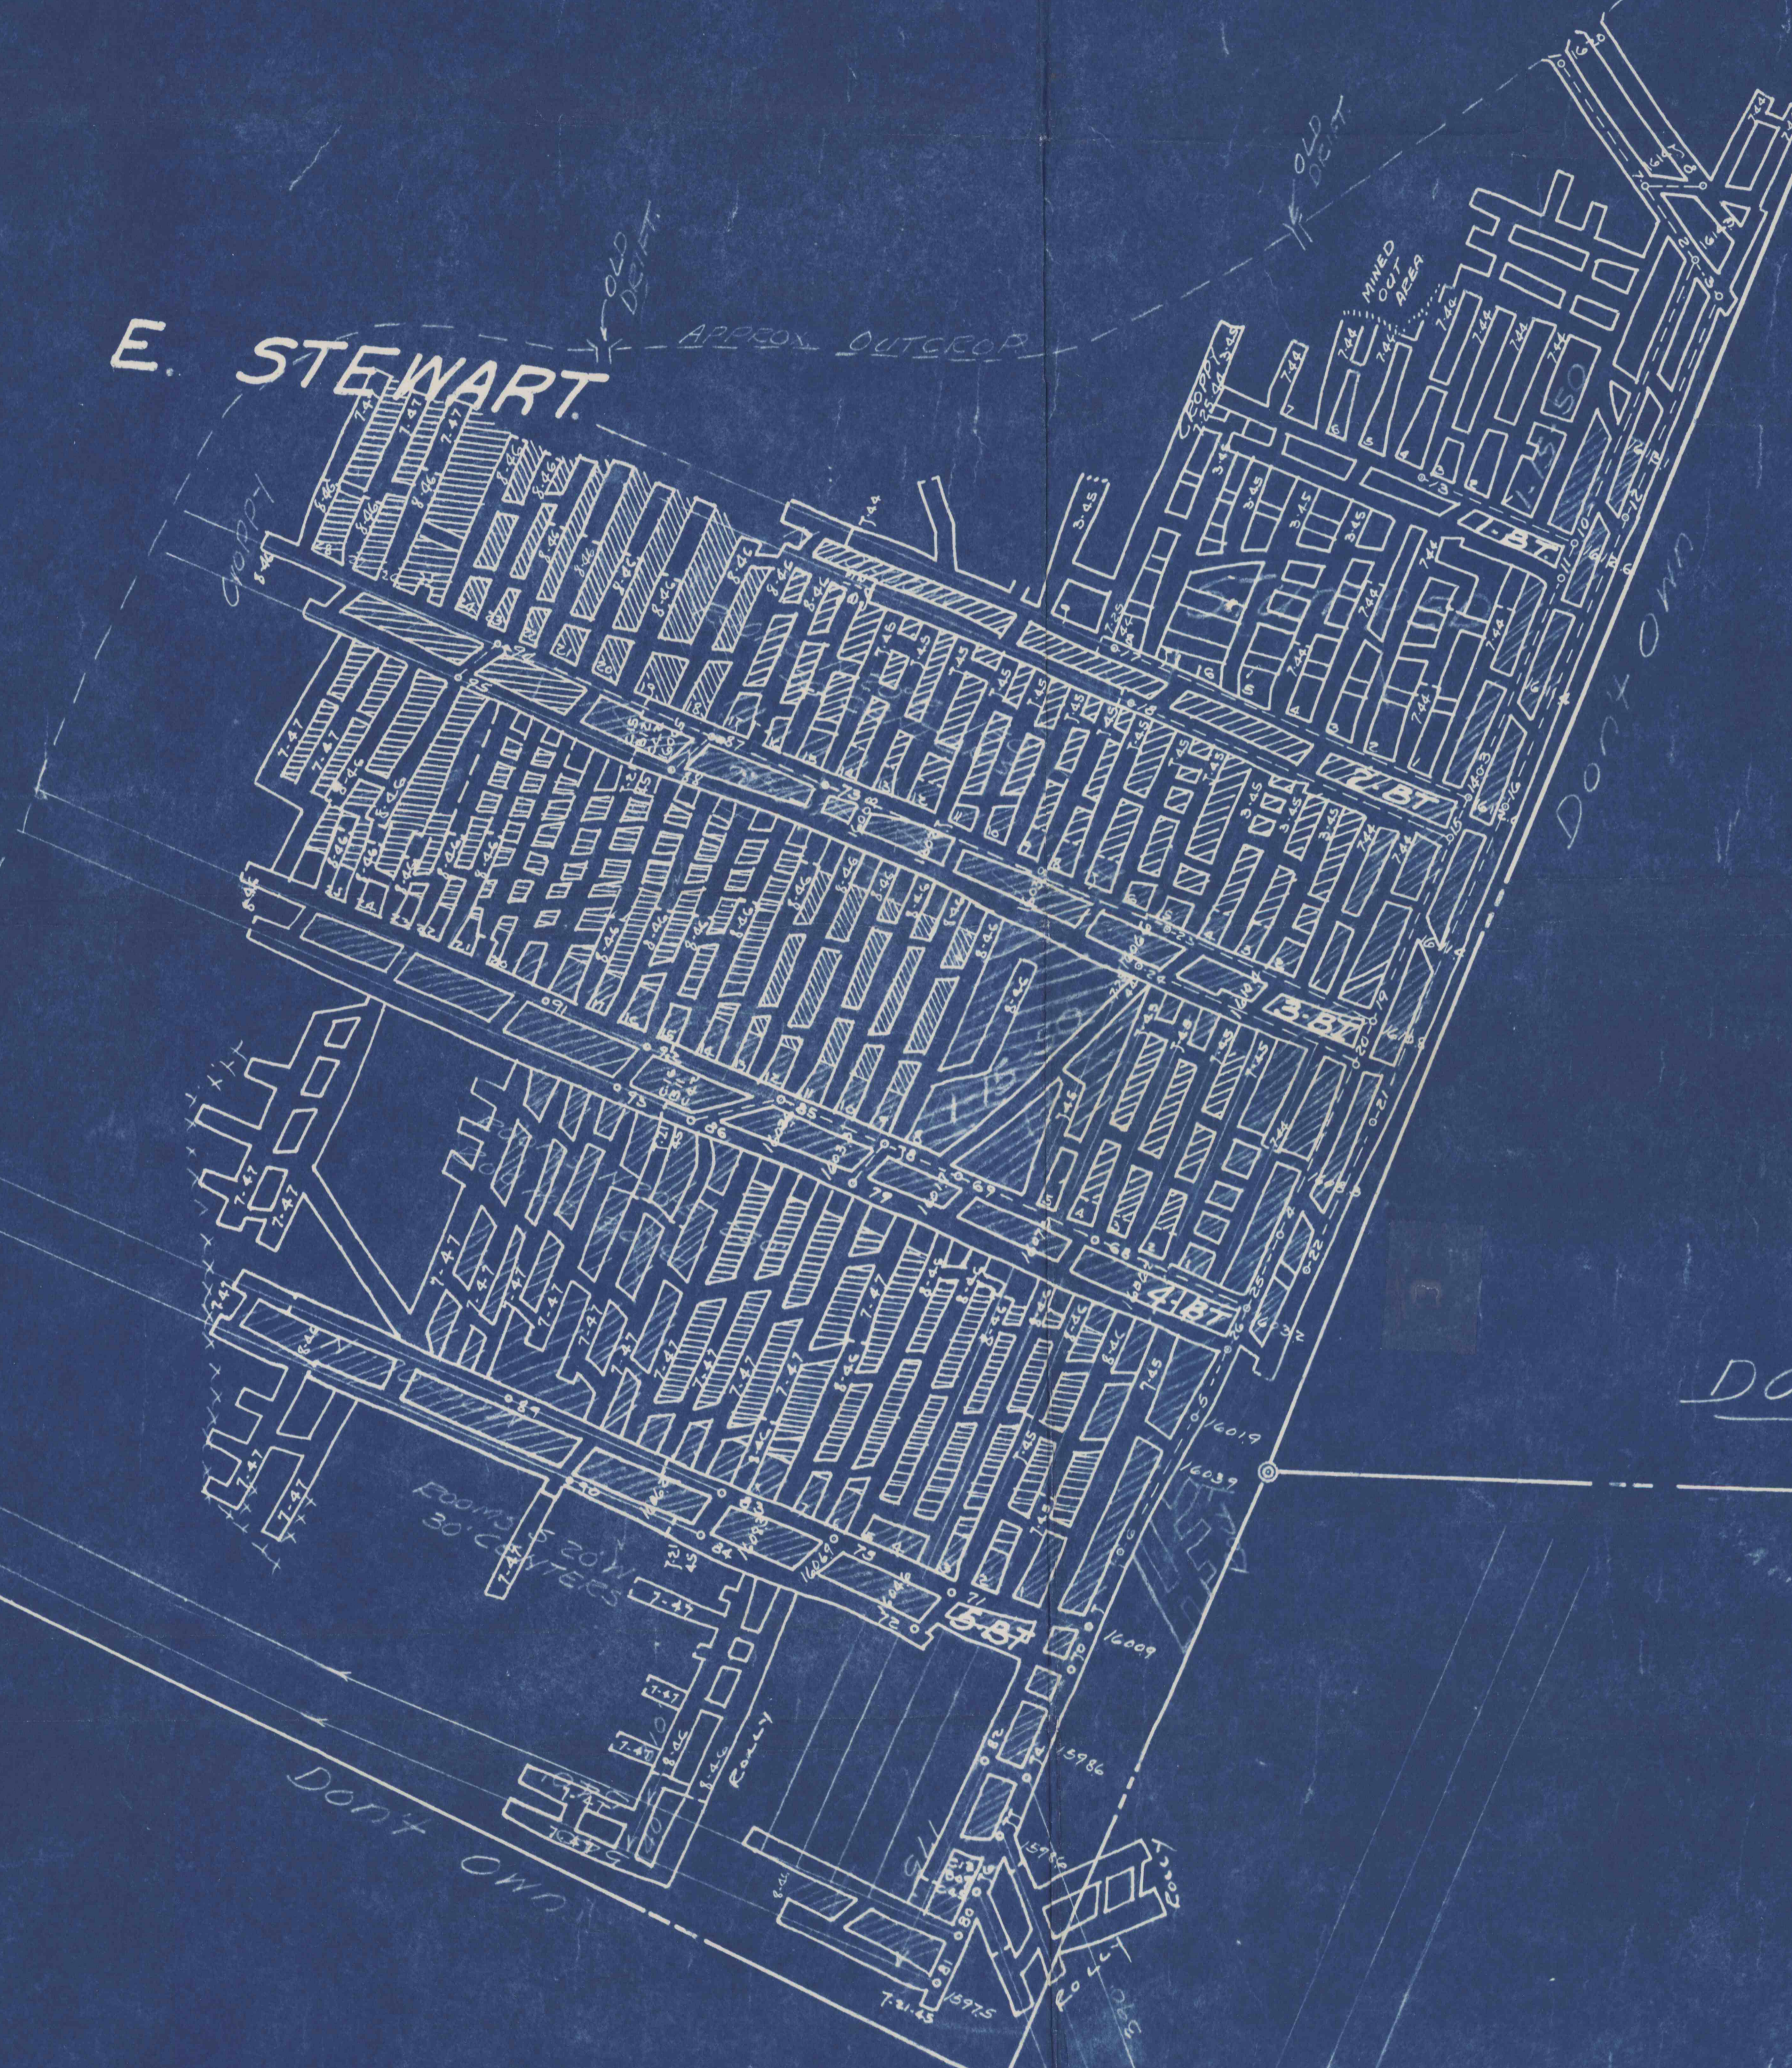

Dont own

Dont own

500
400
300
200
100