


10-11
10-12

10-13
10-14

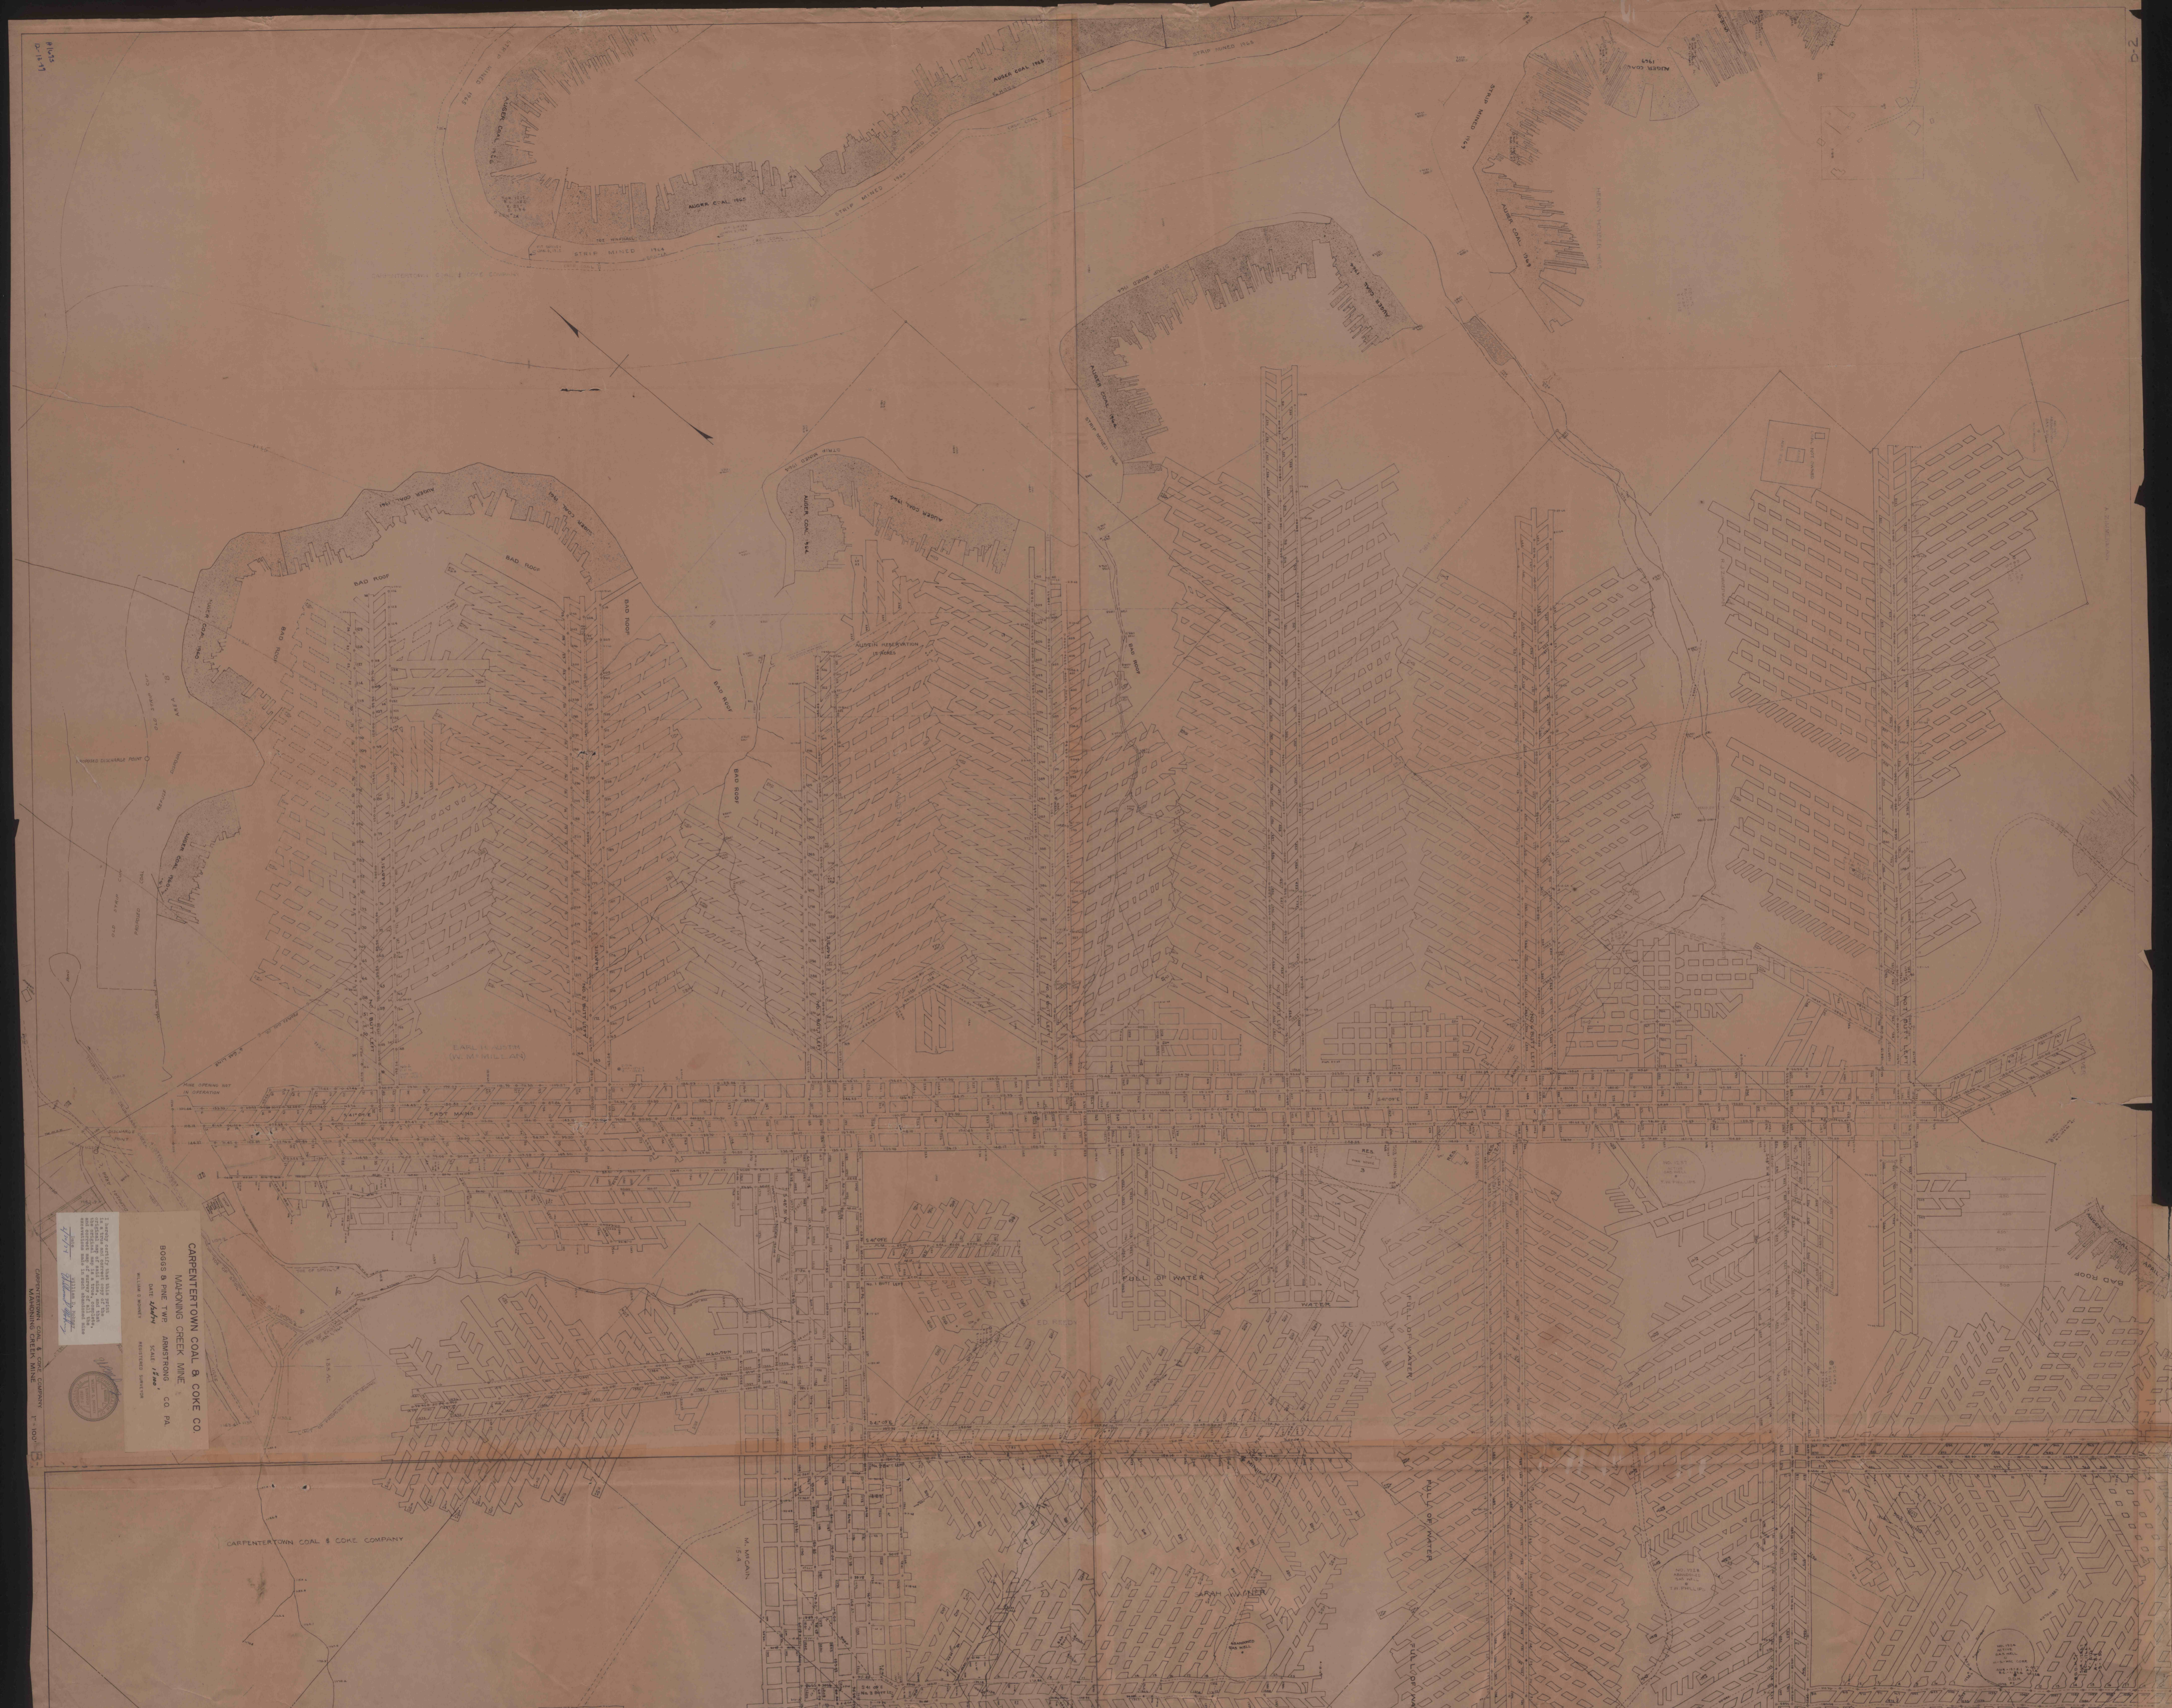

CARPENTERTOWN COAL & COKE CO.
 ARMSTRONG CO PA
 SOIL 'Foss'
 REGISTERED SURVEYOR
 1911

CARPENTERTOWN COAL & COKE COMPANY
 1911



CARPENTERTOWN COAL & COKE COMPANY

