

D. HOLSOPLLE—PHONE 478 7474

EVAN BILEY—PHONE 478 7104

COMMONWEALTH OF PENNSYLVANIA
DEPARTMENT OF MINES AND
MINERAL INDUSTRIES
HARRISBURG
APR 24, 1967

MANION COAL COMPANY, Inc.
Quality "C" Prime Coal

HOLSOPLLE, PENNA.

Mr. B. B. Lippert
May 1, 1967

Pennsylvania Department of Mines
Bureau of Mine Safety
Harrisburg, Pa.

Dear Sir:
In accordance with section 240 Page 59 and 60 of
the Bituminous Mining Law of Pennsylvania, we are send-
ing you under separate cover a certified print of
Map of 1 Co. Mine-92 Joint Prop. Survey 20, Penna.
which mine was abandoned May 1, 1967.

Yours Truly,
Don B. Holsofle

Mr. B. B. Lippert
Pennsylvania Department of Mines
Bureau of Mine Safety
Harrisburg, Pa.
I have your letter of May 1, 1967 regarding
your abandoned mine map which was received in this office
on May 1, 1967. The map is being processed by the
Bureau of Mine Safety, Harrisburg, Pa. The map
will be filed in the file of abandoned mines.
Very truly yours,
E. J. Gresham
Director of Mines and
Mineral Industries


cc: Mr. B. B. Lippert
Mr. J. J. Lippert

OFFICE MEMORANDUM DATE 5/25/67
TO: Mr. Ralph A. Lippert
FROM: E. J. Gresham
Please arrange to have the attached
abandoned mine map received from Manion Coal
Company, Inc. filed.
DATE - 5/25/67
FILED



I HEREBY CERTIFY THIS TO BE A TRUE AND CORRECT
MAP TO THE BEST OF MY KNOWLEDGE AND BELIEF
SIGNED *Don B. Holsofle* 5/25/67

MANION COAL CO. INC.
MINE NO. 2
B. B. LIPPERT, SUPERVISOR
PRINTED BY: [illegible]
SCALE: 1"=100'
MAY 7, 1967

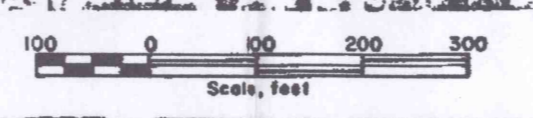

PDVMS 02052 454 32Y 318617

1701

1701