




Manor Eight  
Washington Twp  
Indiana Co.

1" 200'  
Dated 3/21/81

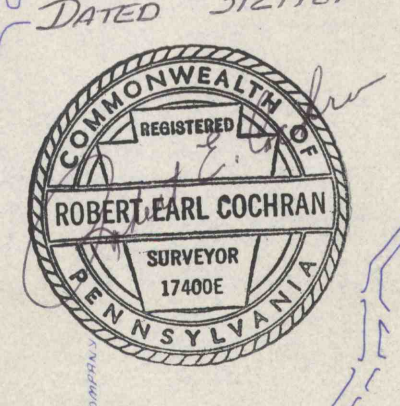

THE MINE WORKINGS IN THIS AREA DOES NOT AGREE  
WITH WORKINGS SHOWN ON ADJACENT MINE MAP.

O'Donnell 4 - Was Manor 8  
R & P Coal Co.

Cabinet M  
Drawer 3

#1702  
12-13-99  
C.C.