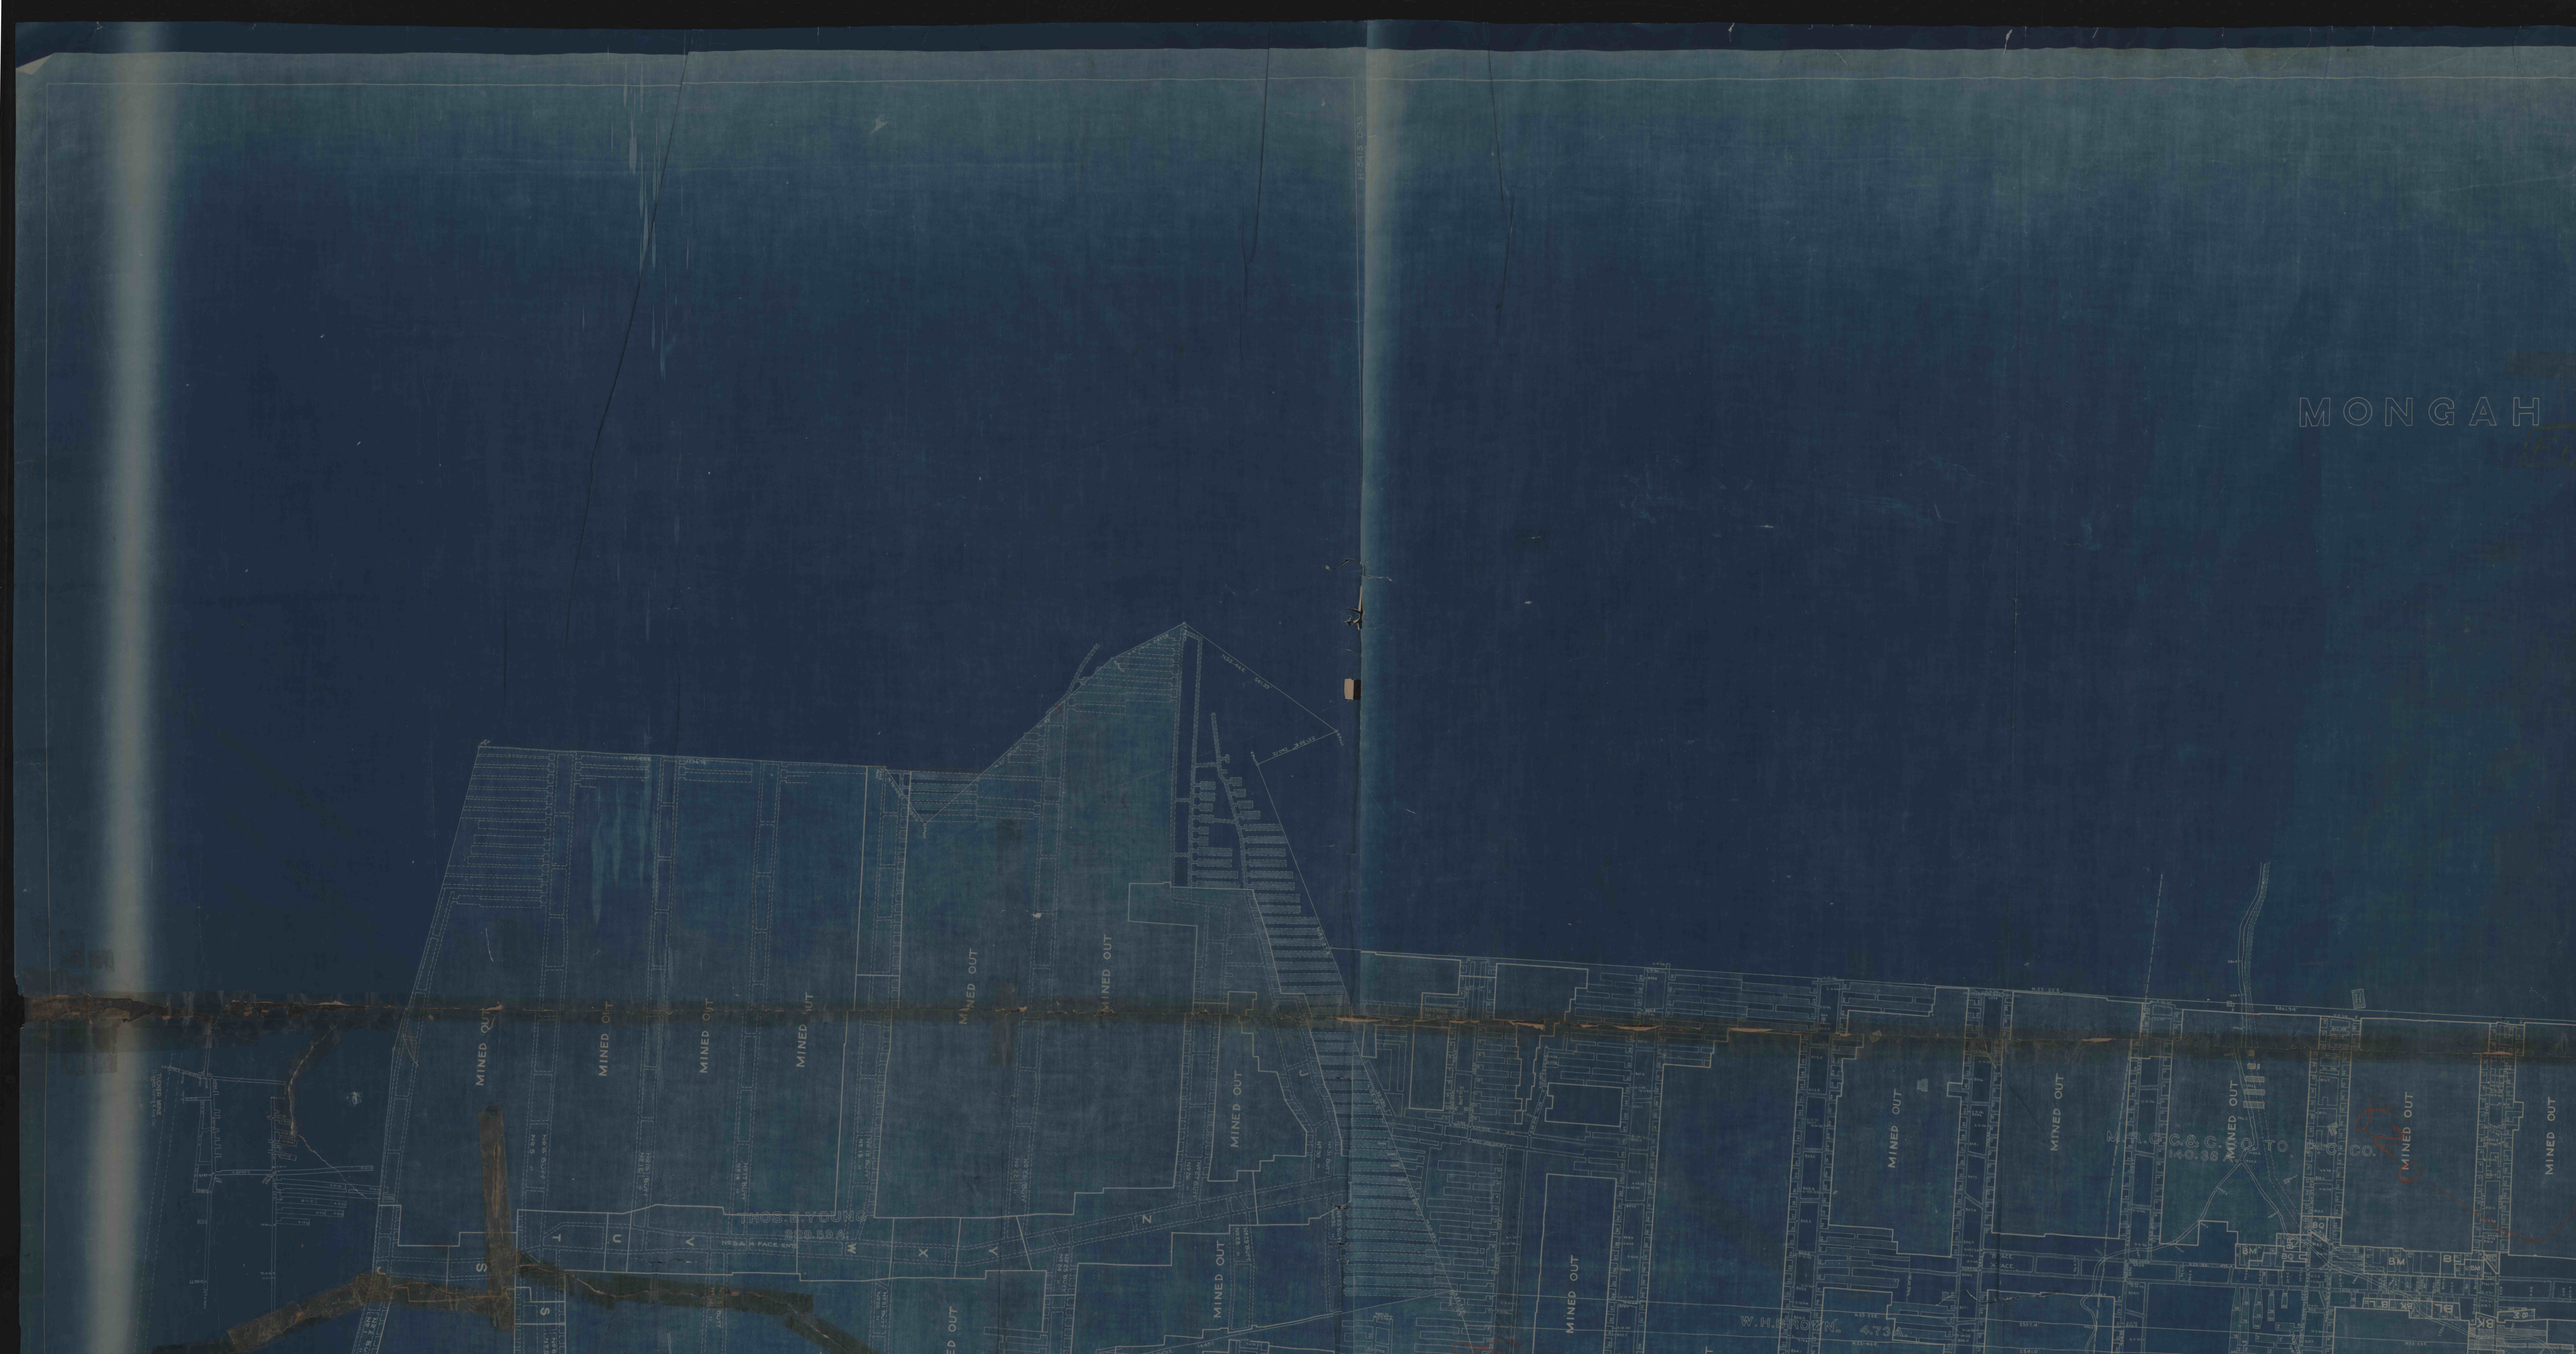
MONGAH
MINED OUT
THOS. B. YOUNG
W. H. BROWN. 4.73 A.
M. R. C. C. & C. CO. TO B. C. CO.
140.38