


White Oak

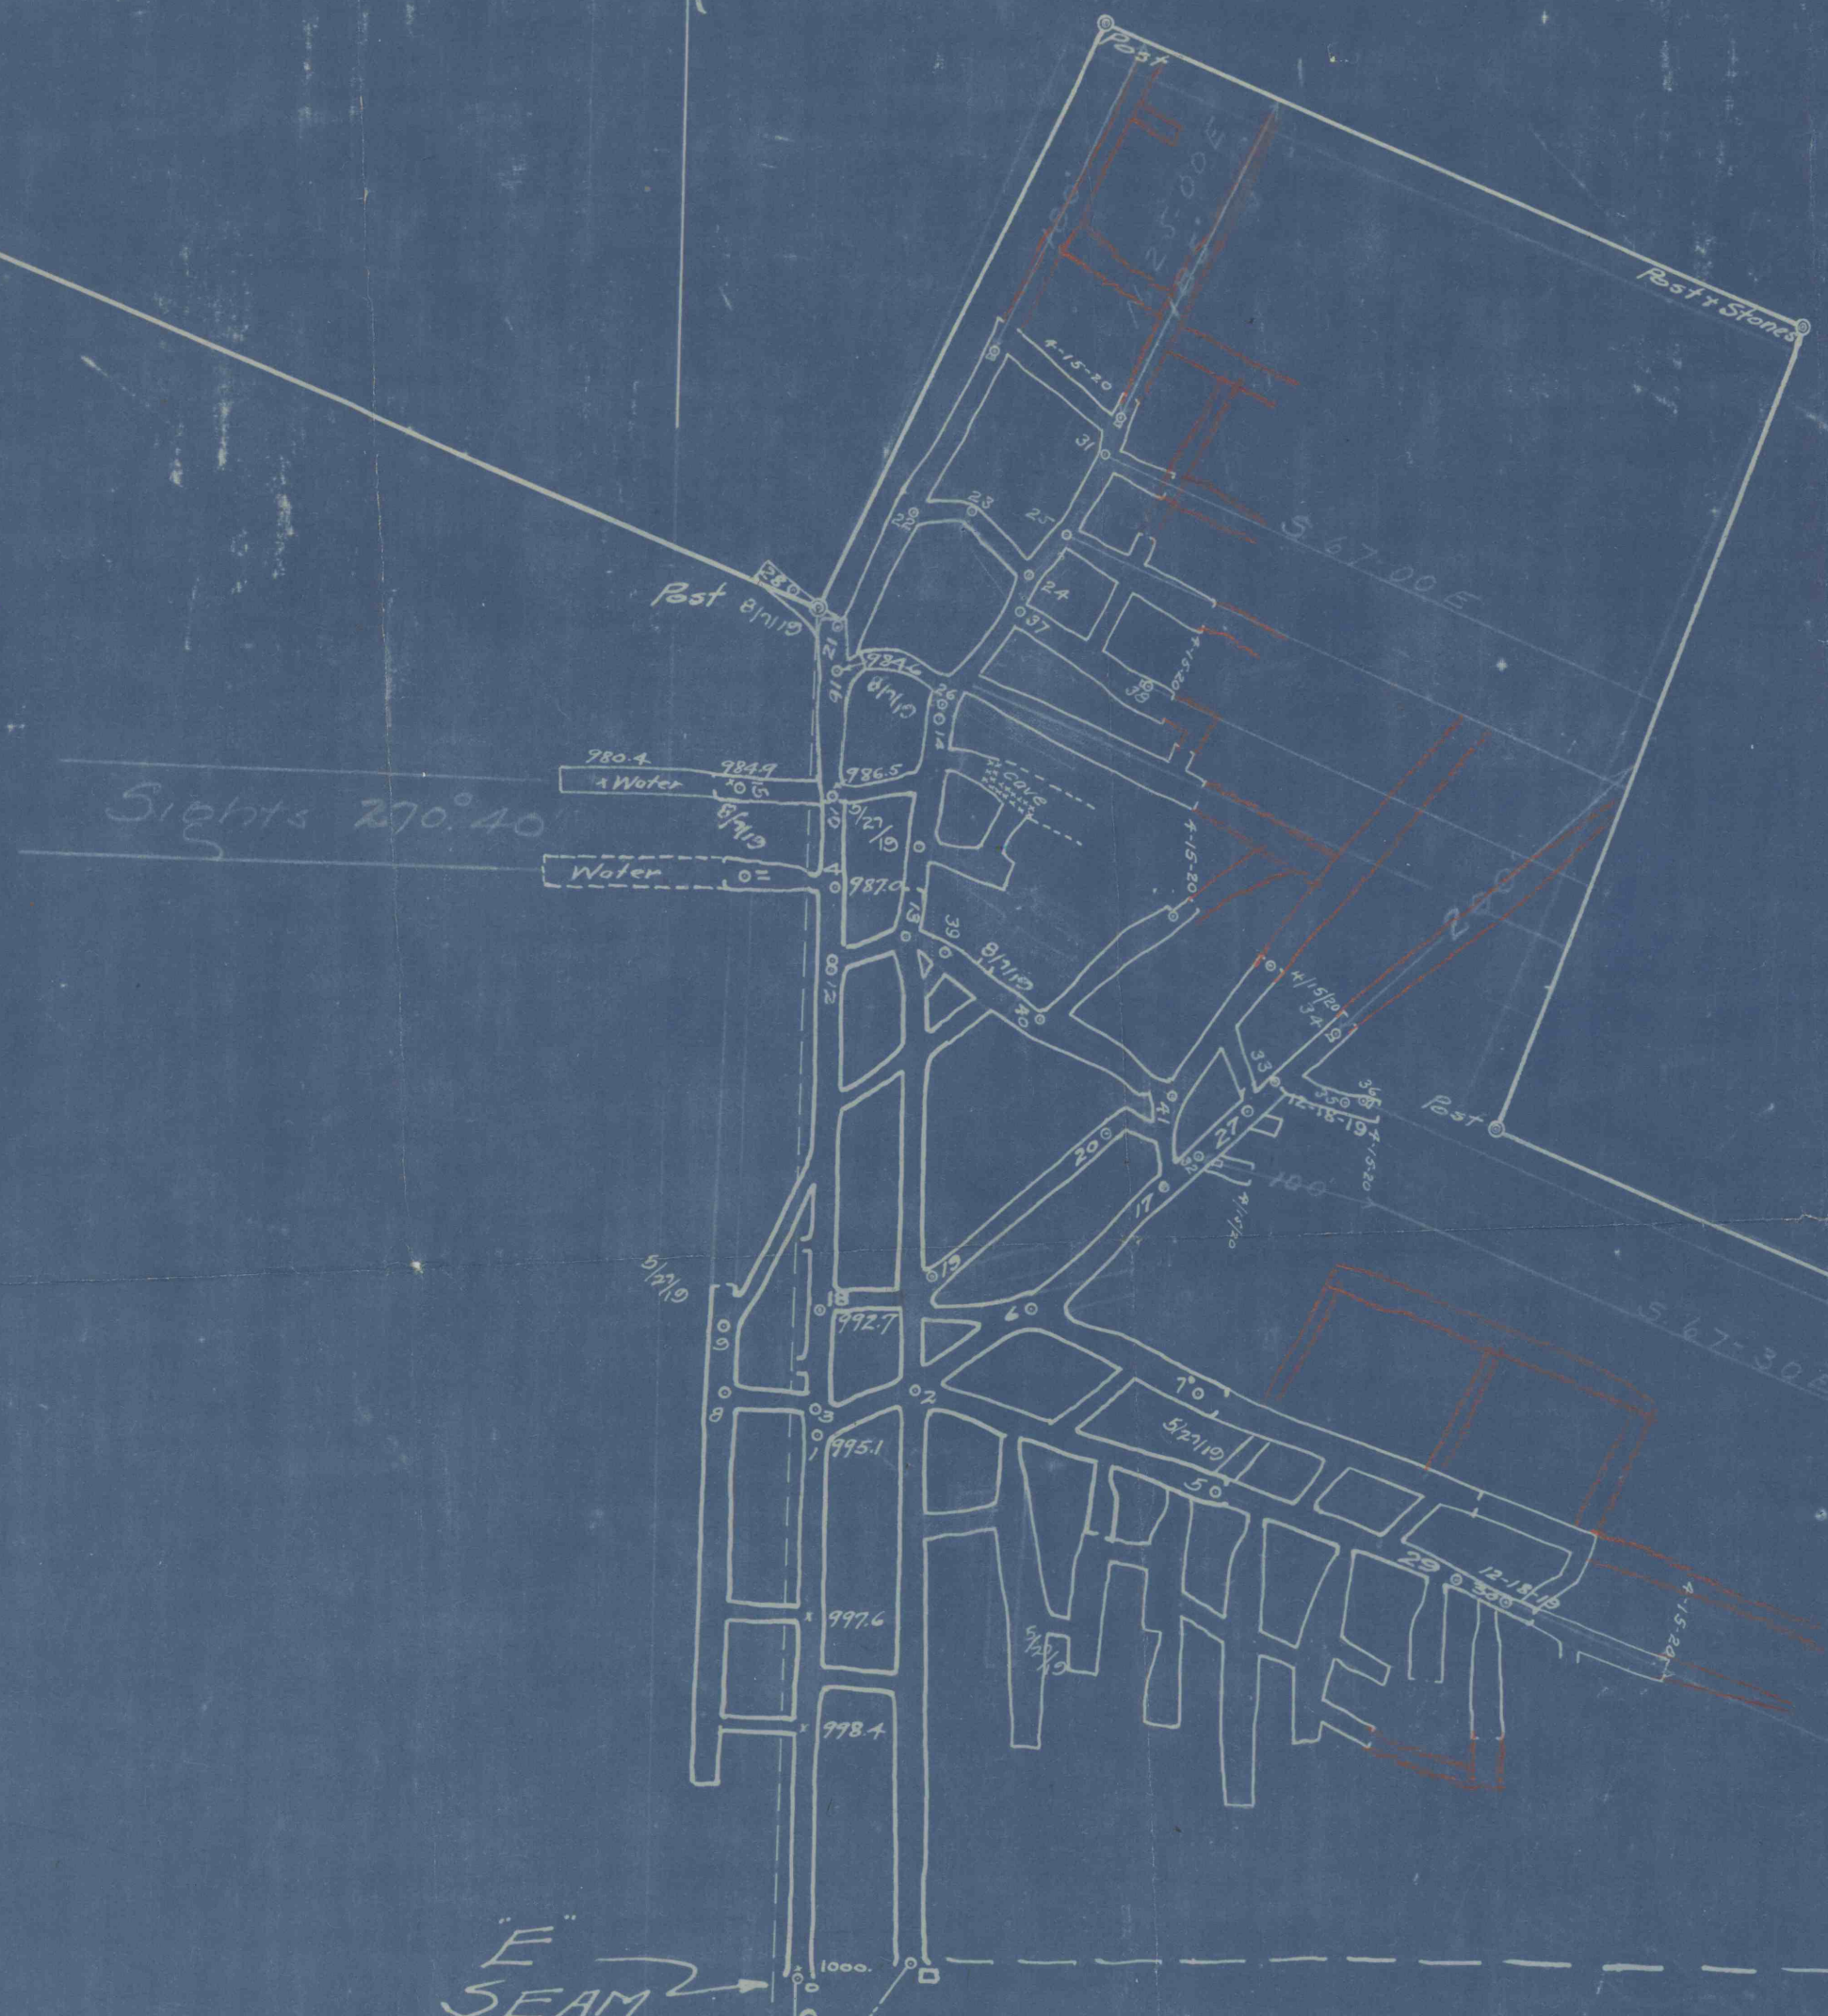

L & IMP CO. TRACT

MCCREA TRACT

*E. Seam*

*OUT-CROP of E SEAM*

*E SEAM*

*B SEAM*

*experimental drift to B seam not producing*

MANUFACTURERS COAL CO.  
 SECTION OF  
 MINE MAP  
 SHOWING  
 "E" & "B" MINES  
 1" = 100'

# 3

SITUATE - WHITE OAK, INDIANA CO. ILL.  
Thos. Pealer, C.E.

#1705  
12-14-99  
C.C.

B  
540