



VENTILATION LEGEND

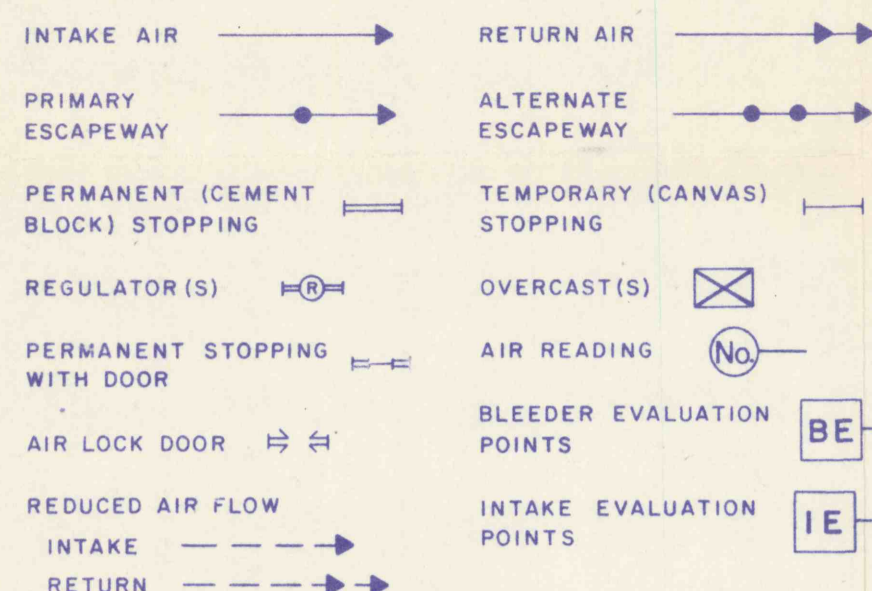

—AIR READINGS—
 1. 50,460 C.F.M. Methane 0.00 %
 2. 49,500 C.F.M.

SUBSIDENCE LEGEND

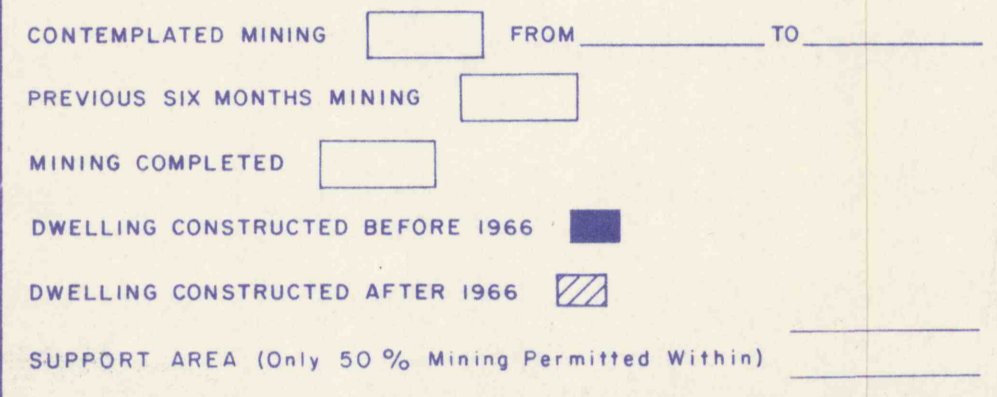

APPROVAL LEGEND

Valley Coal Company
COMPANY

Mardis Run No. 2 Mine
NAME OF MINE

Mine Seal Design and Location
SUBJECT OF APPROVAL

David Uehovic 12/17/84
COMPANY REPRESENTATIVE DATE

John E. Buttliff 12/18/84
ENGINEER DATE



Walter J. Venable 1-9-85
COMMISSIONER, OFFICE OF DEEP MINE SAFETY
DEPARTMENT OF ENVIRONMENTAL RESOURCES DATE

Richard Murphy 1-9-85
DIRECTOR, BITUMINOUS DEEP MINE SAFETY
DEPARTMENT OF ENVIRONMENTAL RESOURCES DATE

John A. Swack 1-4-1985
DISTRICT MINE INSPECTOR
DEPARTMENT OF ENVIRONMENTAL RESOURCES DATE

7	8
5	6
3	4
1	2

SHEET INDEX

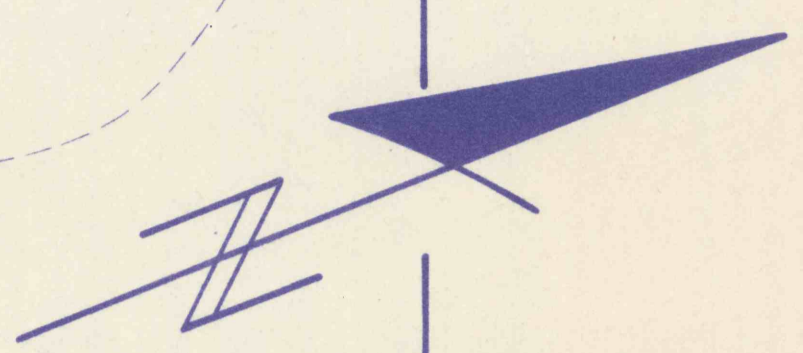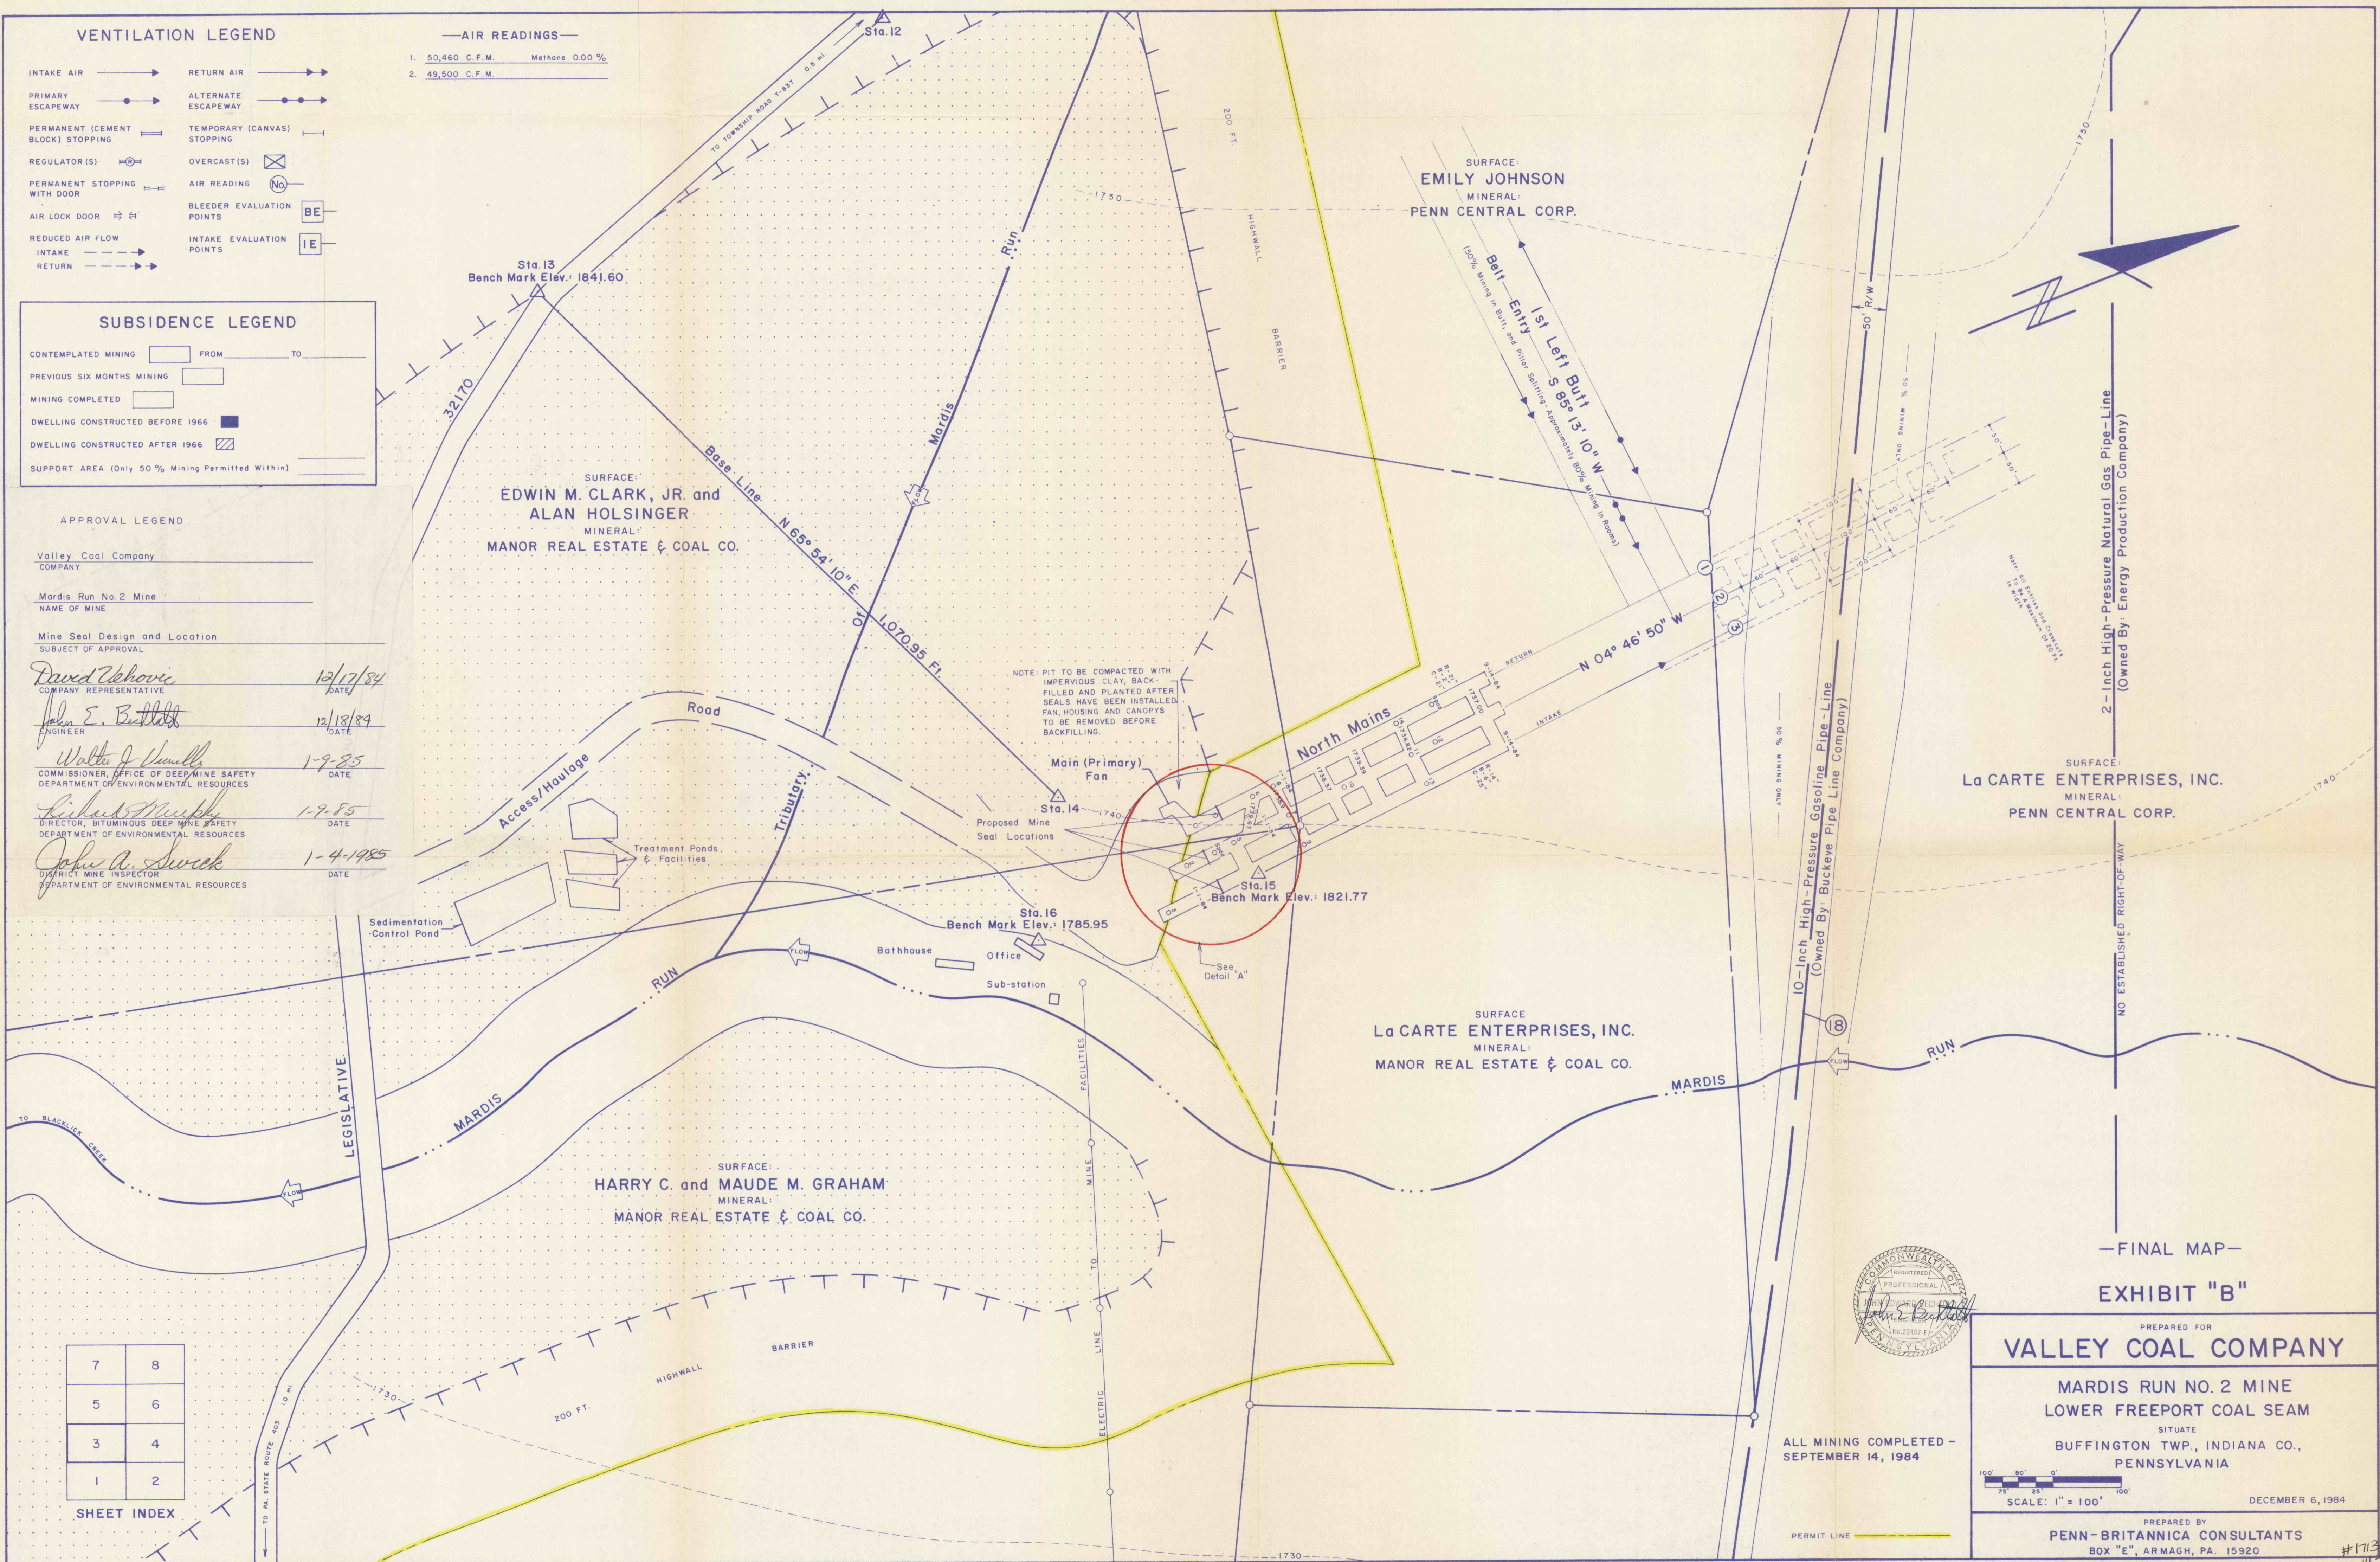

—FINAL MAP—
EXHIBIT "B"

PREPARED FOR
VALLEY COAL COMPANY

MARDIS RUN NO. 2 MINE
 LOWER FREEPORT COAL SEAM
 SITUATE
 BUFFINGTON TWP., INDIANA CO.,
 PENNSYLVANIA

ALL MINING COMPLETED -
SEPTEMBER 14, 1984



DECEMBER 6, 1984

PREPARED BY
 PENN-BRITANNICA CONSULTANTS
 BOX "E", ARMAGH, PA. 15920

#1713
12-14-84
J.E.C.