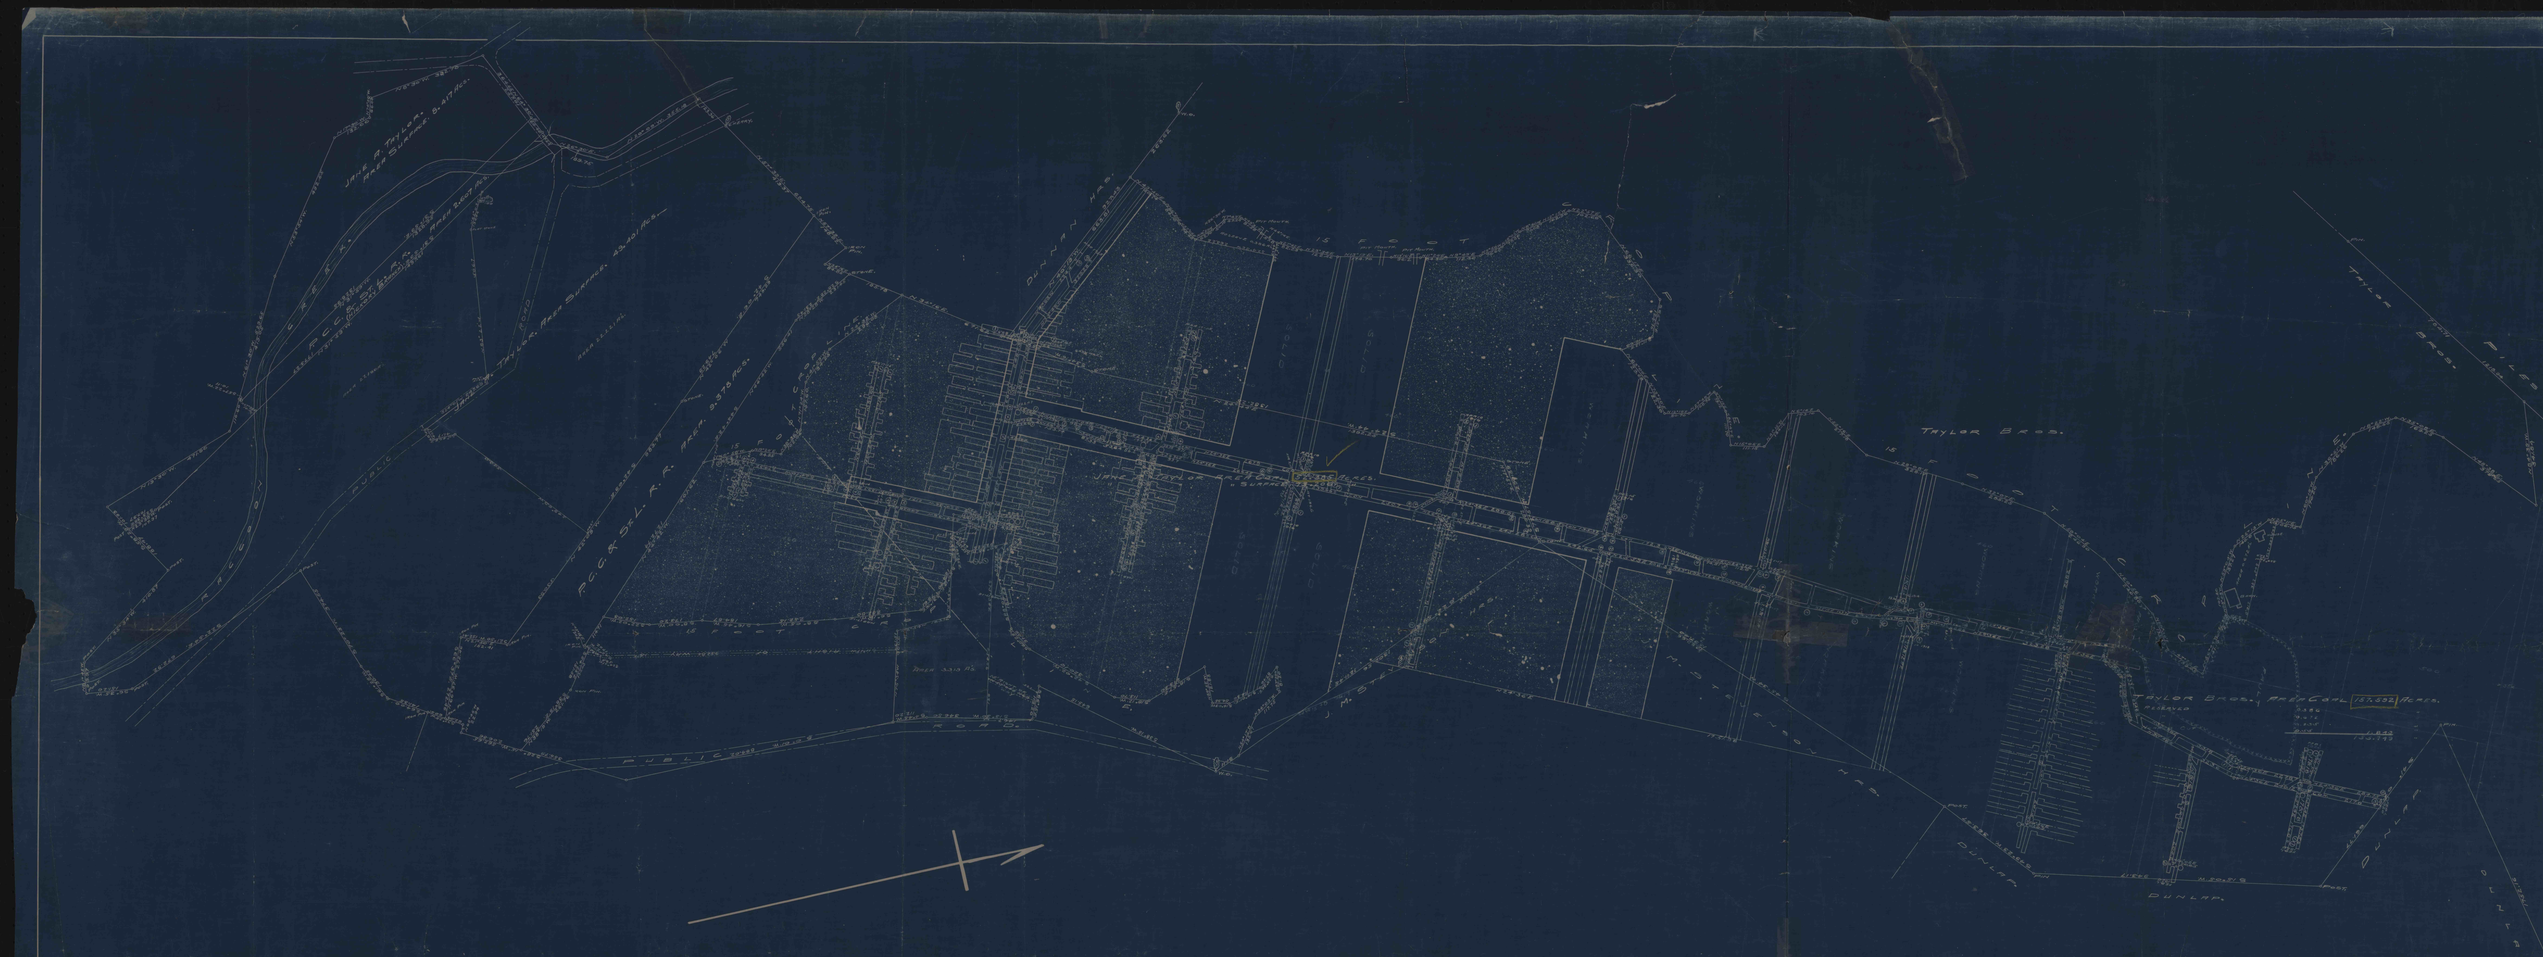


PROPERTY SURVEYED FOR
A. G. HUNT
RACCOON WASHINGTON COUNTY PA.
SCALE 100 = 1" JUNE 1913. FINDLAY & SOUTHARD ENGRS.
CURRY BLDG. PITTSBURGH PA.

NEG
C.P. 3