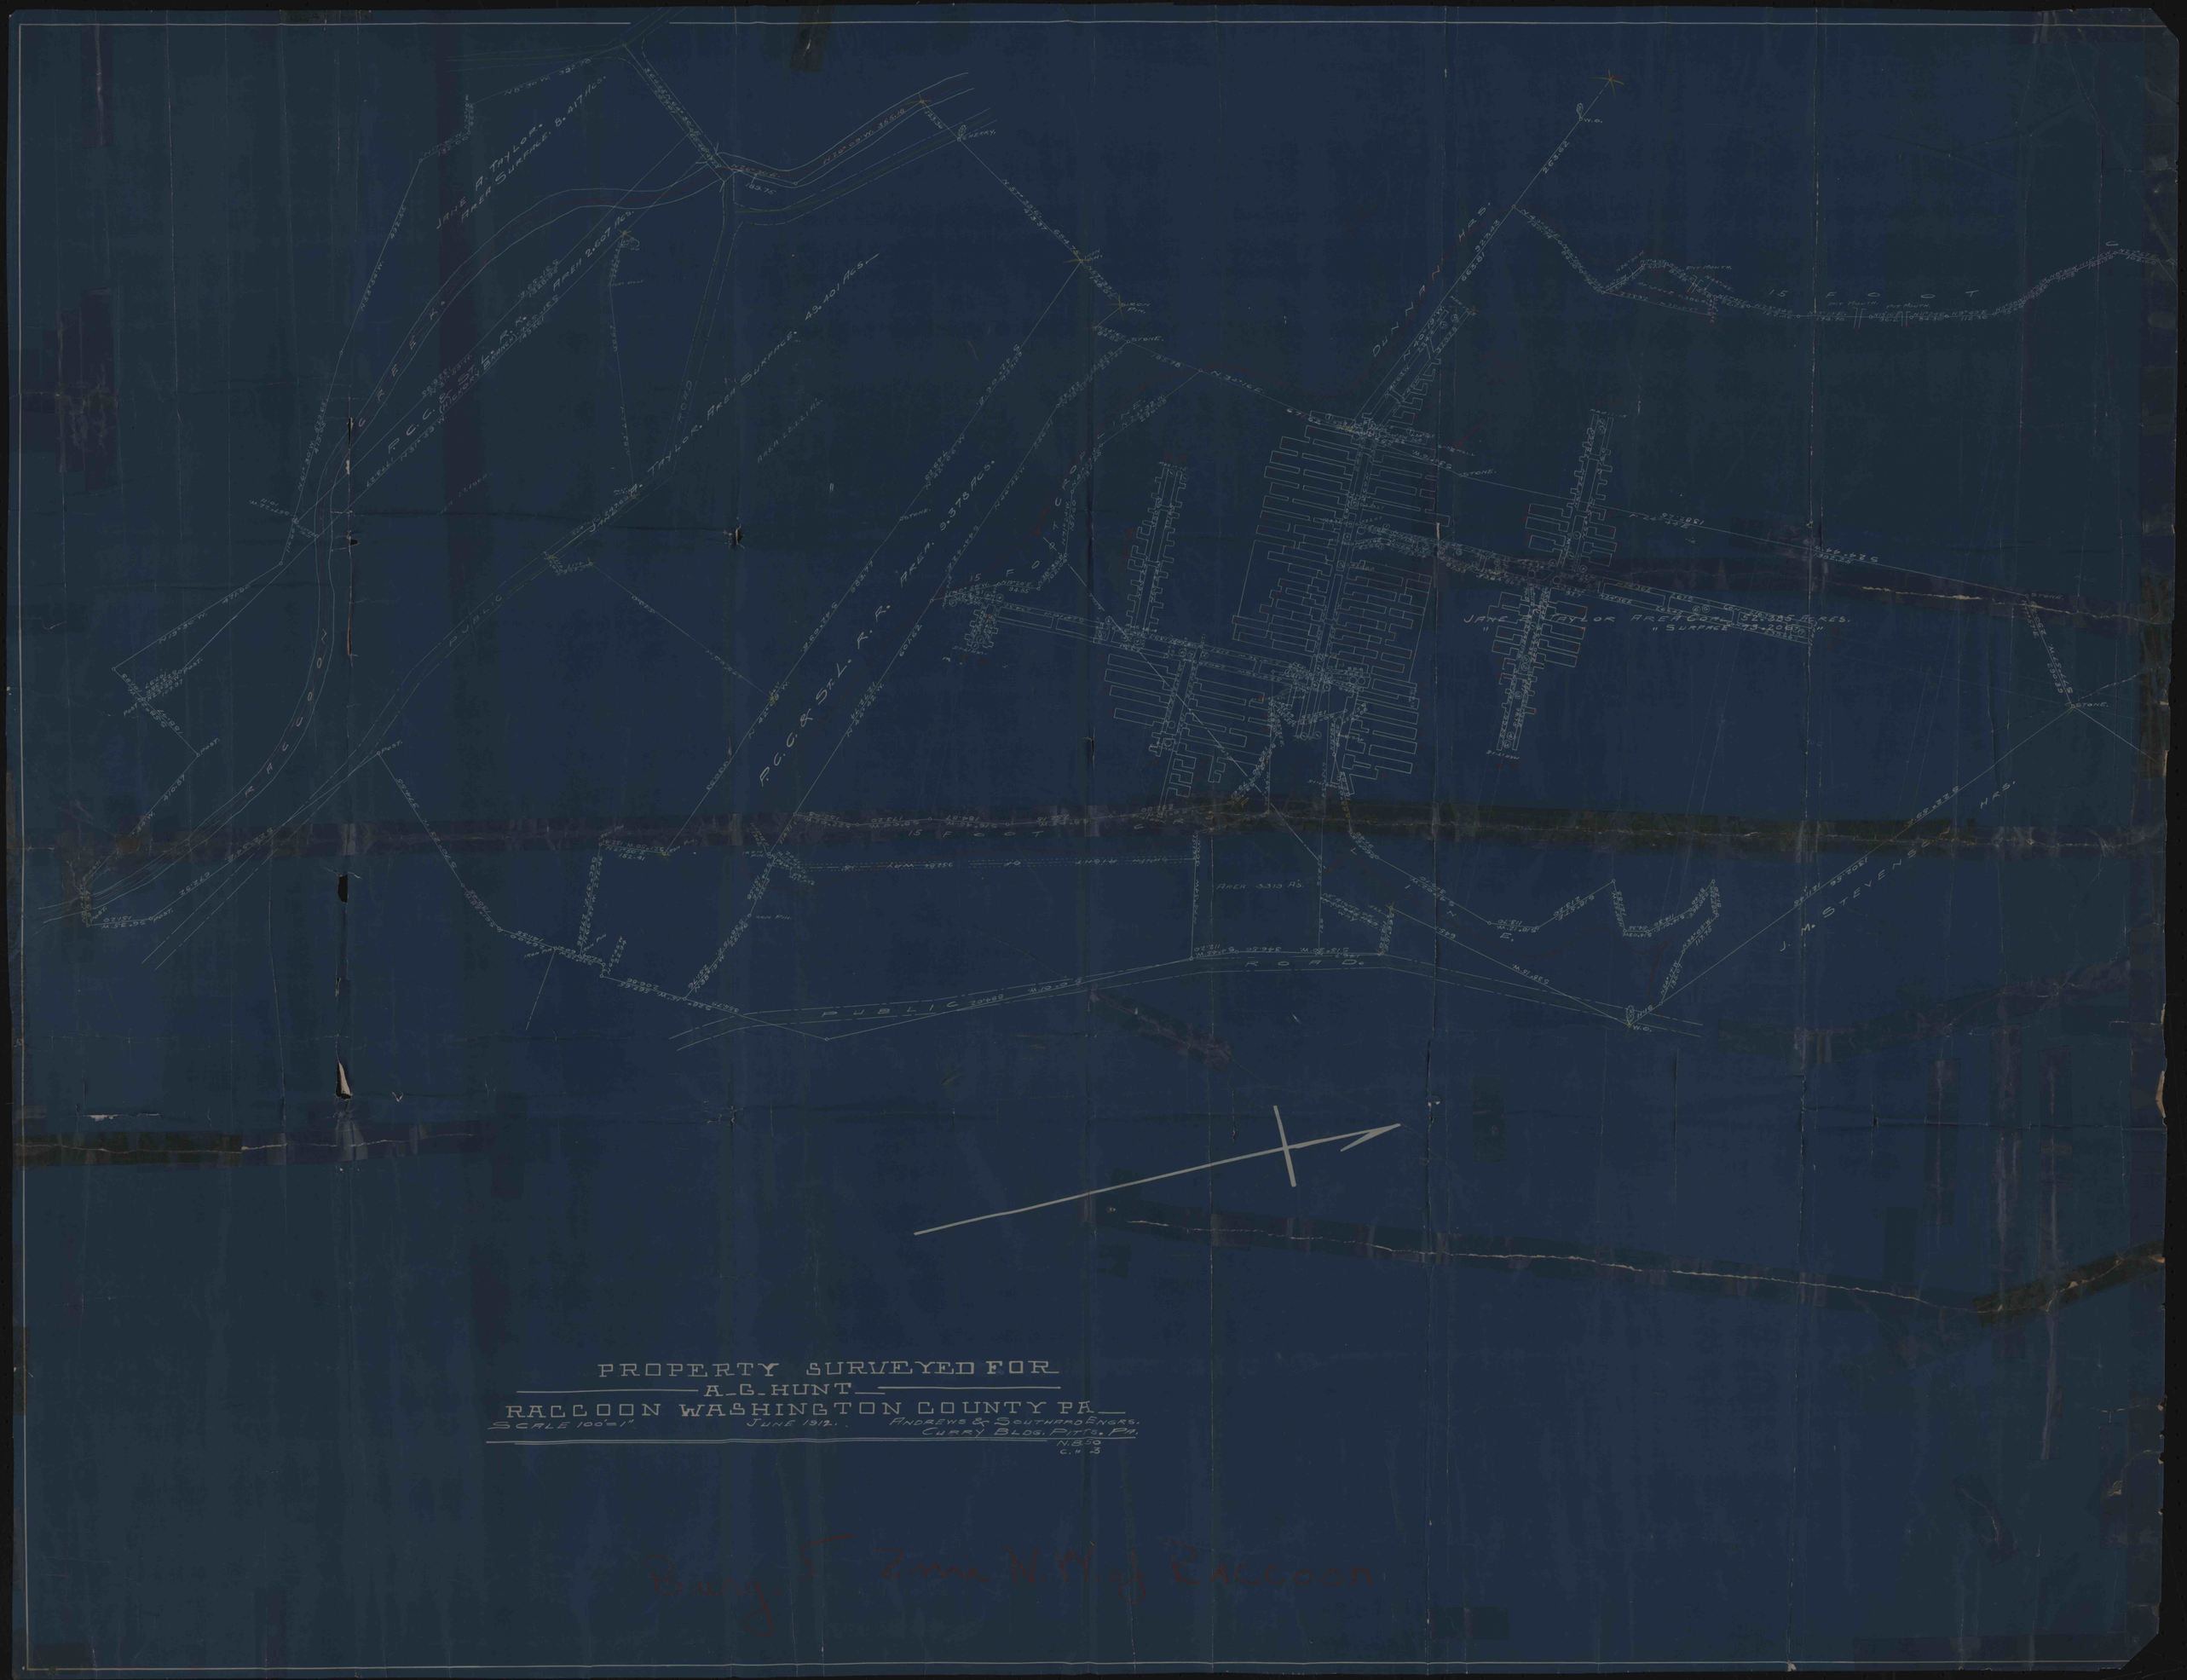
JANE A. TAYLOR. AREA SURFACE. 8.417 ACS.
AREA 2.607 ACS.
JANE A. TAYLOR. AREA SURFACE. 49.401 ACS.
AREA 9.378 ACS.
P.C.C. & ST. L. R.R.
DUNNAN HRS.
15 FOOT
JANE A. TAYLOR AREA COAL. 52.385 ACRES.
" SURFACE 73.208 "
PUBLIC ROAD
J. M. STEVENS
PROPERTY SURVEYED FOR
A. G. HUNT
RACCOON WASHINGTON COUNTY PA.
SCALE 100'=1"
JUNE 1912.
ANDREWS & SOUTHARD ENGRS.
CURRY BLDG. PITTS. PA.
N.B. 50
C. # 3
Bldg. T. Zone N.W. of Raccoon