
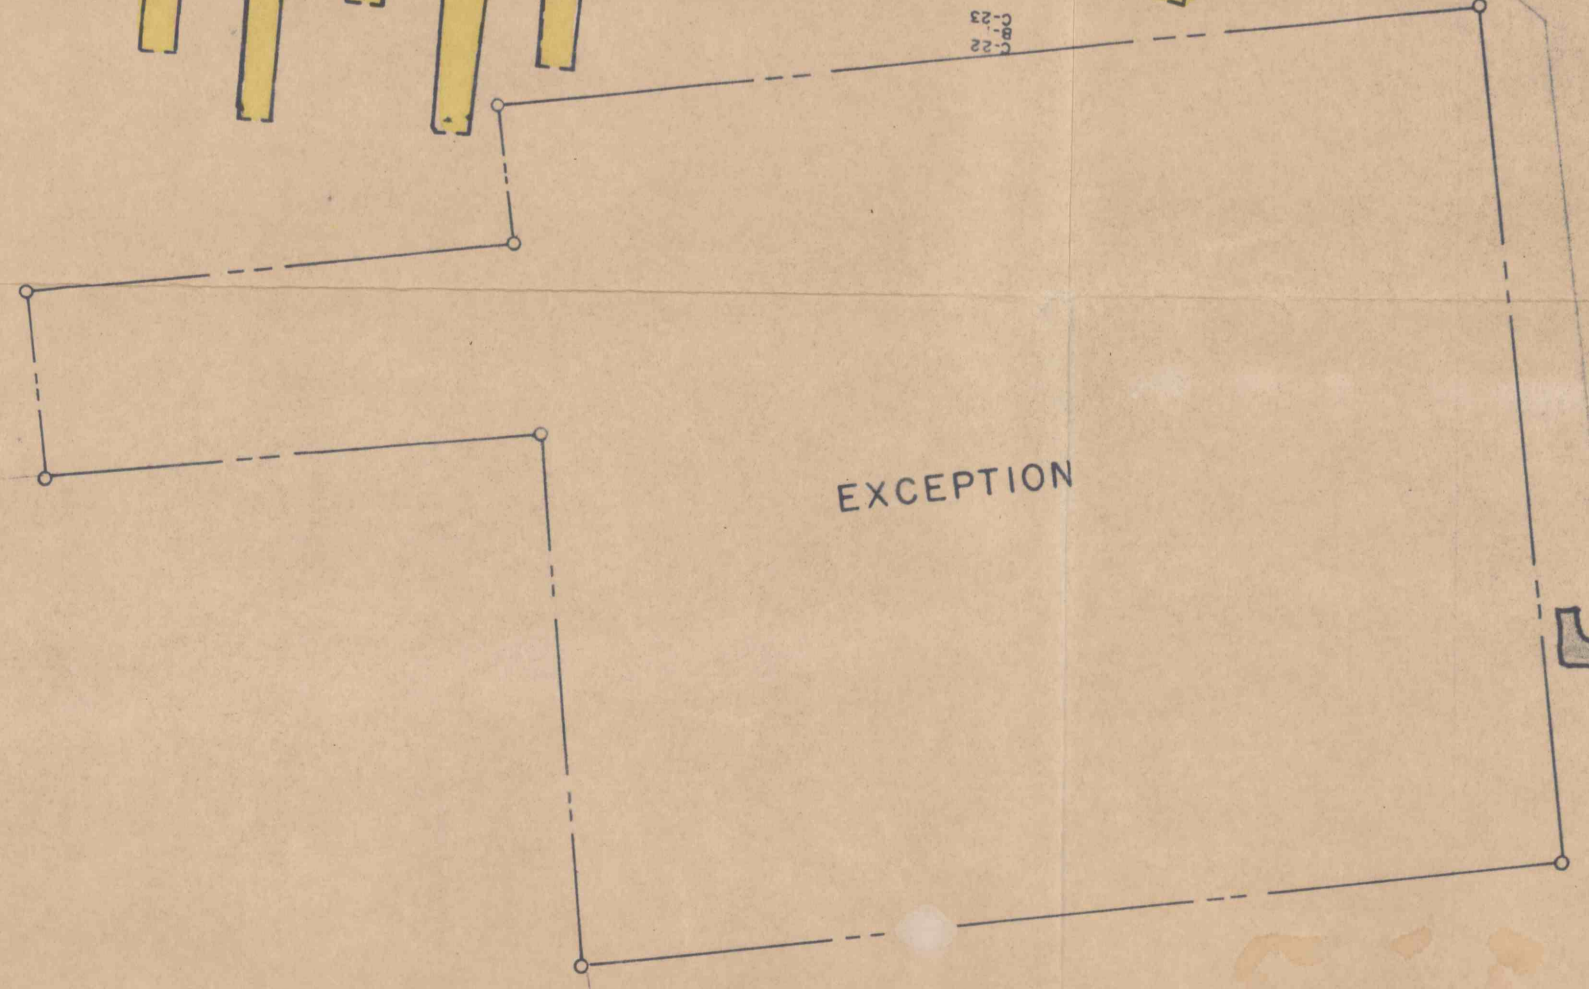
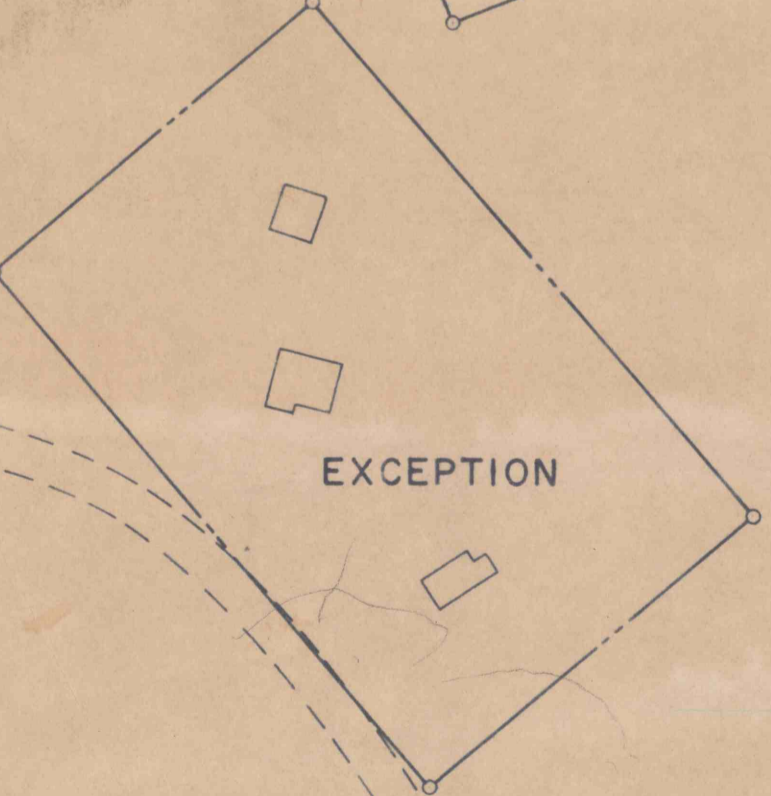


MARLDIS RUN COAL CO INC
ARMAGH, PENNSYLVANIA
MILLER "B" SEAM
EAST WHEATFIELD TOWNSHIP
INDIANA COUNTY
DATE: JULY 6, 1961 SCALE: 1" = 100'
DATE OF LAST SURVEY
7-1-63

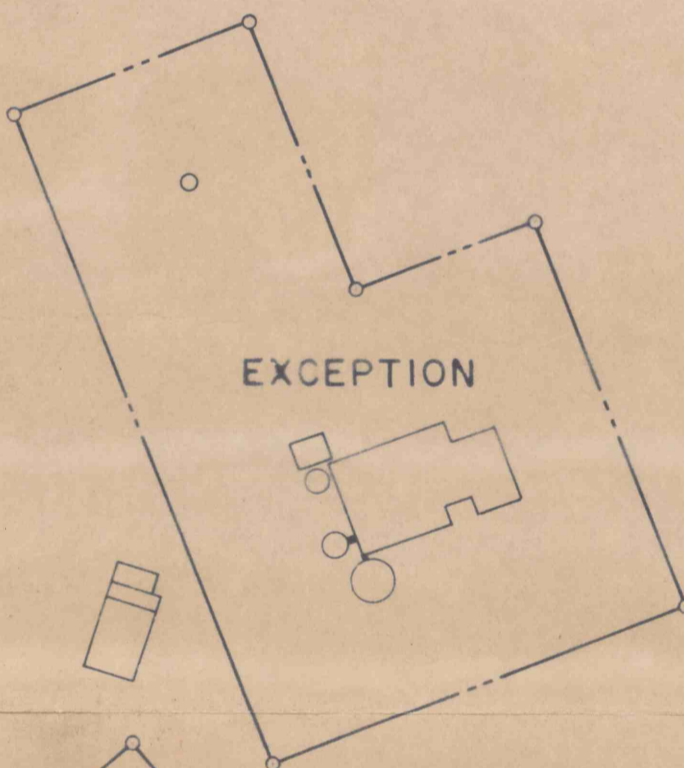

MINED OUT
KISKIMINETAS CO.