MARKELTON MINE
OF THE
BERGER-AIKEN COAL CO.
SITUATE IN
BLACK TWP. SOMERSET CO. PENNA.
SCALE 1"=100'

NOTE:

TRACED FROM BLUEPRINT OF ORIGINAL MAP
SOMERSET PENNA. JULY 16, 1954

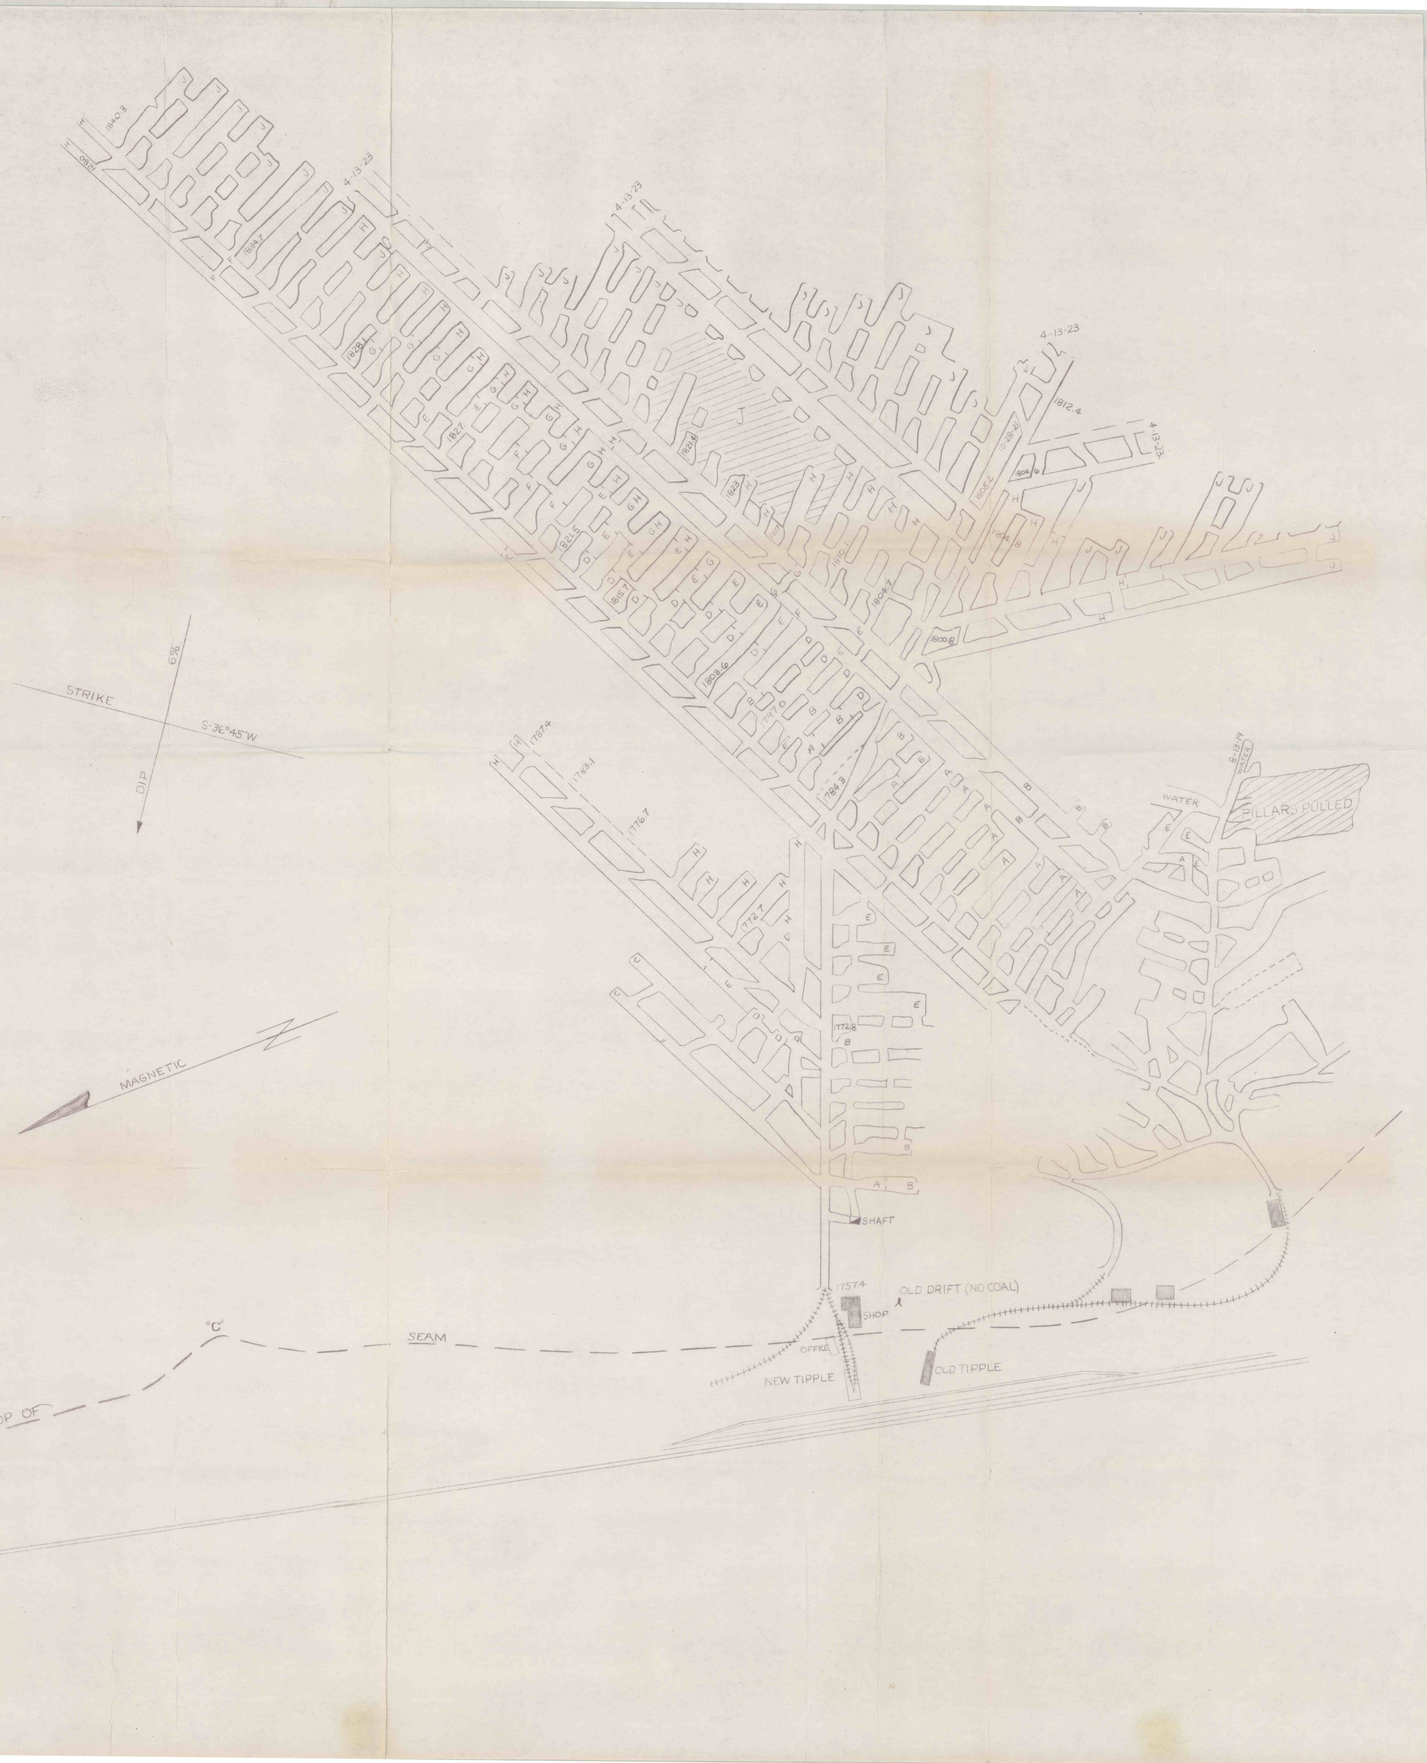

#1739
12-14-99
C.C.