

Mining Completed

Mining Completed

Mining Completed

Mining Area
Aug. 1, 1968
to Feb. 1, 1968



Martha "B" Mine
Lee Mineral Ind., Inc.
Scale 1"=100 ft. P.O. Olliver, Pa.

- Area in which Mining has been completed
- Mining Area from Aug. 1, 1968 to Feb. 1, 1968
- Property Line

SCALE 1"=100 FT. DATE SEE LEGEND

POSTED
July 28, 1963
Posted by C.H. Reed
July 28, 1964
August 14, 1964
January 23, 1965
June 7, 1965
Feb. 8, 1966
July 14, 1966
1-25-68 Lewis & Hanley
8-1-68 Lewis & Hanley

LEGEND
B NOV. 30 1951
C JULY 17 1952
FEB. 4, 1958 CONST. ONLY
POSTED SEPT. 8, 1958
POSTED NOV. 24, 1958
POSTED MAY 29, 1959
POSTED JUNE 1, 1960
D MAR. 8, 1961
TO DATE DEC. 21, 1961 C.H.R.
Note: K.D., M. Survey by C.H. Reed
TO DATE Jan. 18, 1962
TO DATE Feb. 23, 1964

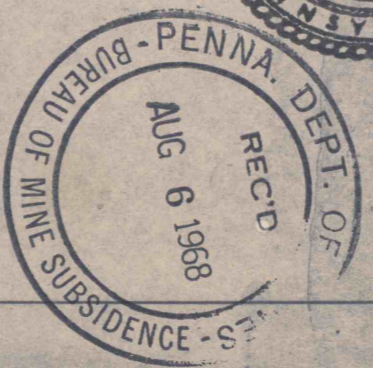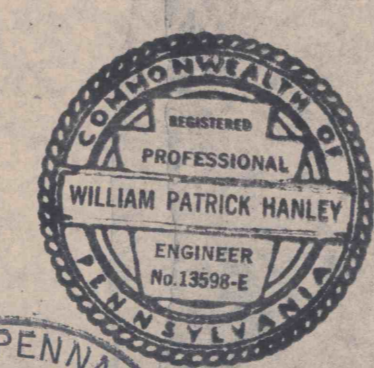

MELVIN GARLOW FREDERICKSBURG, VA.
OWNER OF SURFACE
H. H. & N. COAL CO. OWNER OF COAL MORGANTOWN, W. VA.
150.0 Ac. COAL
LEE MINERAL IND. INC. LEASEHOLD MORGANTOWN, W. VA.

#1734
12-14-69
C.C.