


SCALE 1/1000 DATE: SEE LEGEND

LEE MINERAL INC.  
D. AND M. ANNE  
D. AND M. ANNE COAL CO.

POSTED	LEGEND
JULY 23, 1963	B NOV 30 1951
POSTED BY: G. B. BENT	C JULY 17 1952
APPROVED: 1964	FEB 4, 1958 CONST ONLY
APPROVED: 1964	POSTED SEPT 8, 1958
JUNE 7, 1963	POSTED NOV 24, 1958
APPROVED: 1964	POSTED MAY 29, 1959
JULY 14, 1963	POSTED JUNE 1, 1960
APPROVED: 1964	D = MAR 8, 1961
TO DATE: DEC 21, 1961	
7-11-67 Lewis Shiloh	
7-25-68 Lewis Shiloh	
8-1-68 Lewis Shiloh	
8-1-68 Lewis Shiloh	

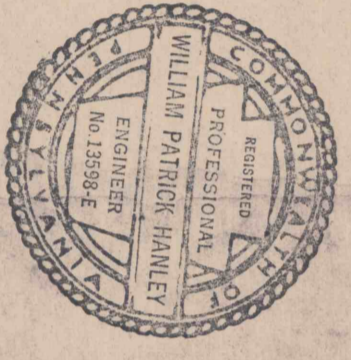

LEE MINERAL INC. INC. LEASEHOLD MORGANTOWN, W. VA.  
 H. H. & K. COAL CO. OWNER OF COAL MORGANTOWN, W. VA.  
 1500 O. AS. COAL  
 MELVIN GARLOW FREDERICKSBURG VA.  
 OWNER OF SURFACE

