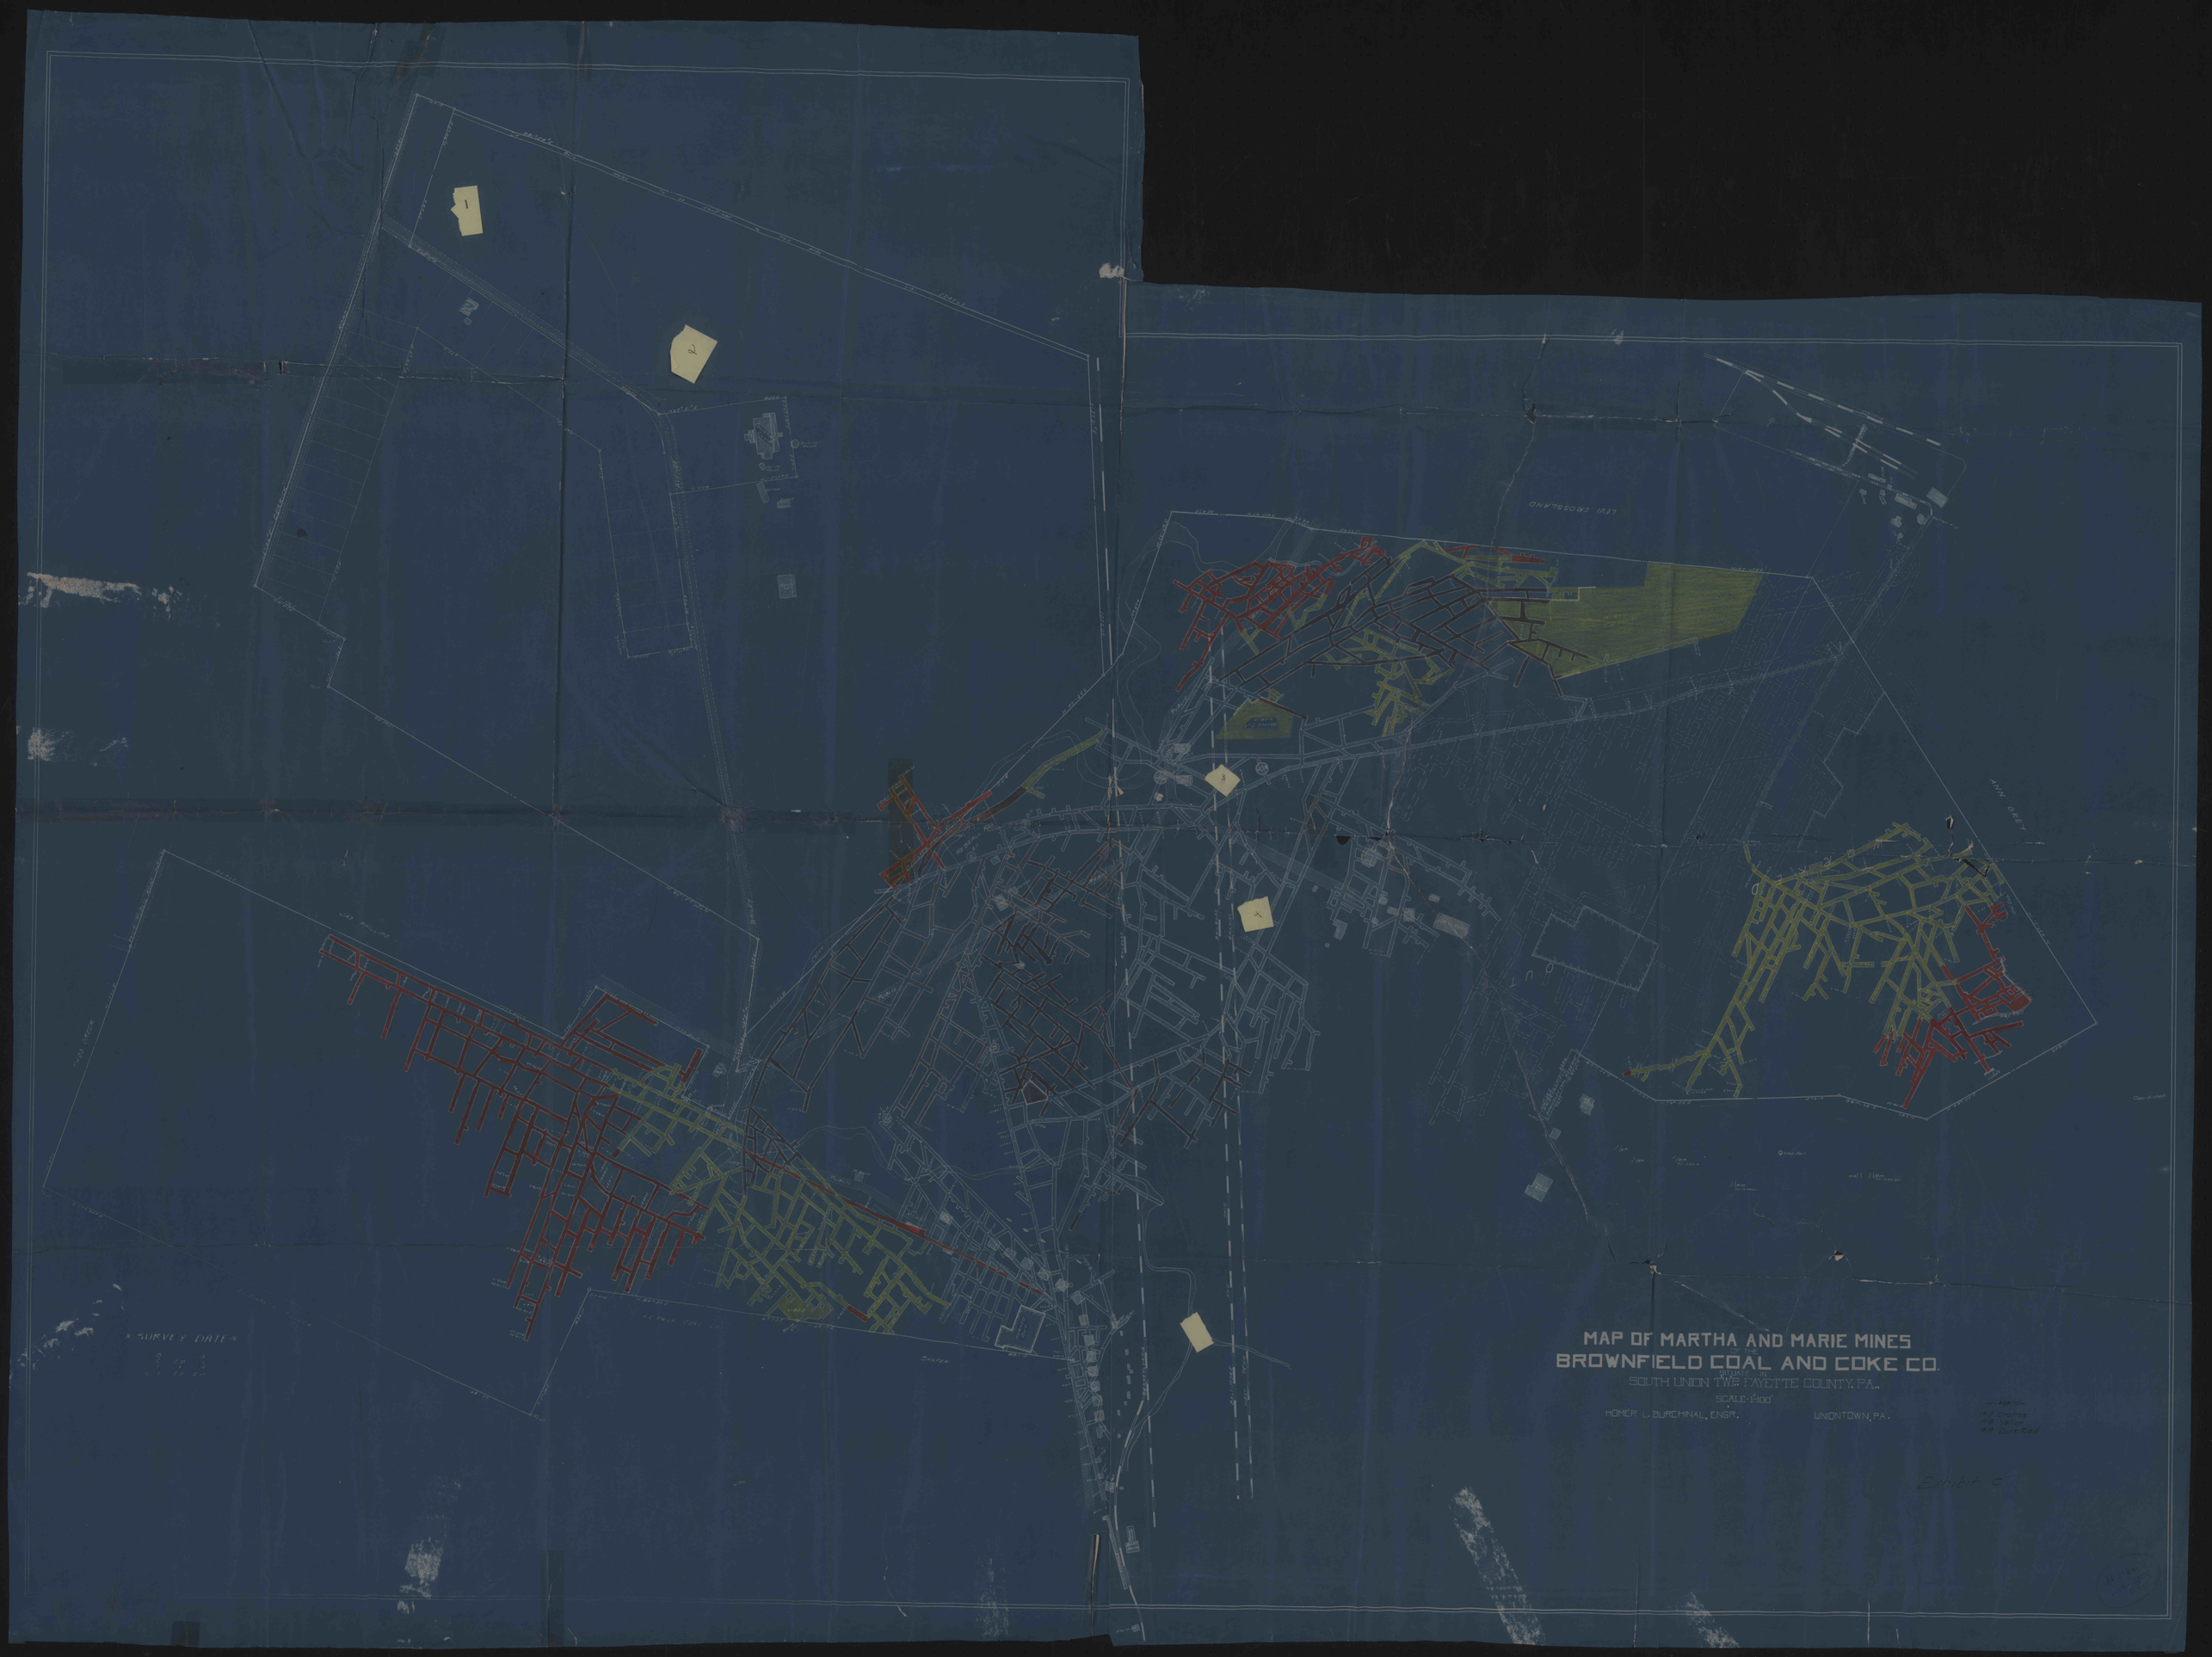
MAP OF MARTHA AND MARIE MINES
BROWNFIELD COAL AND COKE CO.
SITUATE IN
SOUTH UNION TWP. FAYETTE COUNTY, PA.
SCALE-1"=100'
HOMER L. BURCHINAL, ENGR.
UNIONTOWN, PA.
Legend
1917 Grades
1918 Yellow
1919 Dark Red
Exhibit "C"
SURVEY DATE