


H. H. & N. COAL CO. MORGANTOWN, W. VA.
OWNER COAL & SURFACE


MARTHA MINE #1
LEE MINERAL IND. INC.
DUNKARD TWP GREENE CO. PA.
SCALE 1"=100'. DATE SEE LEGEND
ADDRESS DUNKARD, PA.

POSTED BY	DATE
W. H. H. H. H.	8-18-62
W. H. H. H. H.	7-22-63

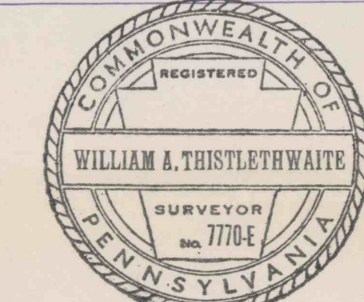

SCALE 1"=100' DATE SEE LEGEND


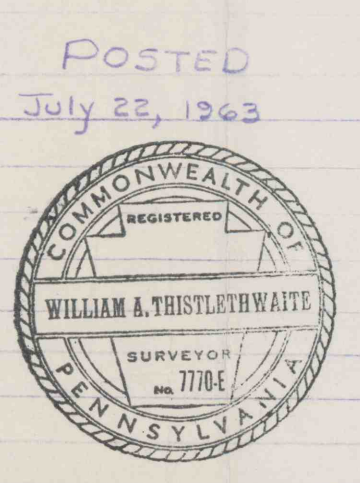

POSTED	LEGEND
July 22, 1963	B NOV. 30 1951
	C JULY 17 1952
	FEB. 4, 1958 CONST. ONLY
	POSTED SEPT. 8, 1958
	POSTED NOV. 24, 1958
	POSTED MAY 29, 1959
	POSTED JUNE 1, 1960
	D MAR. 8, 1961
	TO DATE DEC. 21, 1961 C.N.R.
	NOTE: K.D.M., M.S. Surveyor, C.N.R.
	PL. DATE: Jan. 15, 1962
	PL. DATE: FEB. 22, 1962

MELVIN GARLOW FREDERICKSBURG, VA.
OWNER OF SURFACE
H. H. & N. COAL CO. OWNER OF COAL MORGANTOWN, W. VA.
150.0 AC. COAL
LEE MINERAL IND. INC. LEASEHOLD MORGANTOWN, W. VA.

#1751
12-10-63
C.C.