


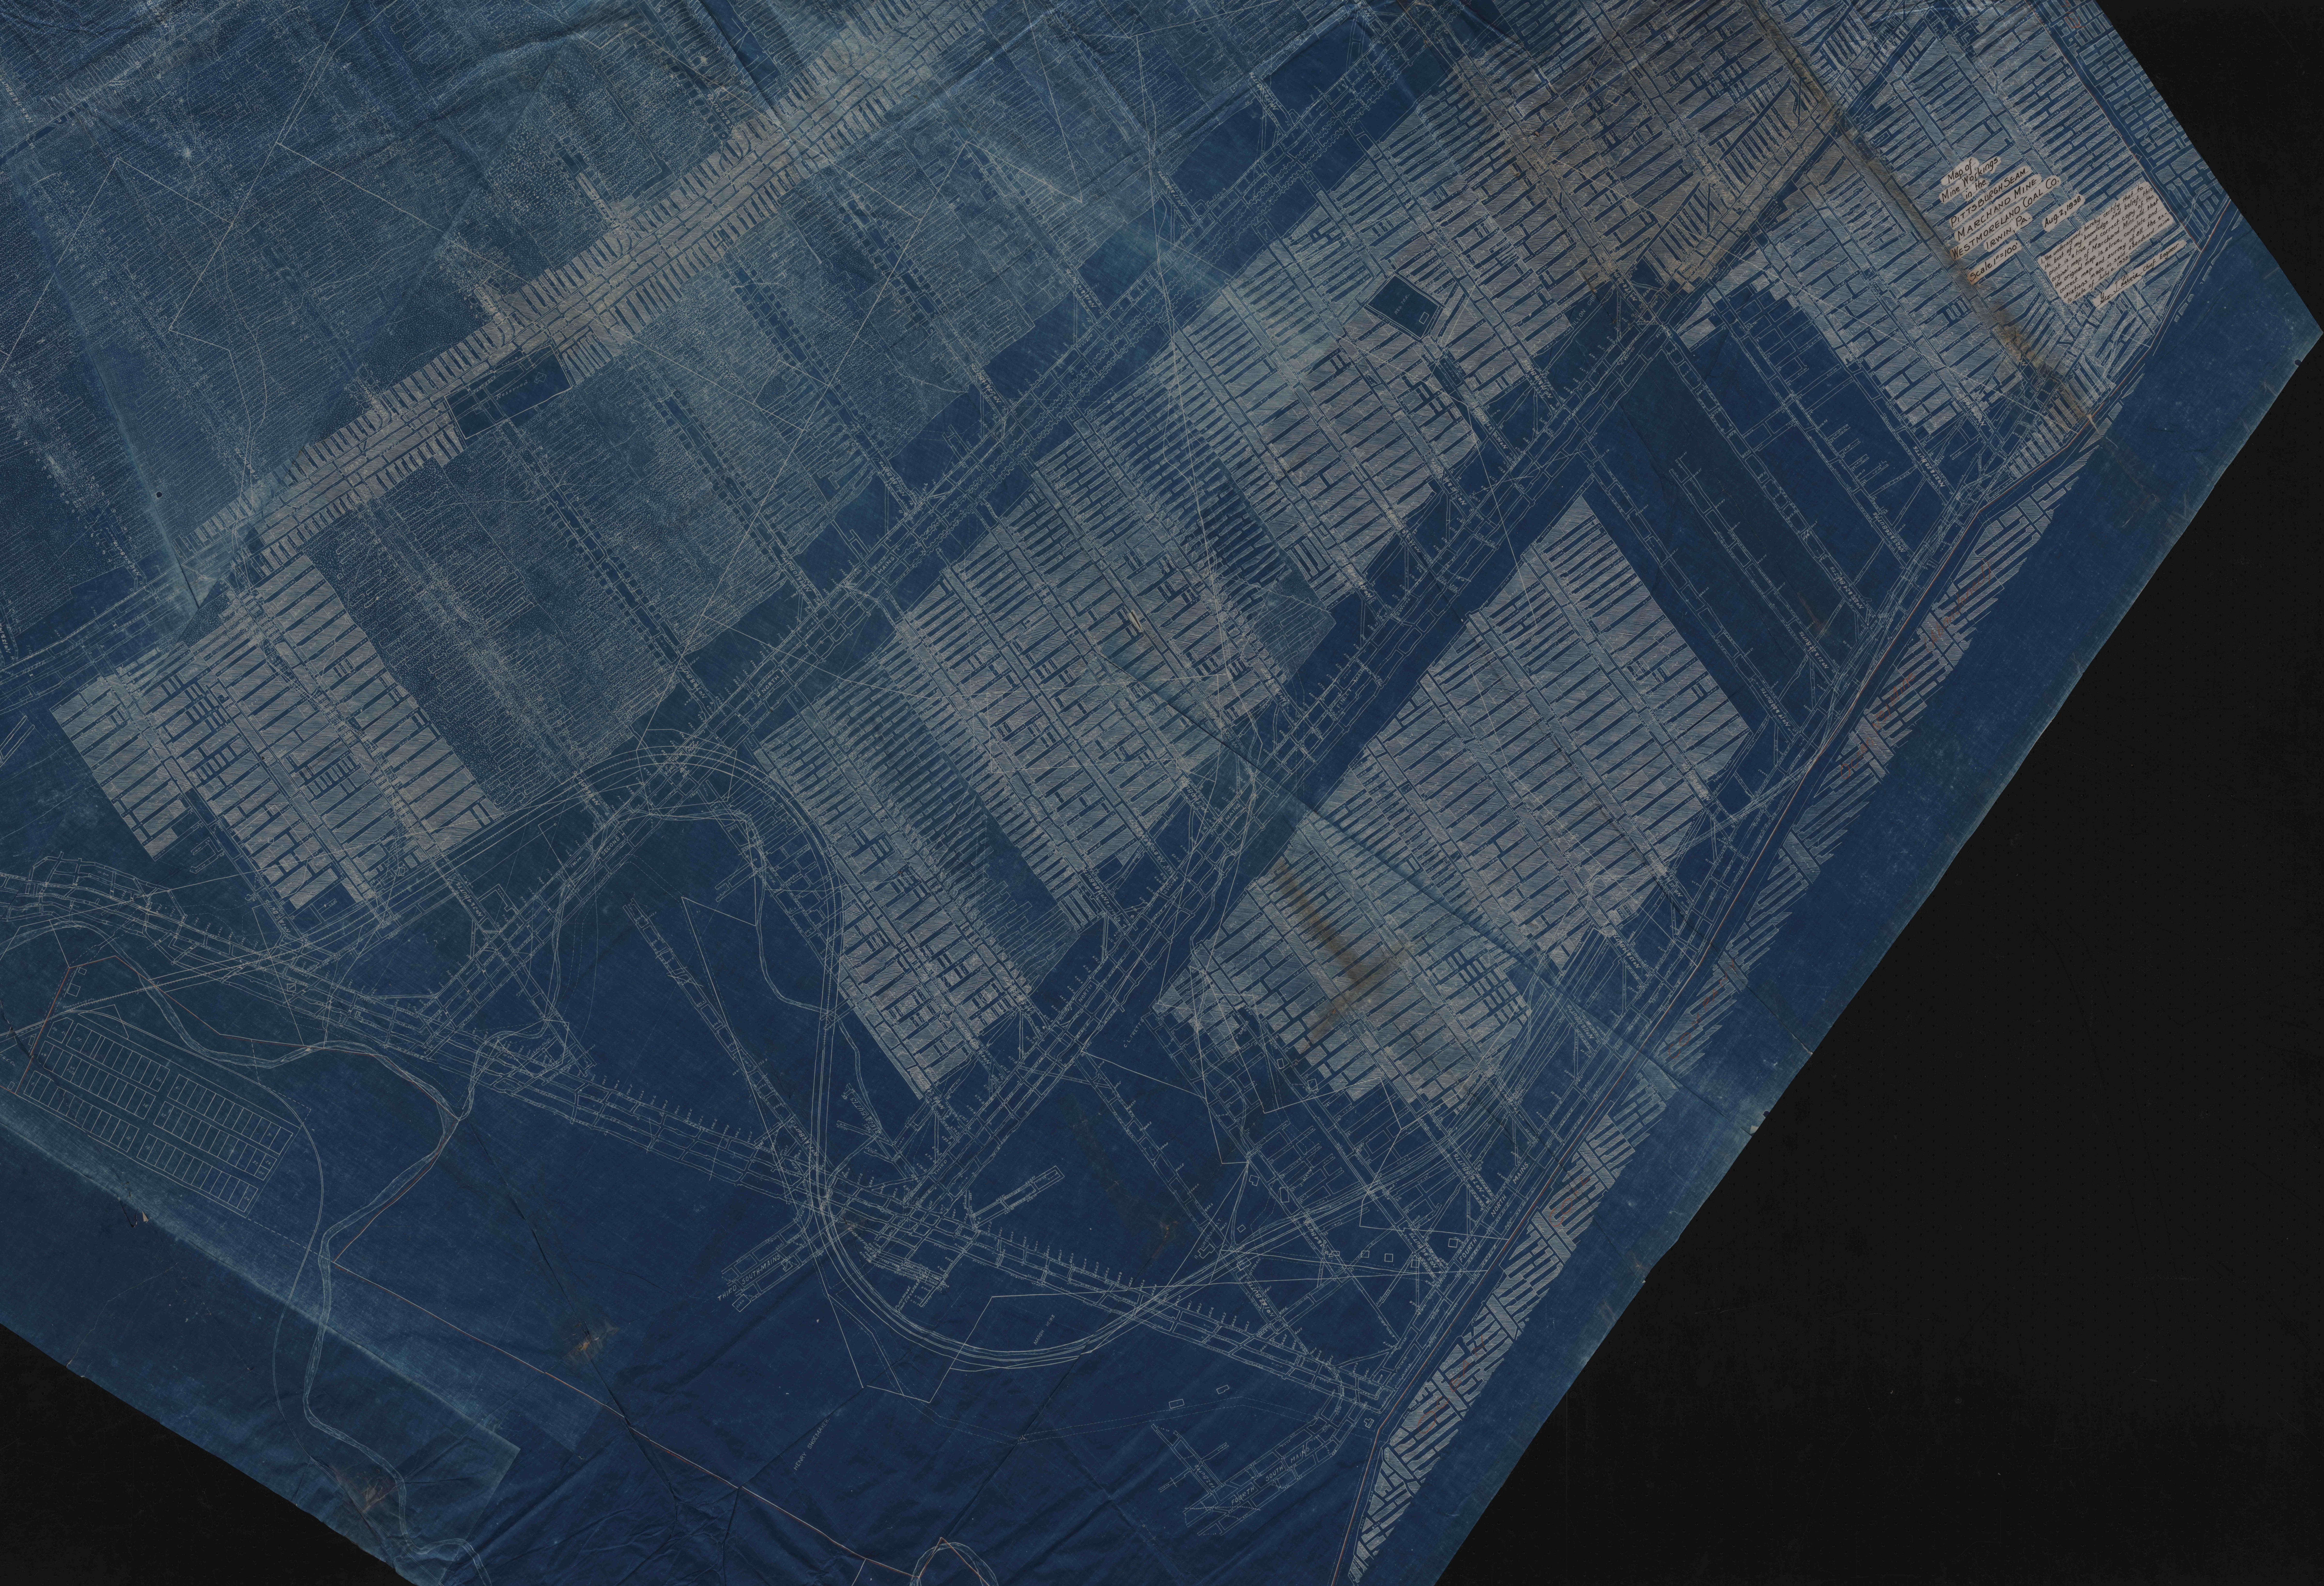

Map of
Scale 1"=100'

Aug. 2, 1938
