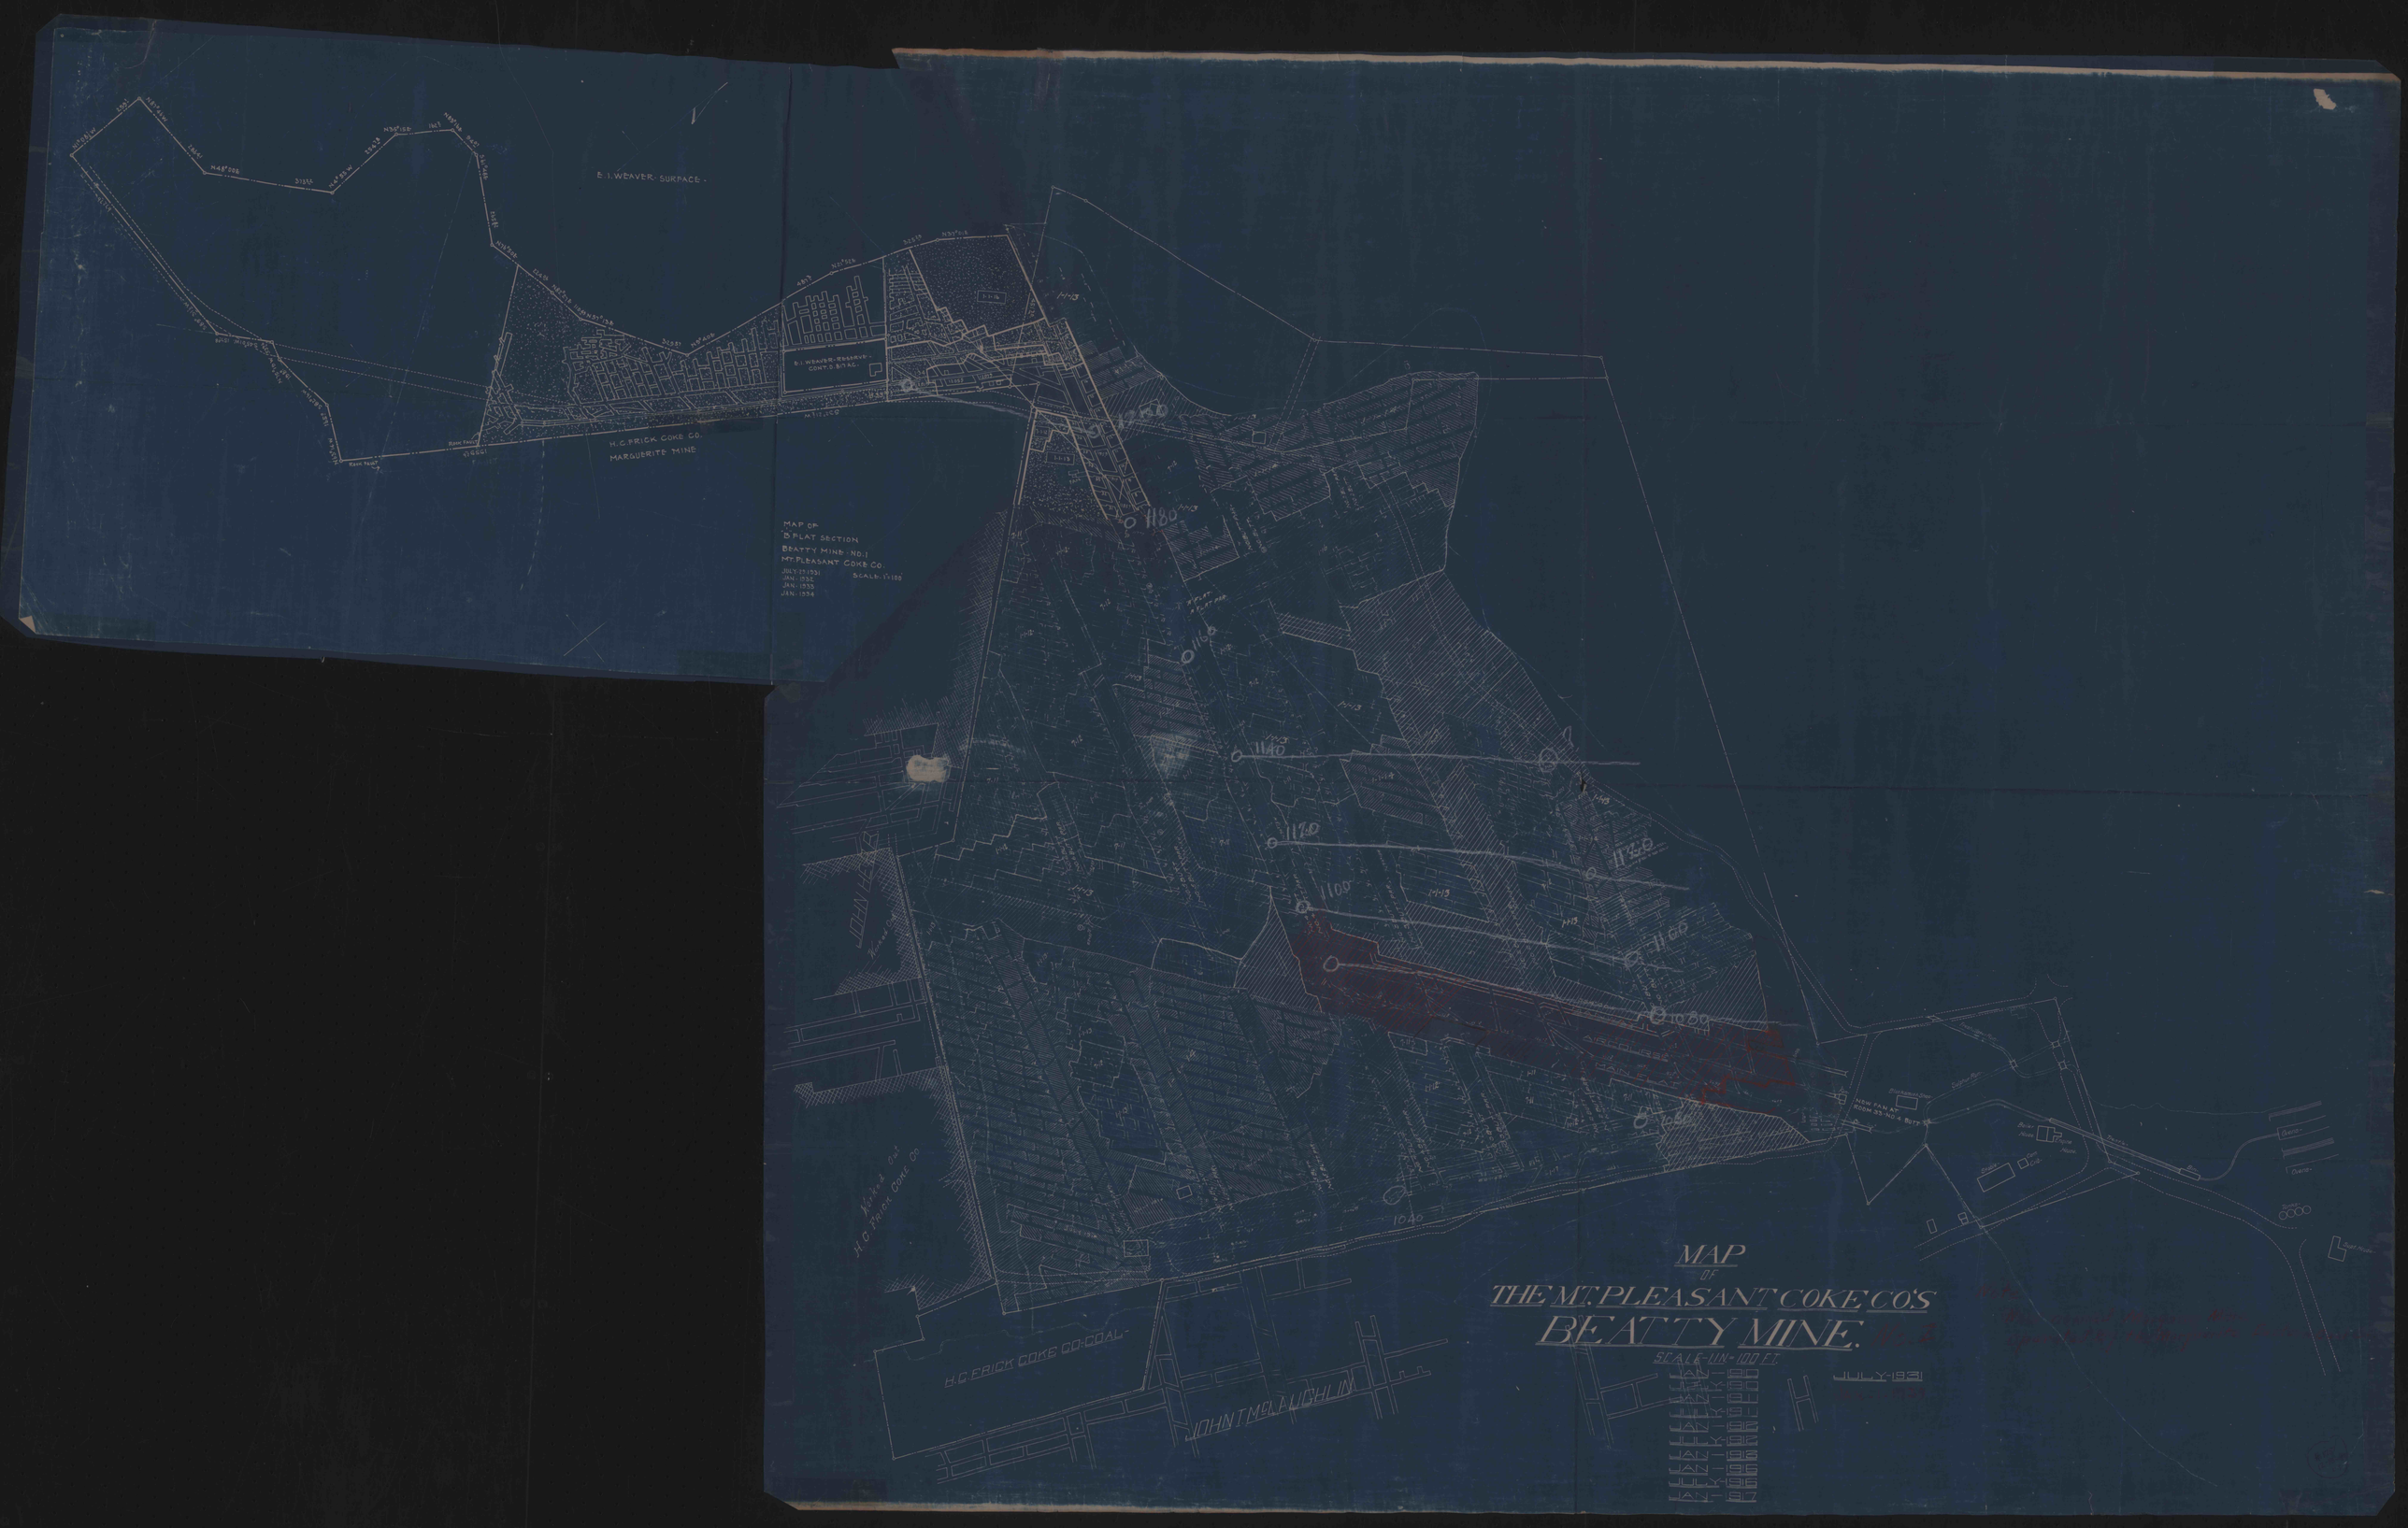
E. I. WEAVER - SURFACE -
E. I. WEAVER - RESERVE - CONT. O. 8.7 AC.
H. C. FRICK COKE CO.
MARGUERITE MINE
MAP OF
"B" FLAT SECTION
BEATTY MINE - NO. 1
MT. PLEASANT COKE CO.
JULY-29-1931
JAN.-1932
JAN.-1933
JAN.-1934
SCALE - 1" = 100'
1180
1160
1140
1120
1100
1080
1060
1040
H. C. FRICK COKE CO. COAL
JOHN T. McLAUGHLIN
MAP
OF
THE MT. PLEASANT COKE CO'S
BEATTY MINE.
SCALE - 1 IN. = 100 FT.
JAN - 1910
JULY - 1910
JAN - 1911
JULY - 1911
JAN - 1912
JULY - 1912
JAN - 1913
JAN - 1915
JULY - 1916
JAN - 1917
JULY - 1931