MAP OF
MASCOT No 1 MINE
OPERATED BY
W. O. GULBRANSON
in Woodward Twp., Clearfield Co., Penna

Scale 1"=100'

H. S. Shillingford,
Mining Engineer.
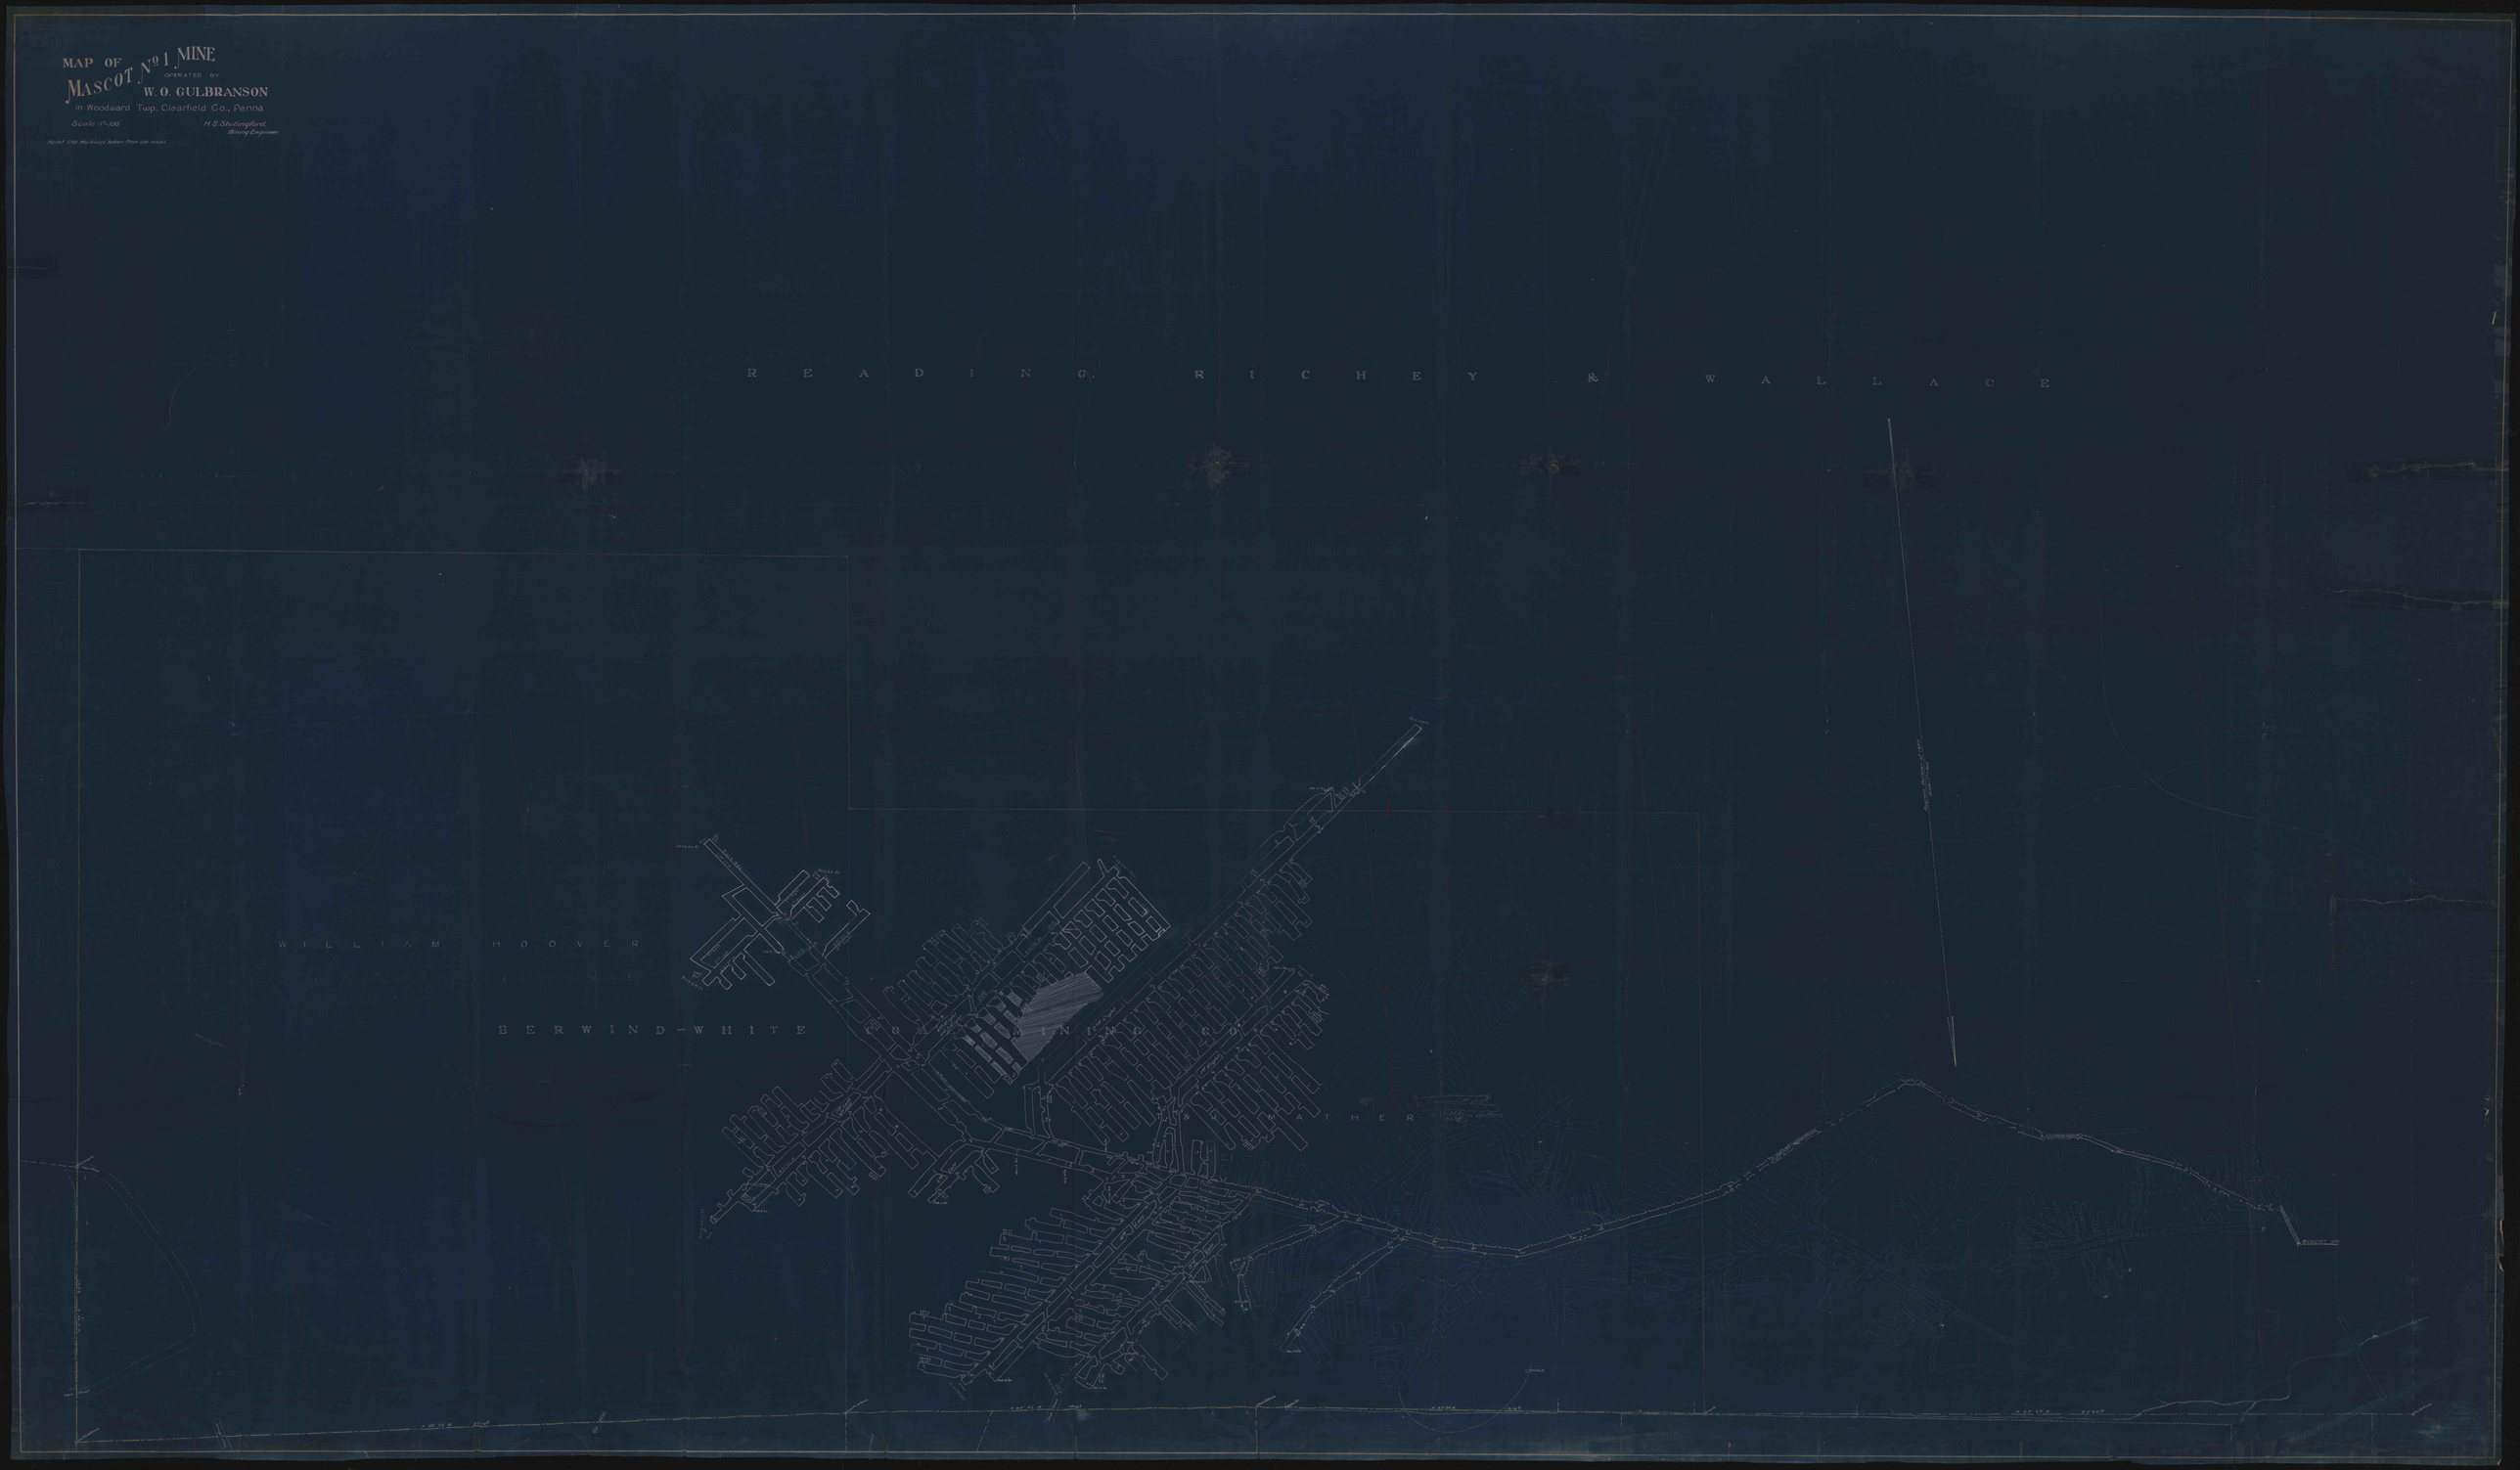
Hachel Old Workings taken from old maps.