


12000 N

12000 N


11000 N

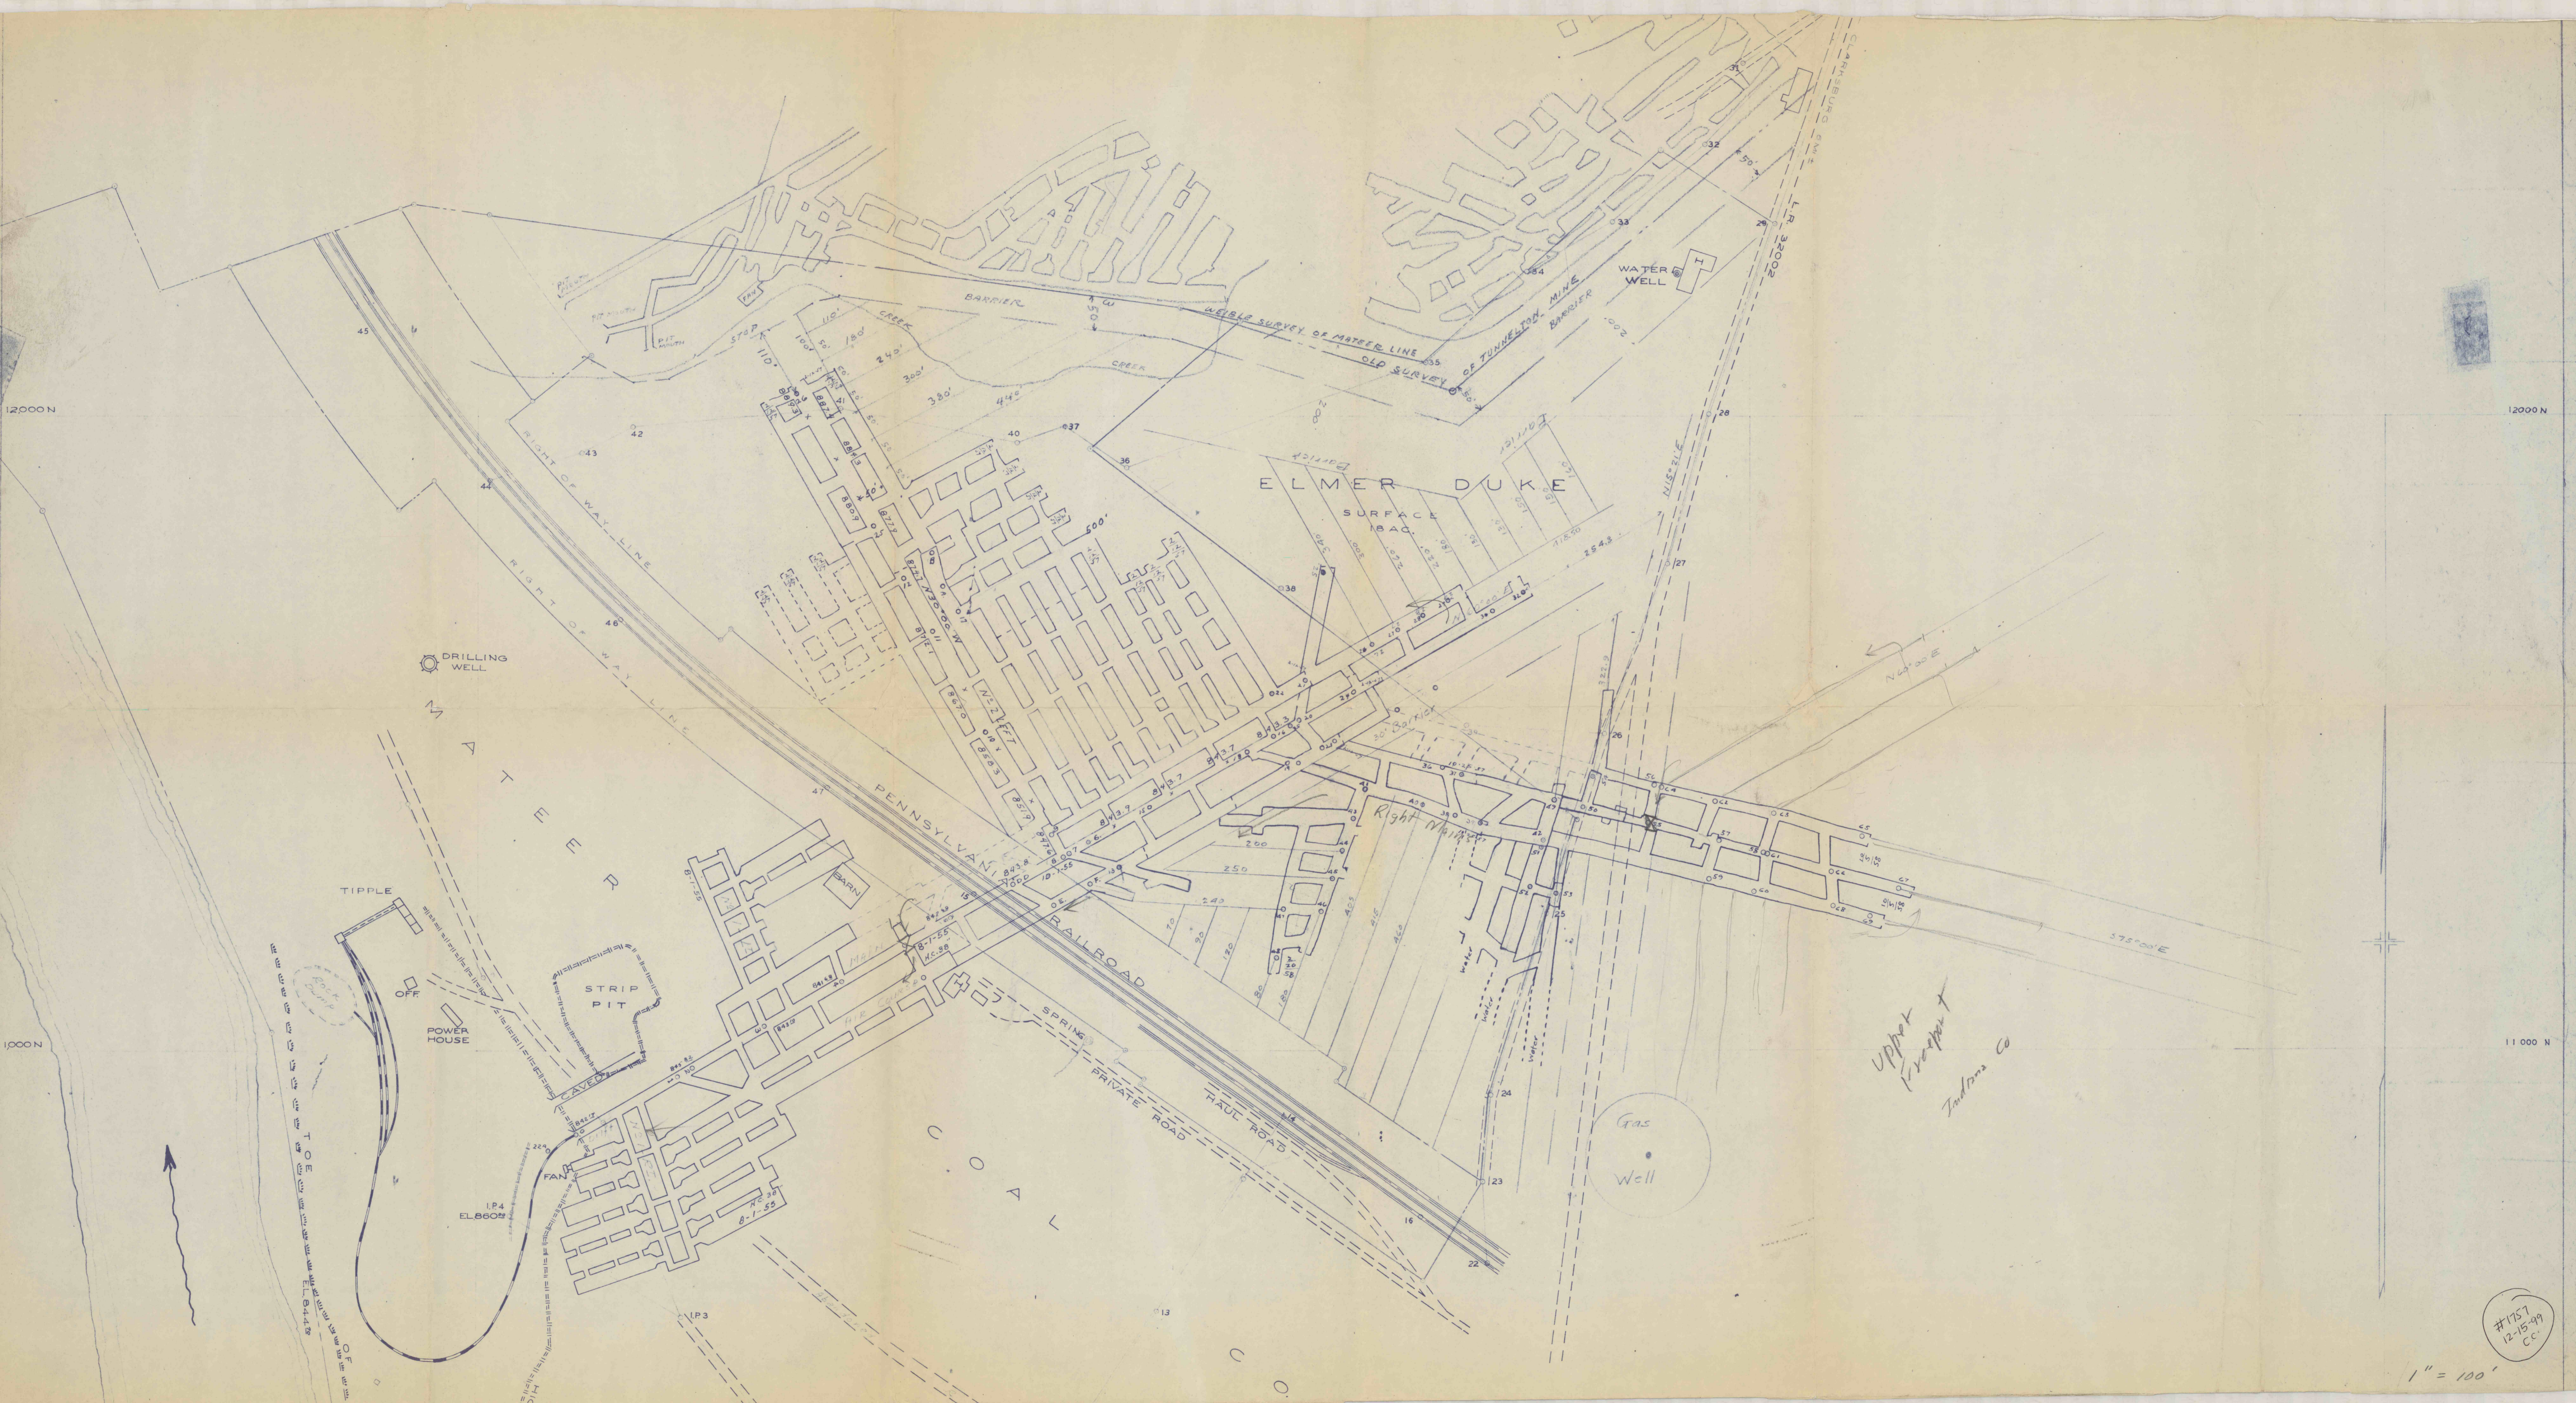

*Upper  
Indiana Co*

#1757  
12-15-99  
C.C.

1" = 100'