


D-2

D2

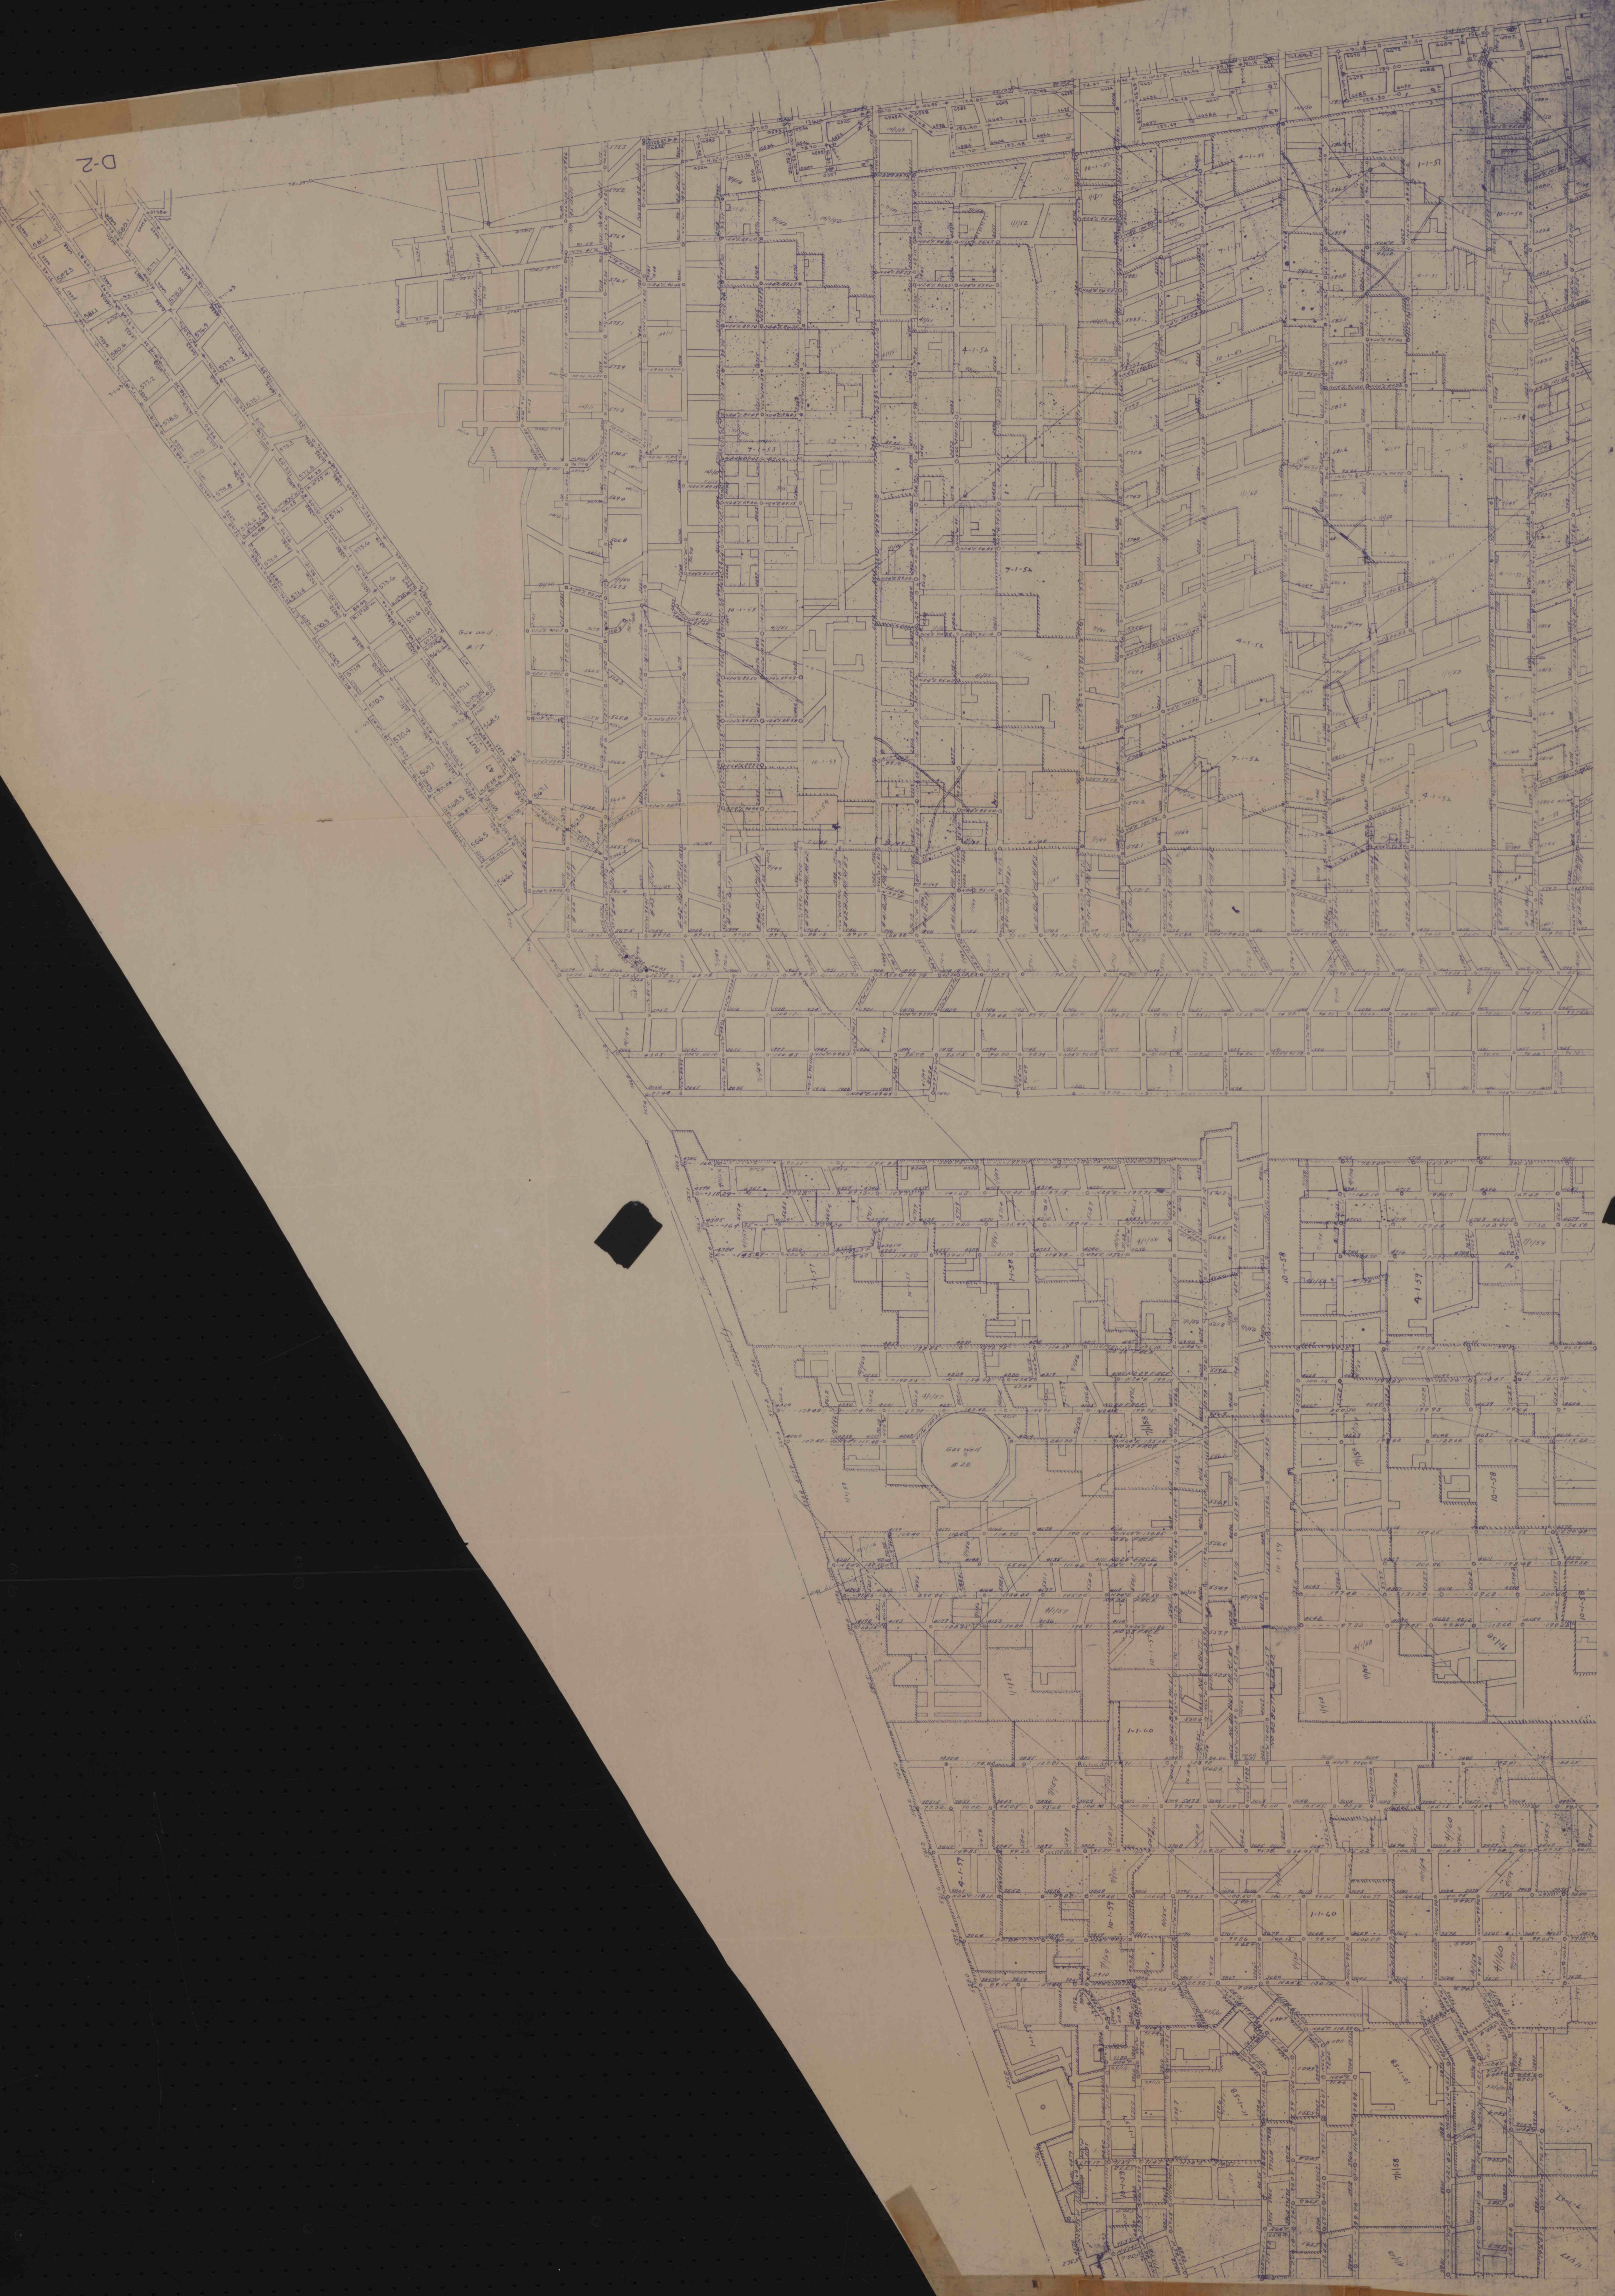

D2