


3-C

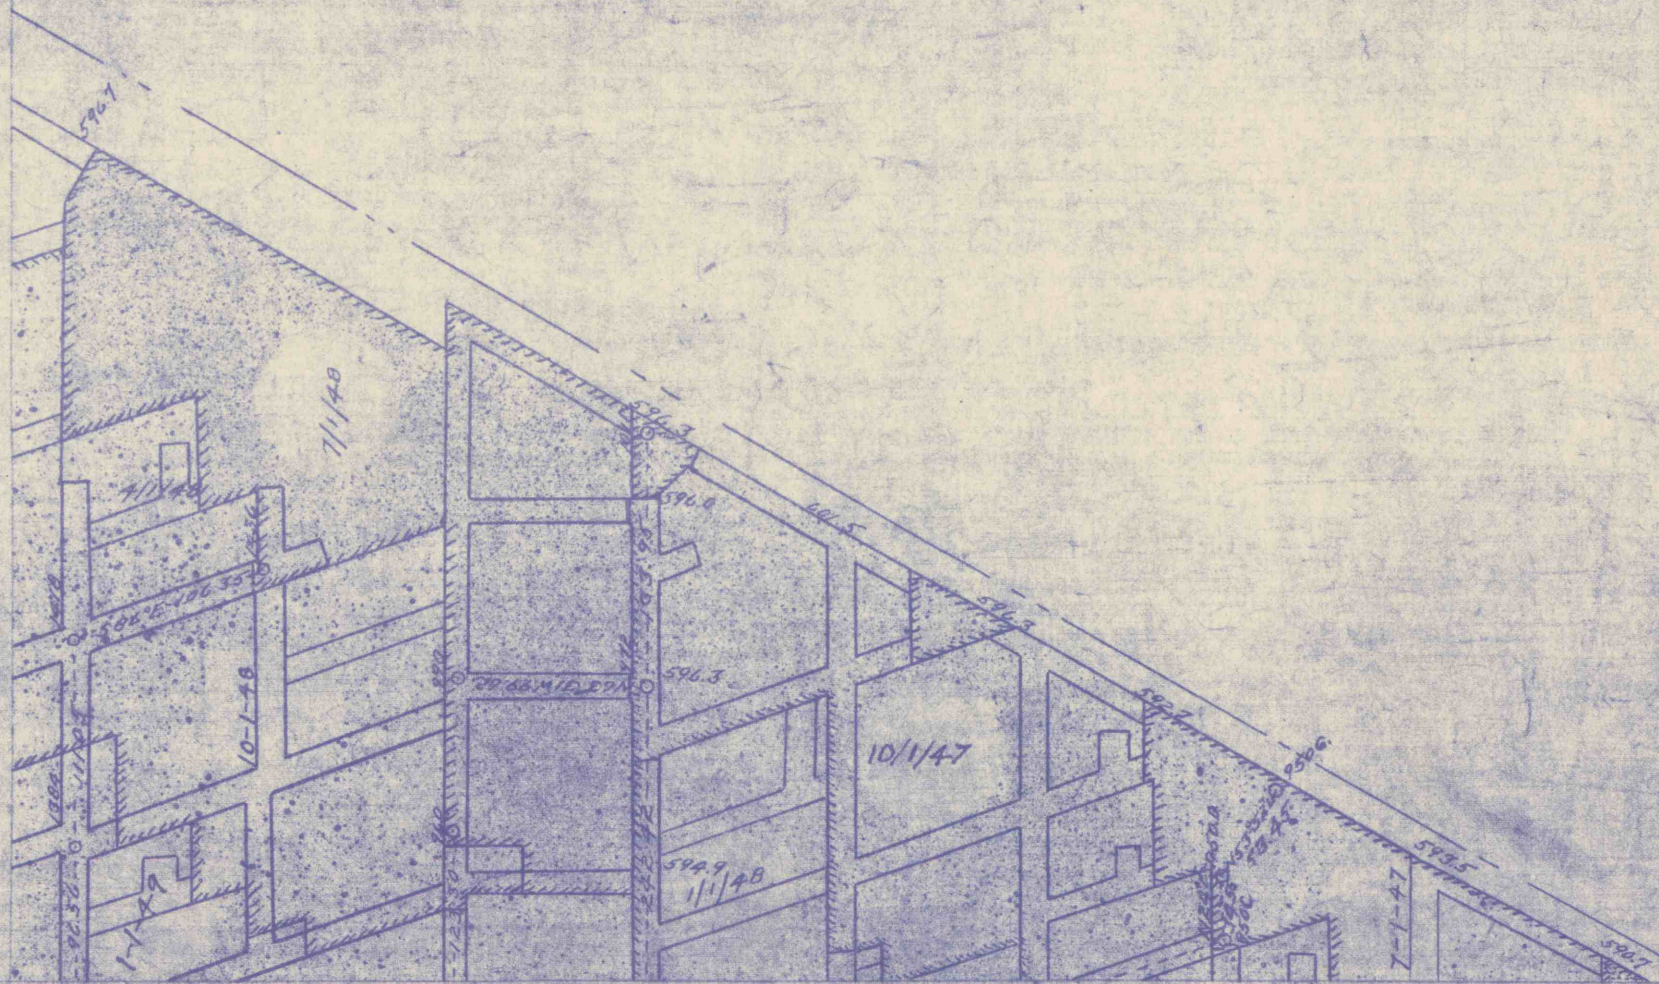

3-C

NO. 11

3-C