10 B

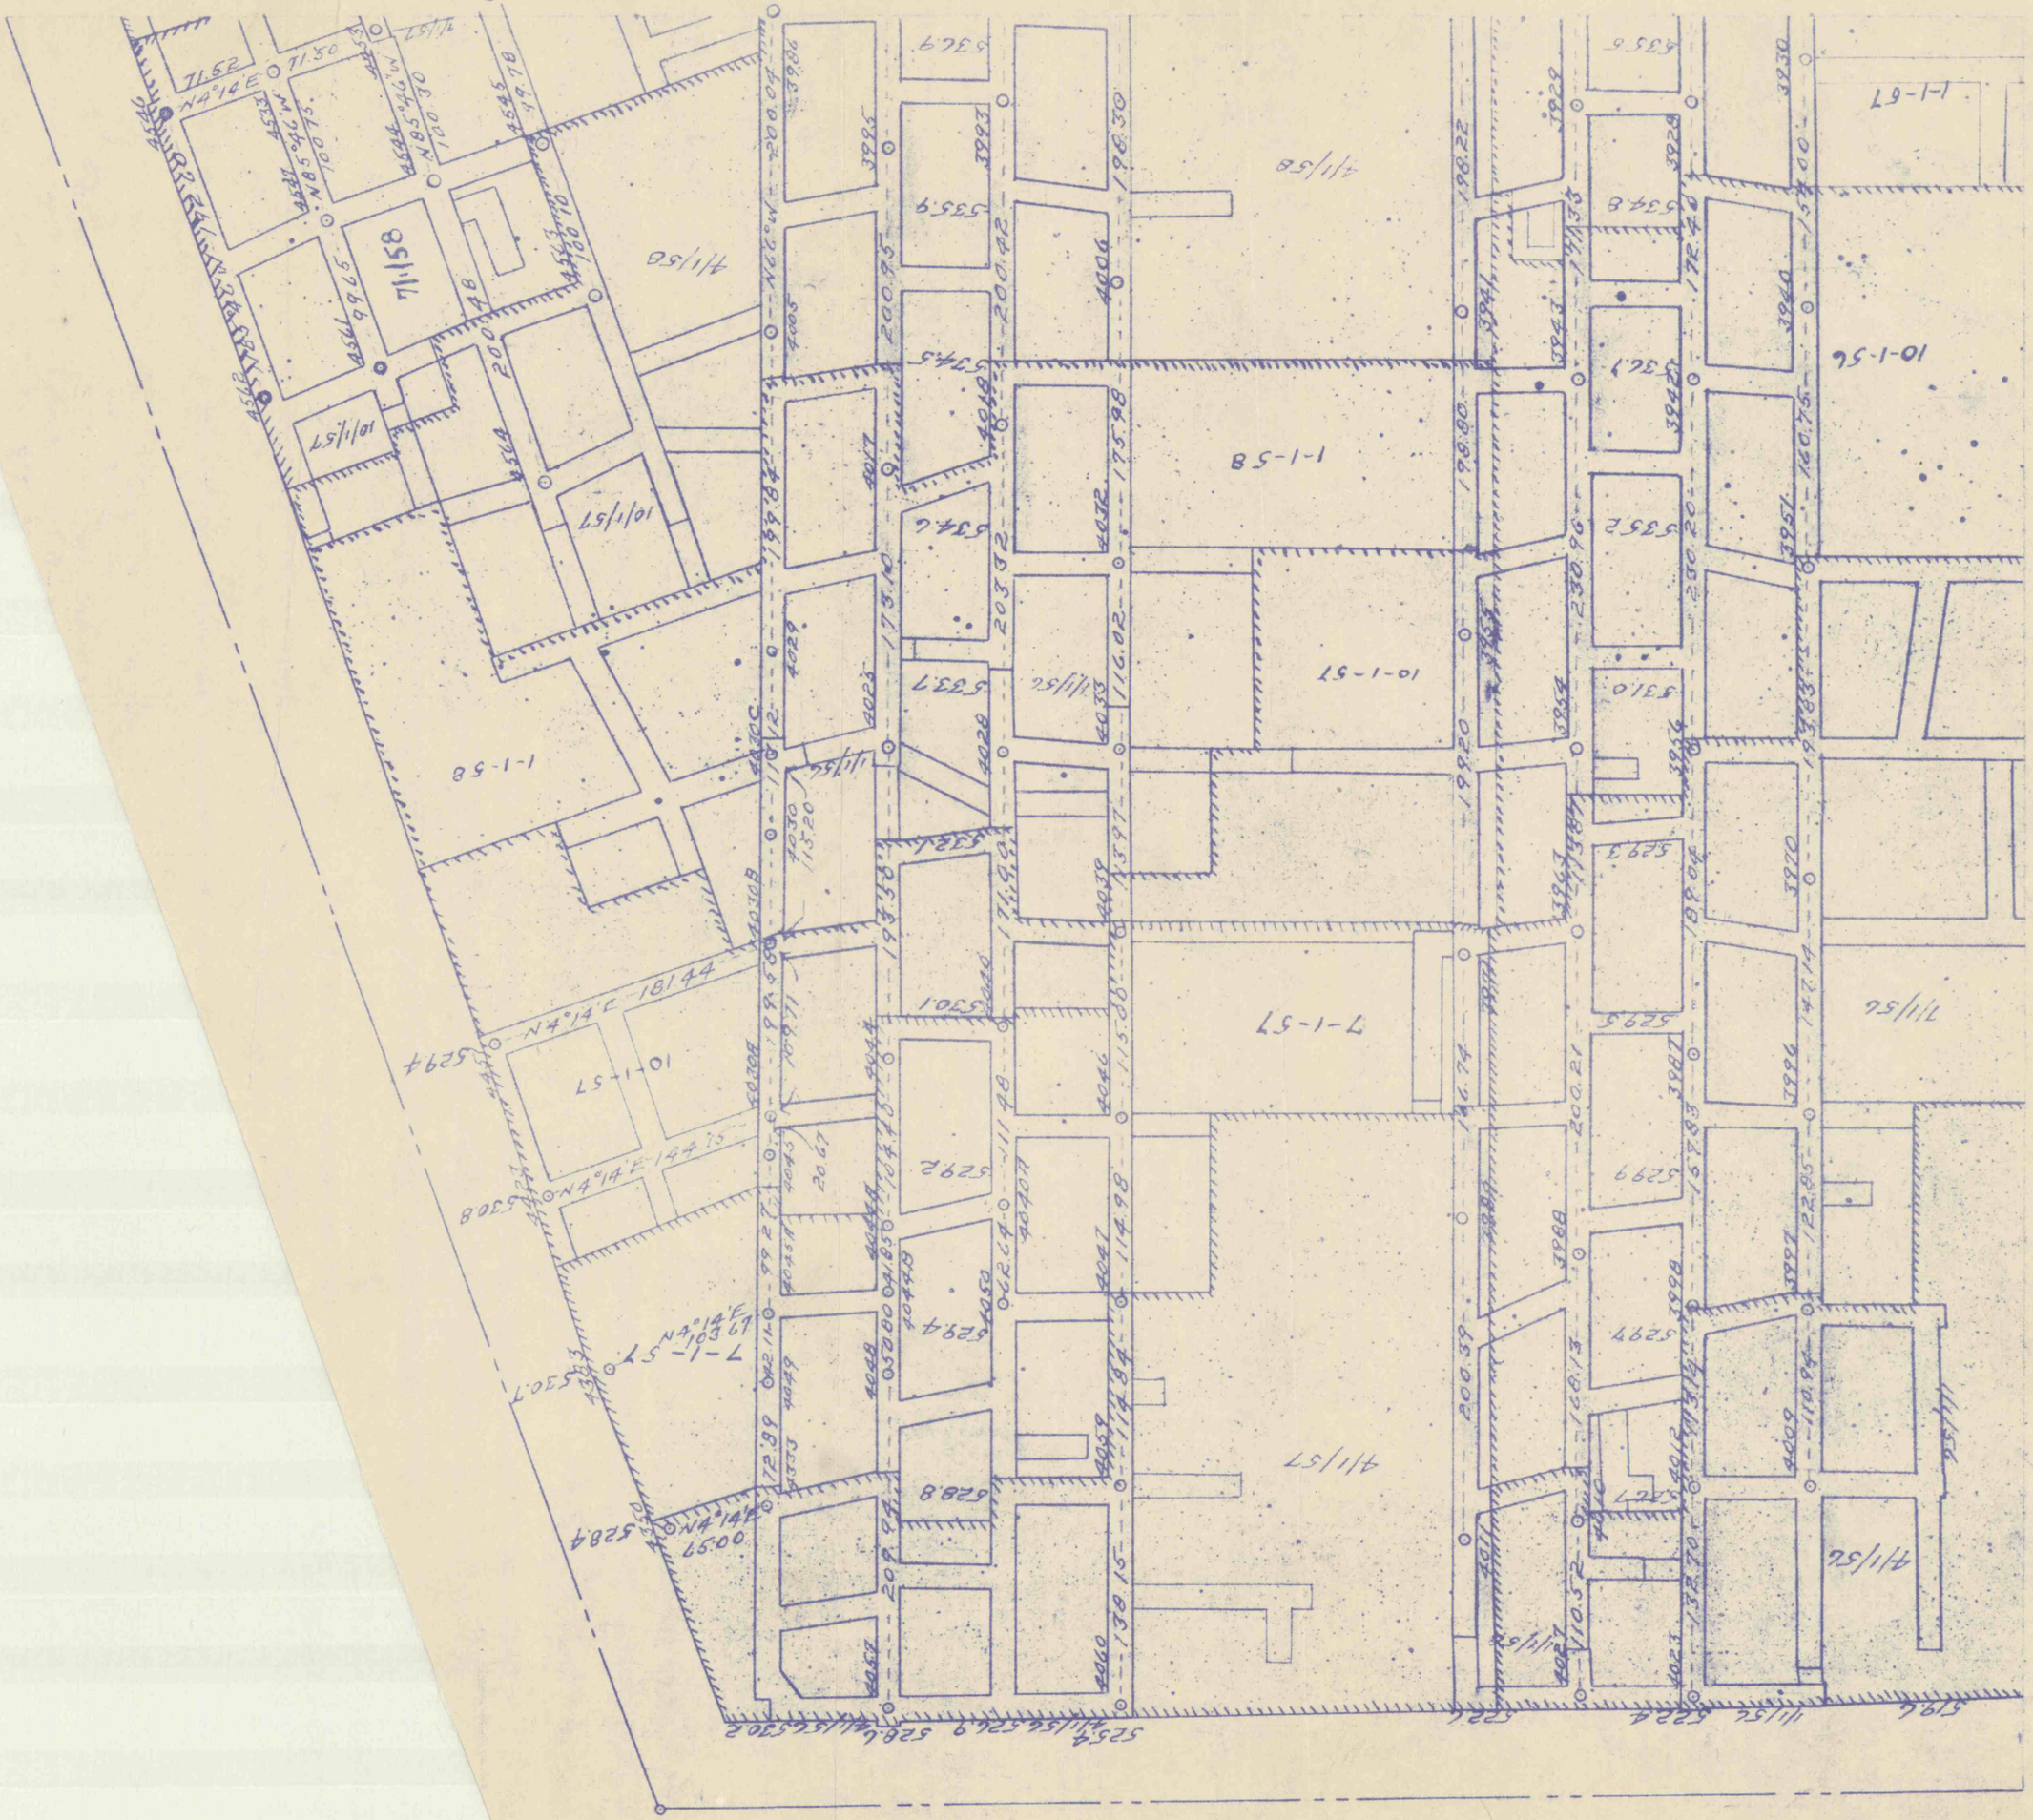
7-1-58
10-1-57
1-1-58
7-1-57
4-1-57
1-1-67
10-1-56
4-1-56
7-1-56
N4°14'E 71.52
N85°46'W 71.50
N4°14'E 181.44
N4°14'E 144.15
N4°14'E 103.67
N4°14'E 68.27
N4°14'E 00.59
N85°46'W 100.75
N85°46'W 120.00
N4°14'E 200.78
N4°14'E 200.78
N4°14'E 200.42
N4°14'E 198.30
N4°14'E 198.22
N4°14'E 198.00
N4°14'E 197.90
