


D-3

D3

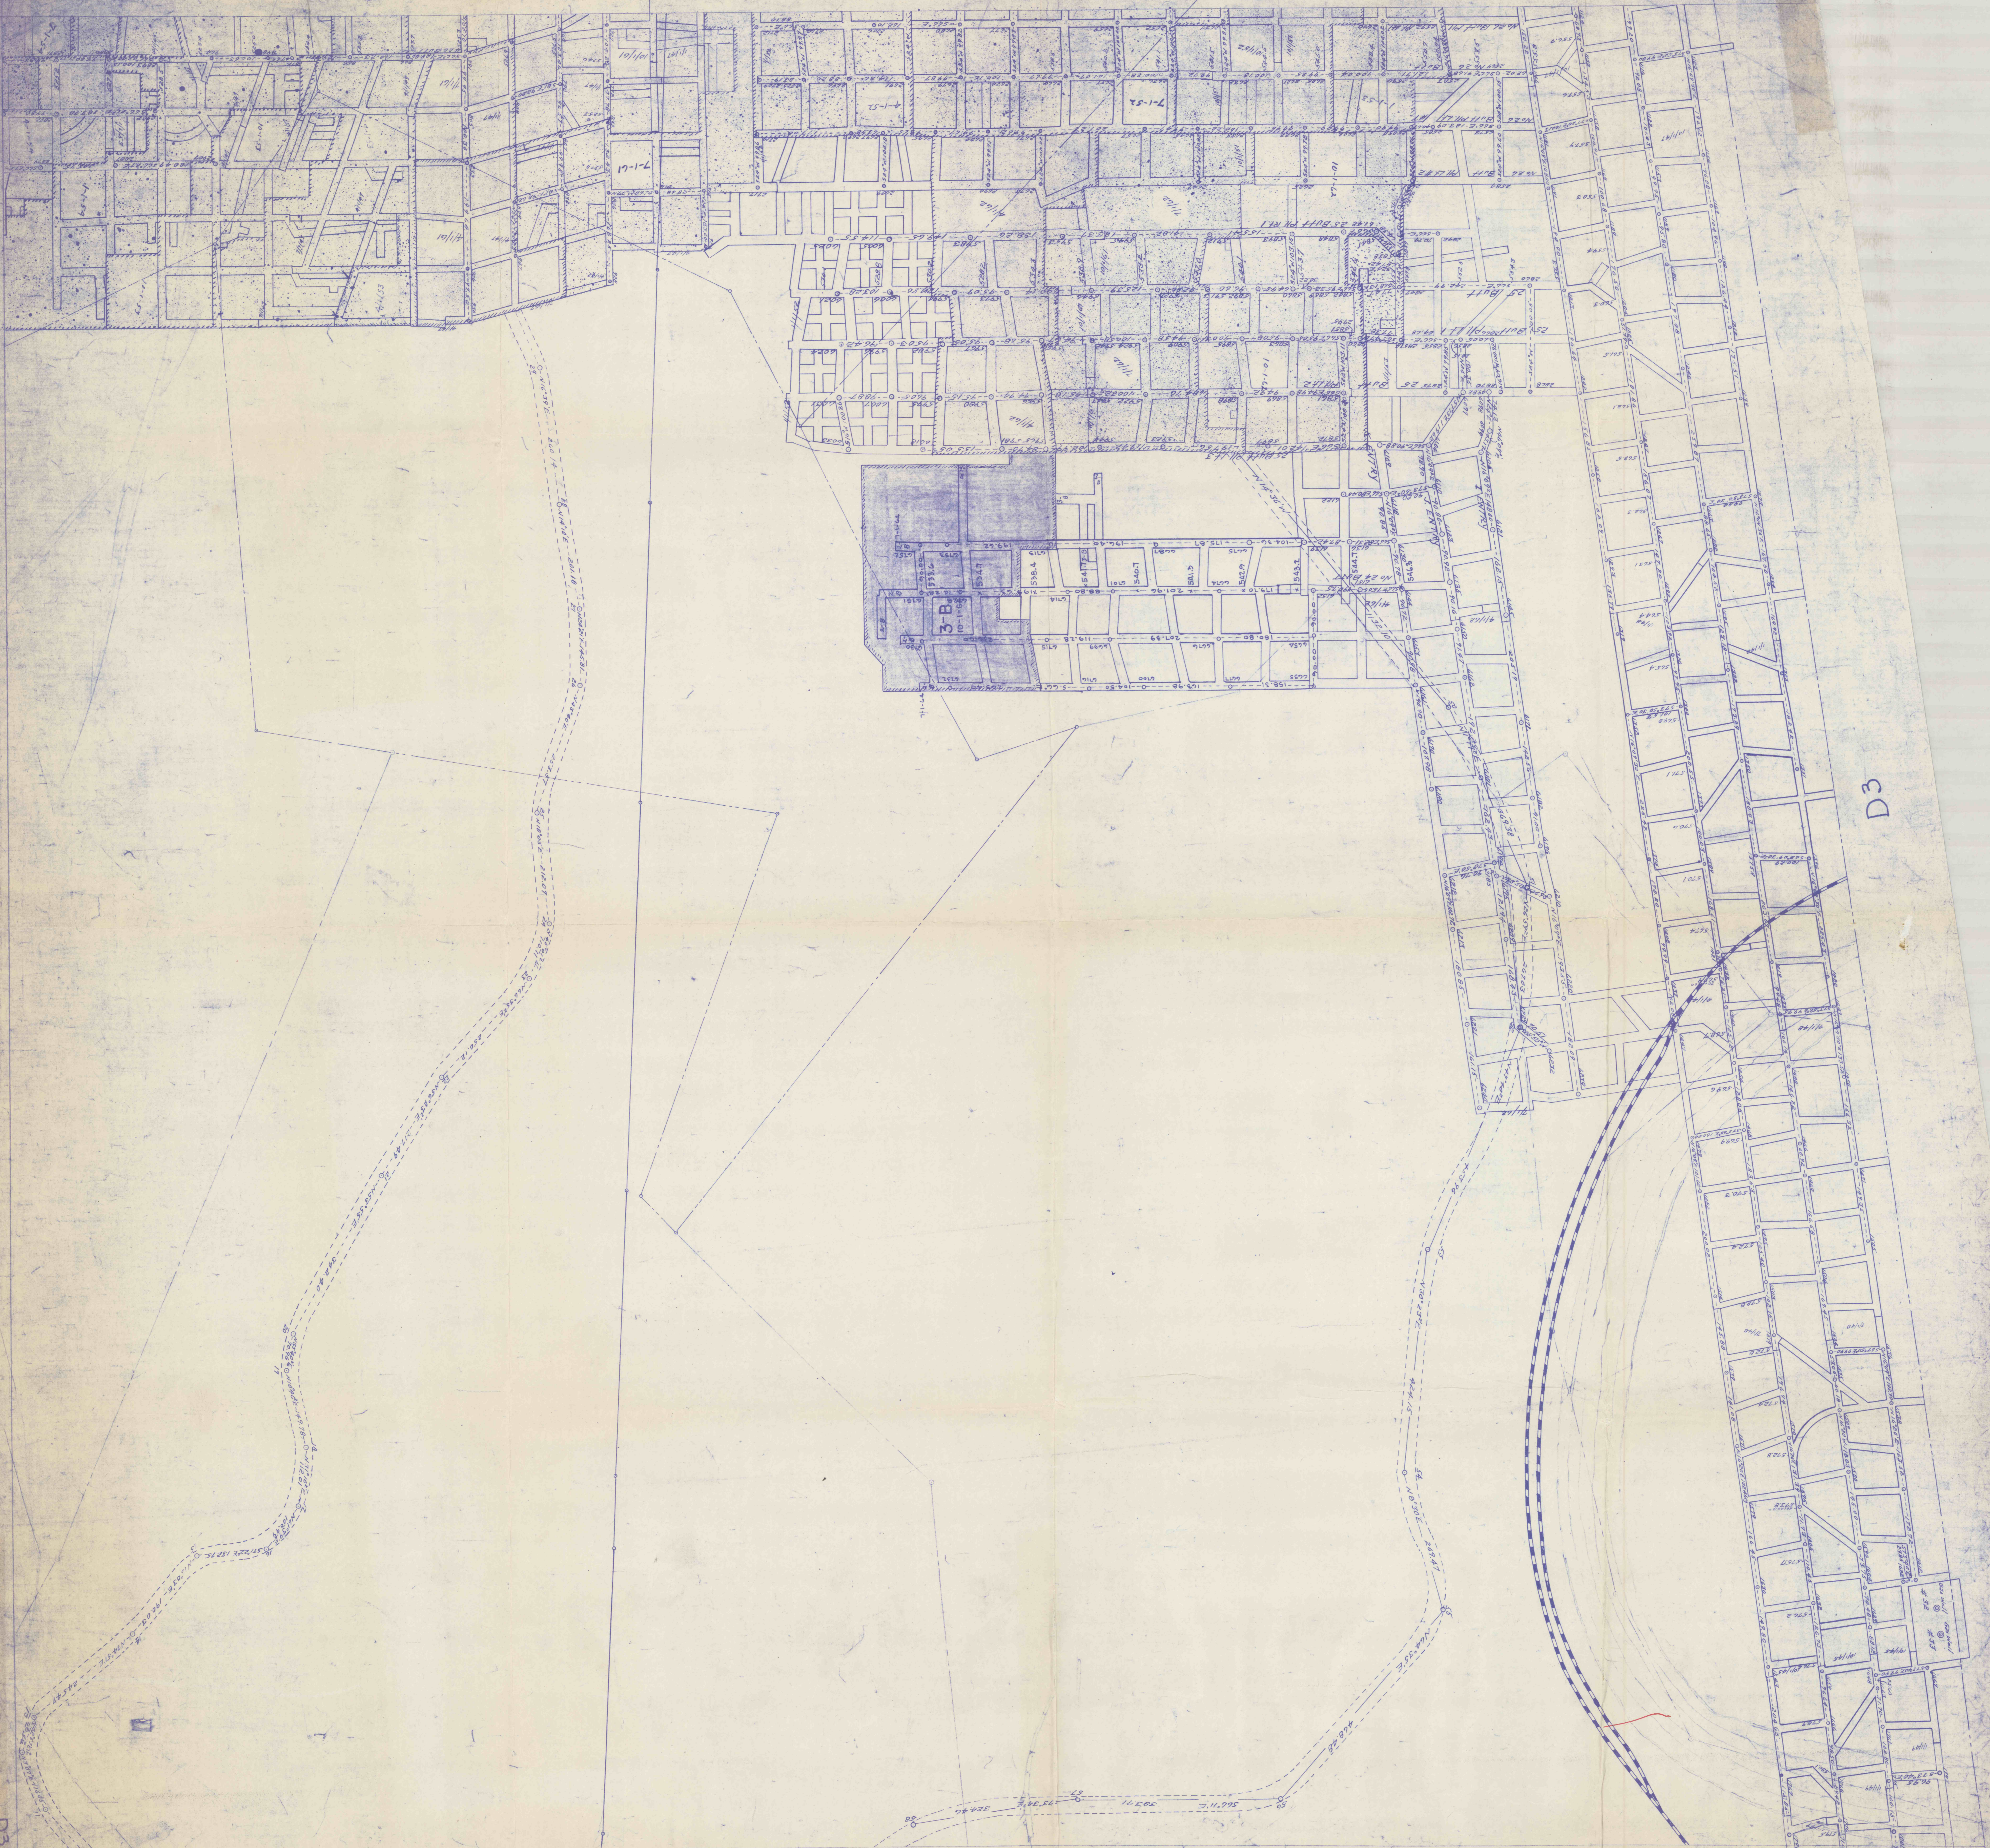

D3

D-3

D3