


3-A

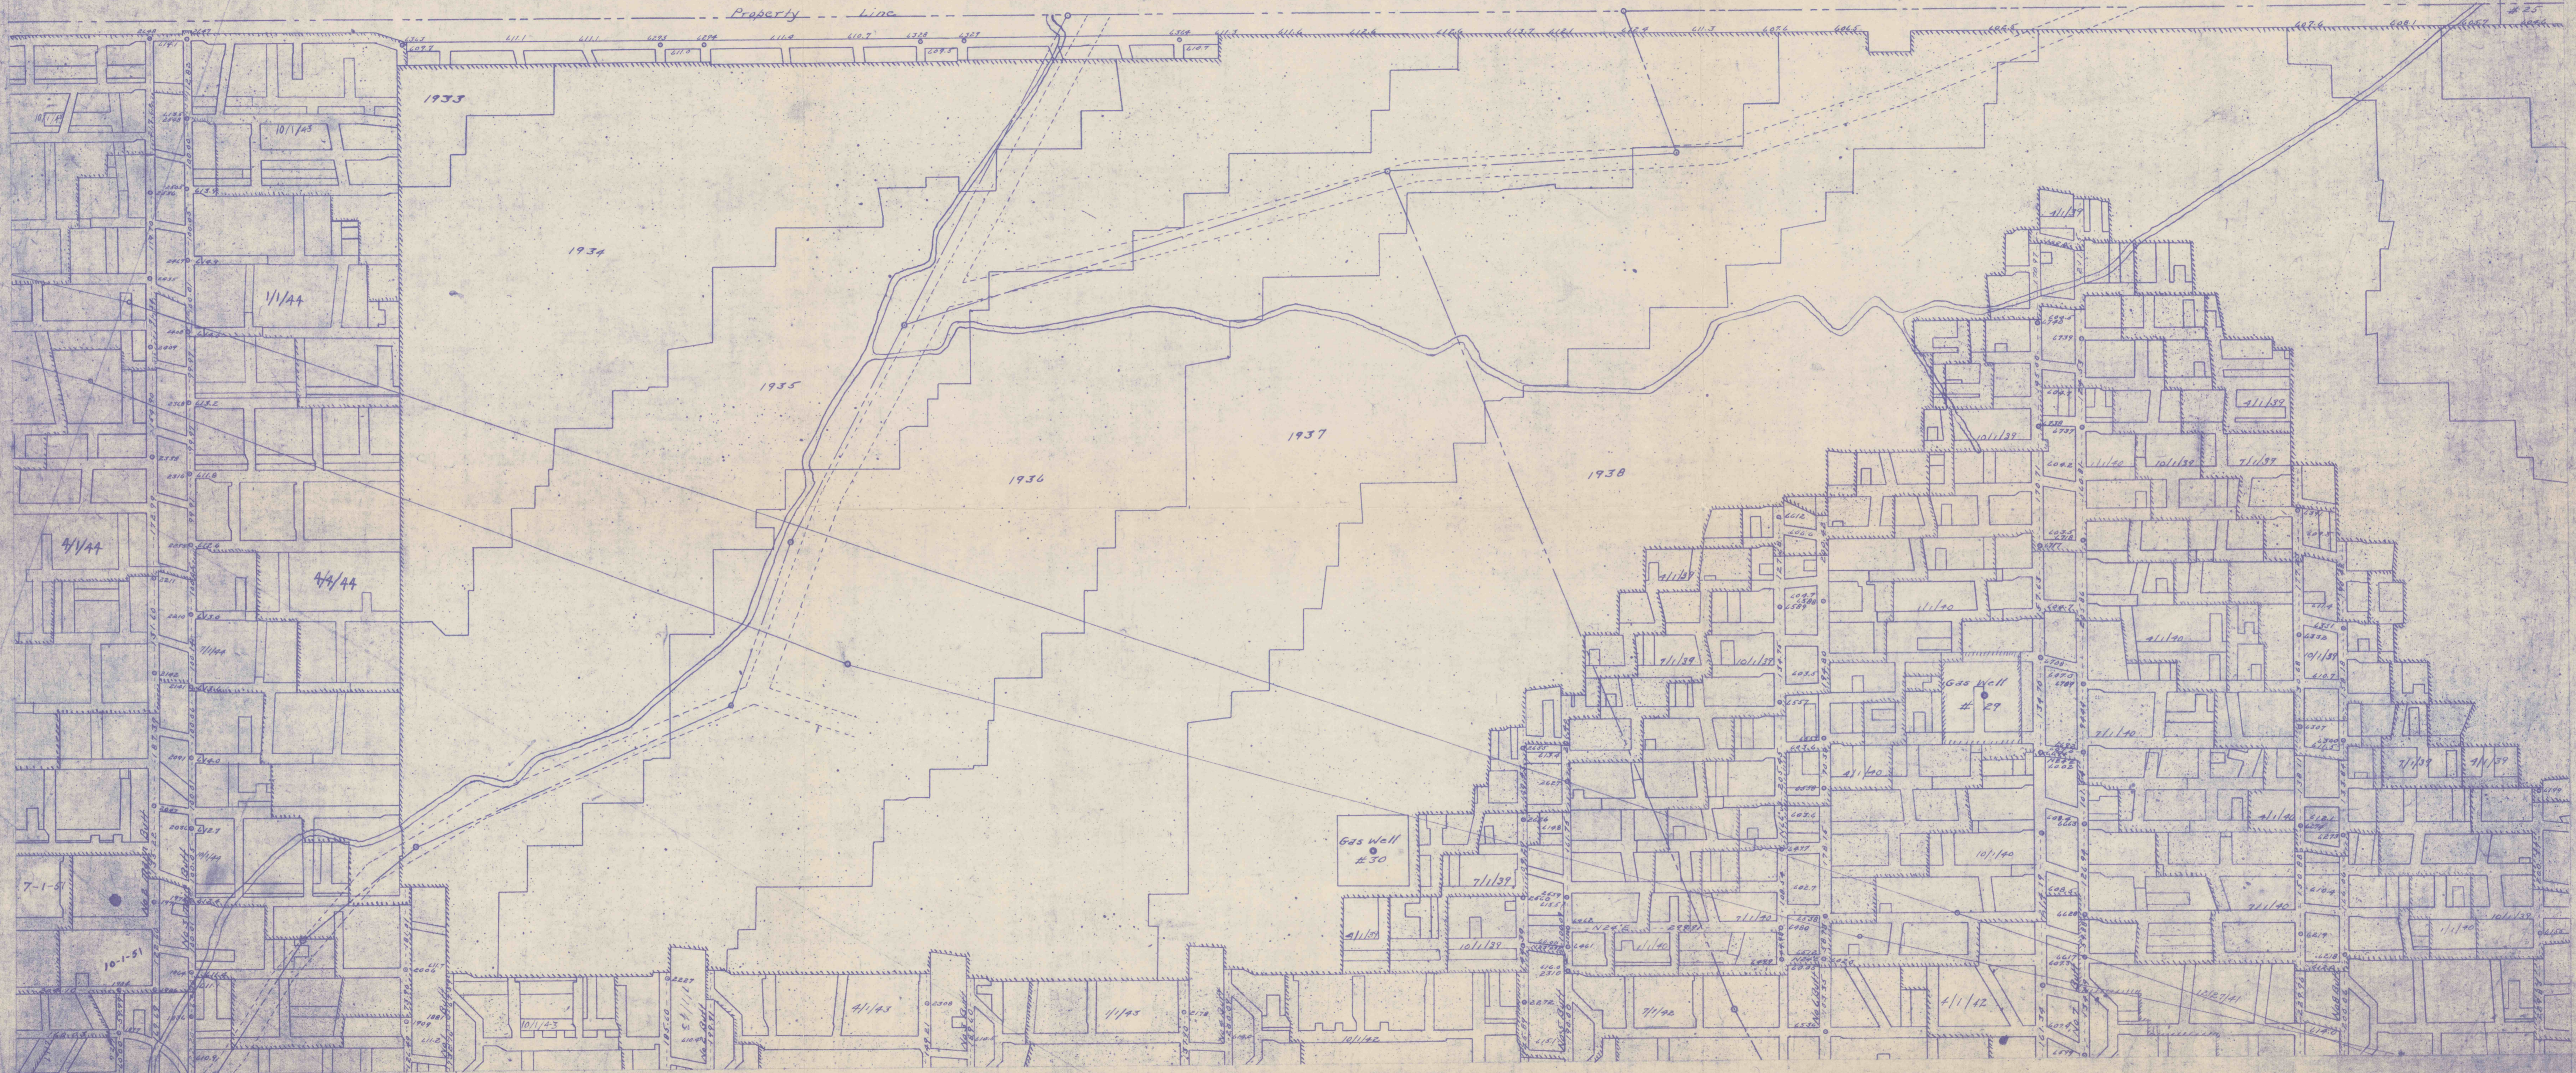

3-A