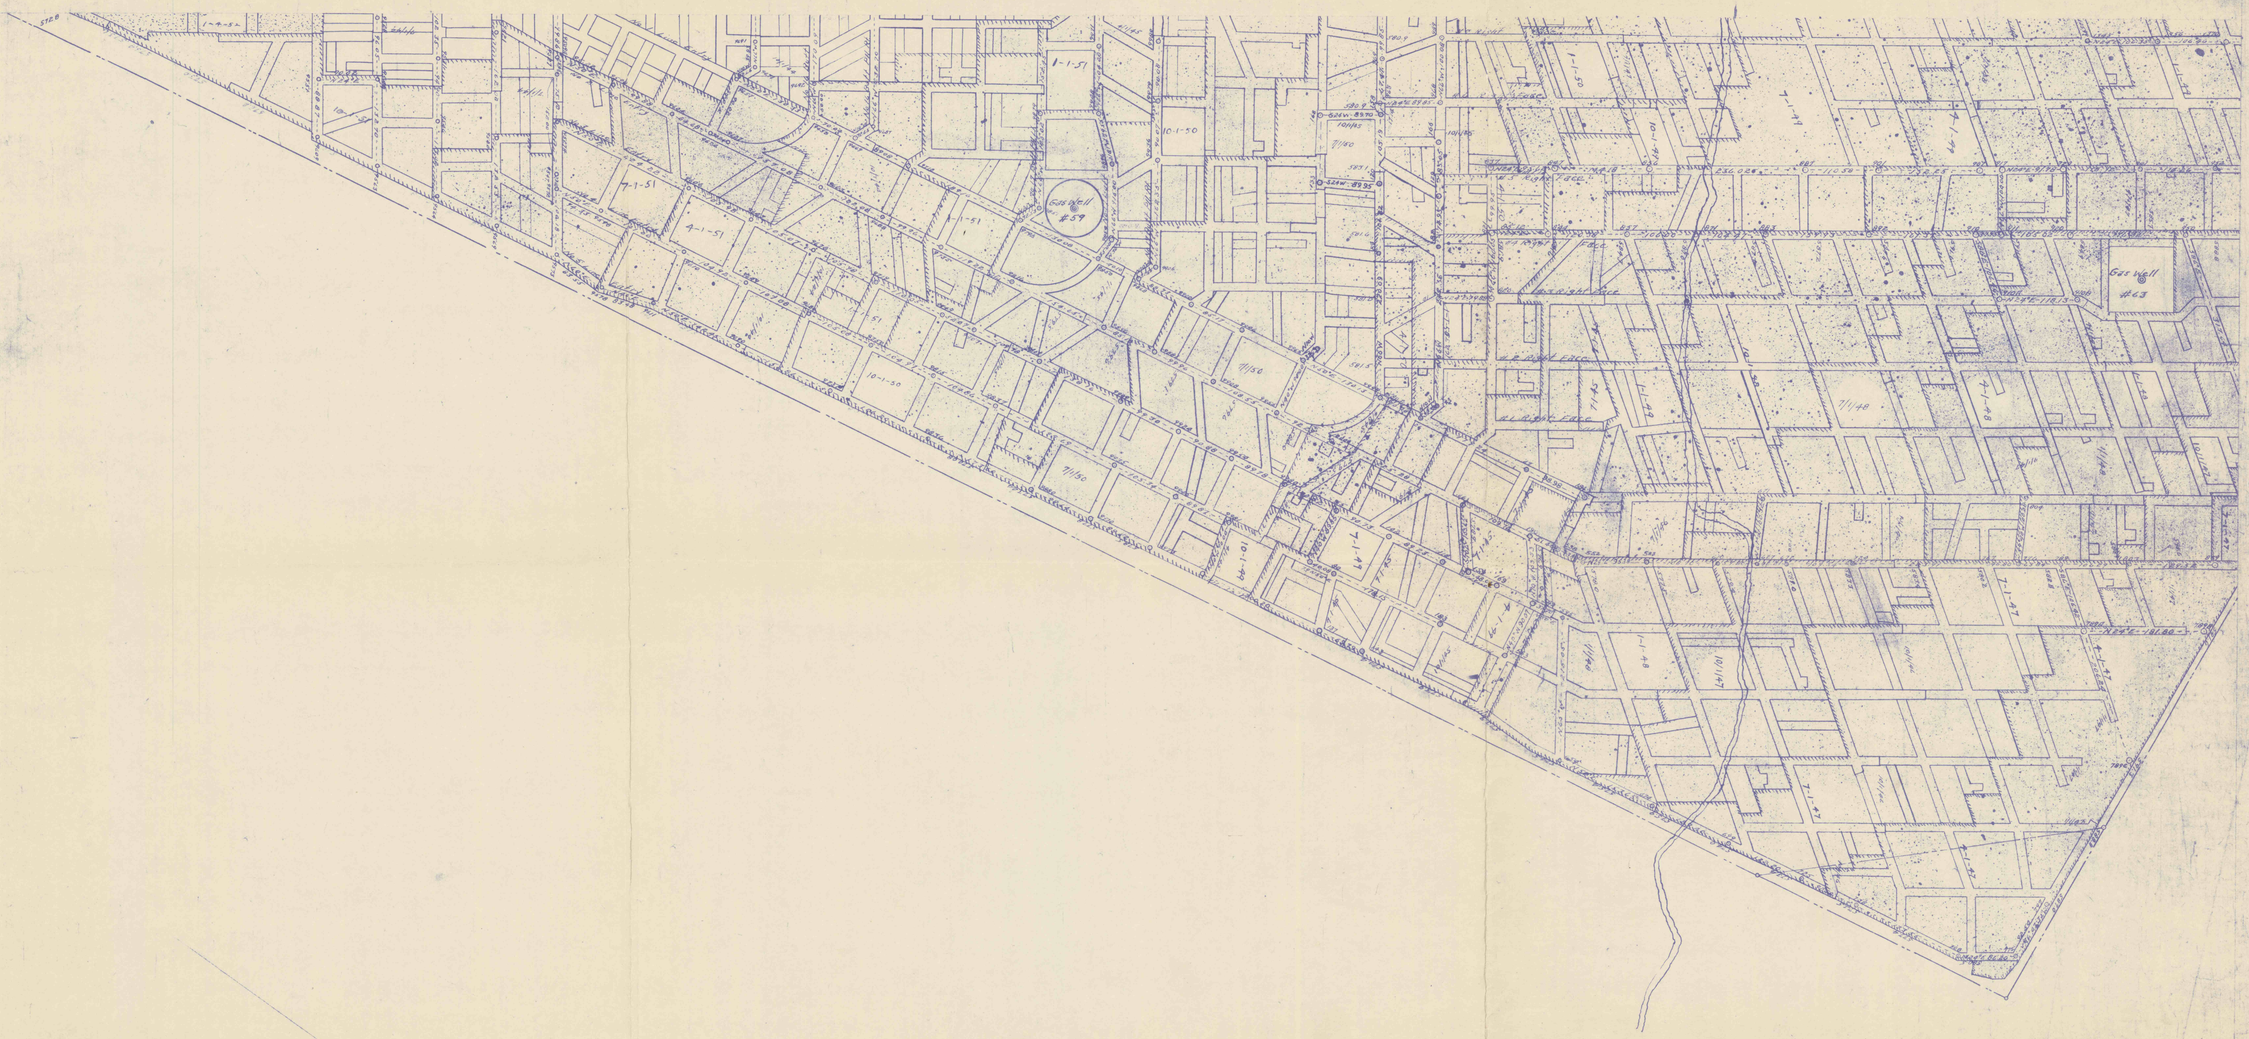
Gas Well #59
Gas Well #63
1-1-51
10-1-50
4-1-51
7-1-44
7-1-48
7-1-47
7-1-46
7-1-45
7-1-43
7-1-42
7/150
7/146
7/148
7/149
10/147
10/148
11/148
11/149


